


LAT. II, DIST. T, S. S. 20

W. B. CARTER

MAY 1, 1954

BK. NO. C23-57

PROJ. NO. C23-57

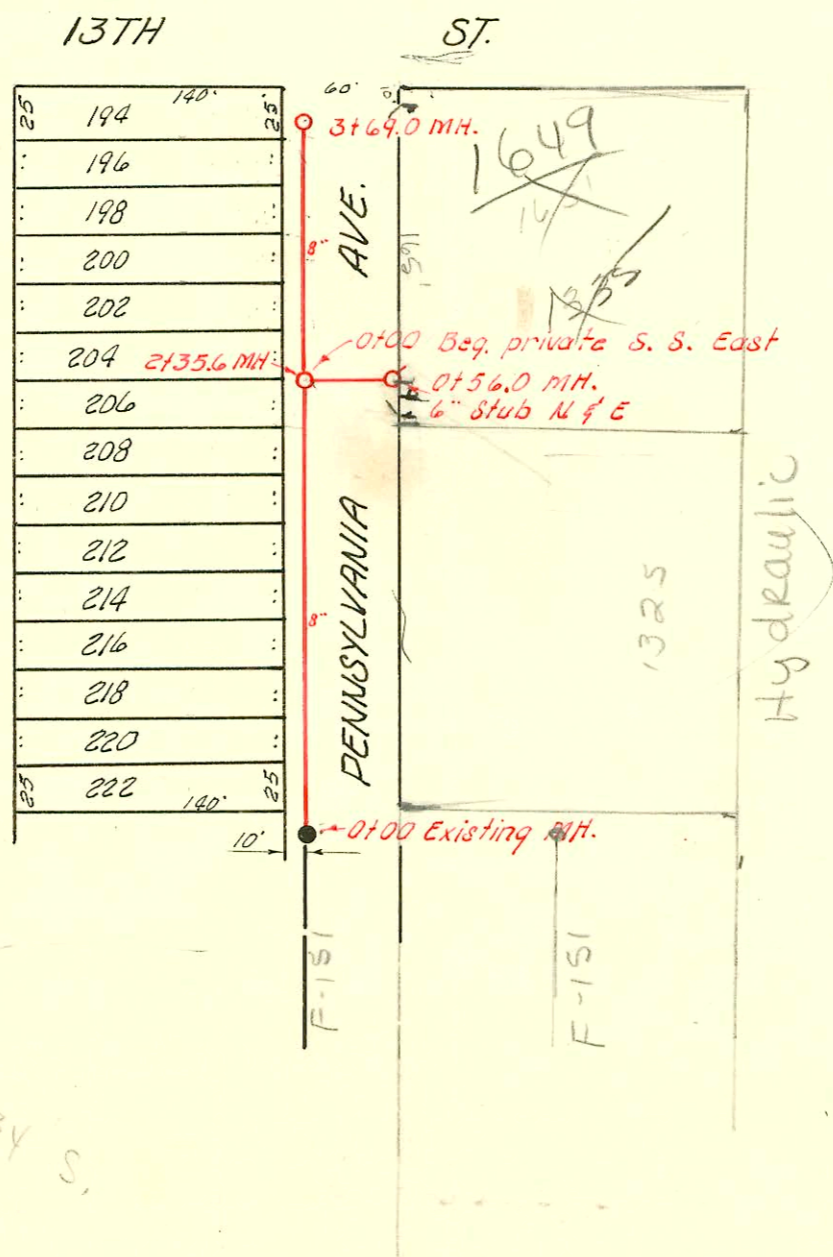

W. B. CARTER

MAY 4, 1954

BK. NO. K-17,

PROJ. NO. C24-13

