


**LAT. 15, DIST. T. , S.S. 20**  
 UTILITY CONTRACTORS, INC., FEB. 1, 1955  
 BK. NO. K-25 , PROJ. NO. C24-57

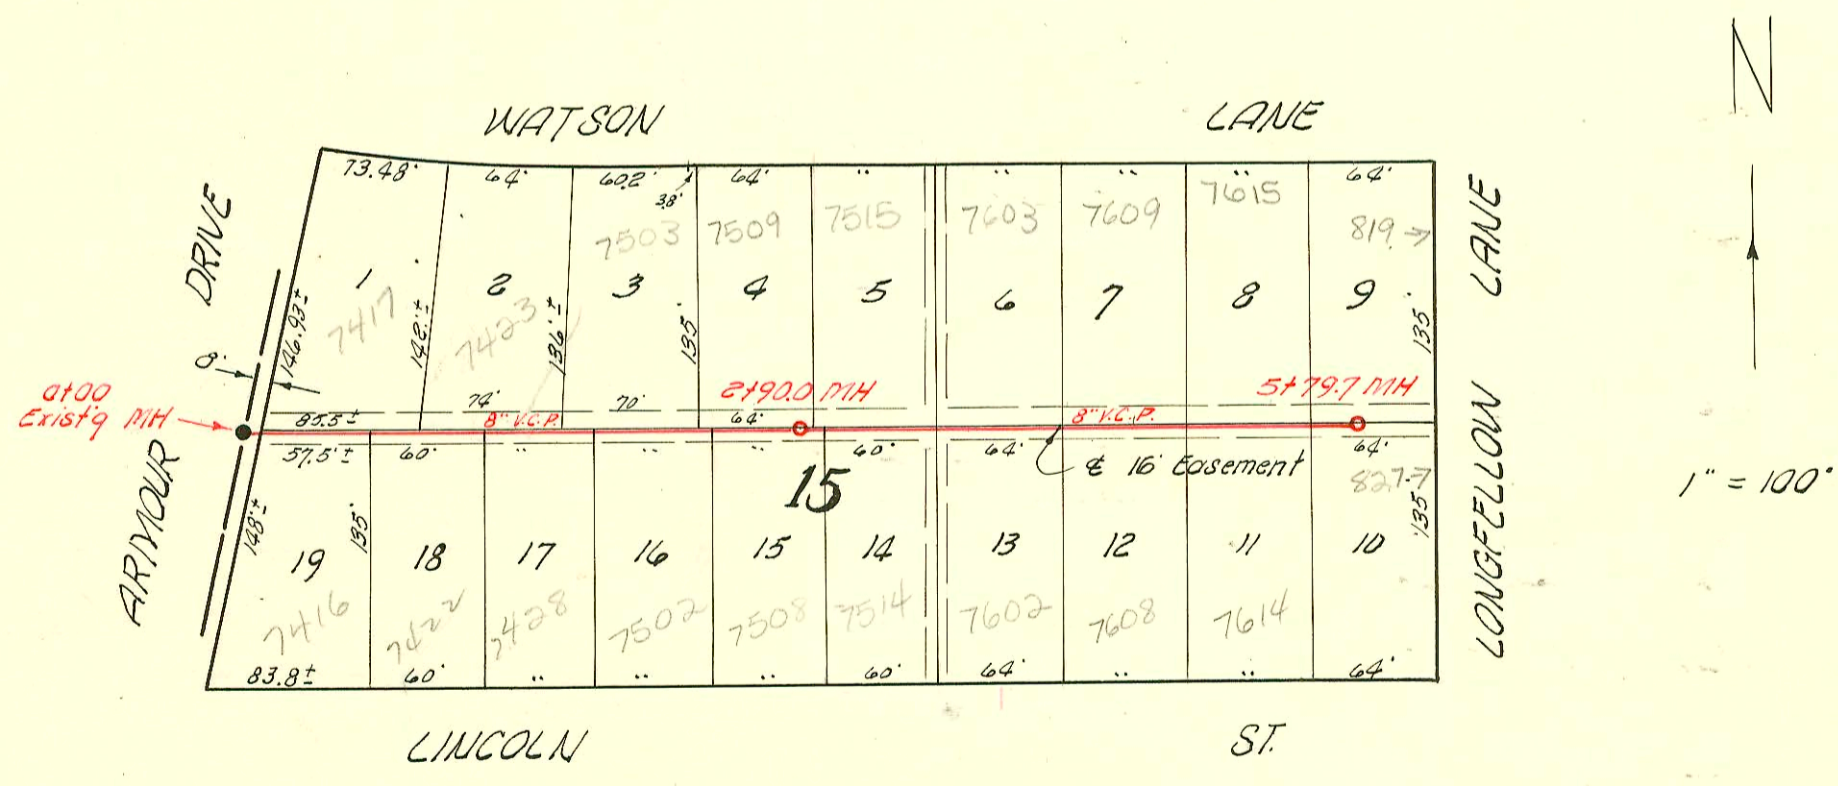

2000-01895- 7509 E Watson - Al Henning - 8/25/50 - 4" SCH 40, Repl 20' in middle of Bid Sewer  
 2001-00464 - 3/5/61 - 7417 E Watson - A Good Plbr - 4" SCH 40, Repair on msmt, 11/22, Fernco to clay 1' from main, tied into exist oc

**LAT. 6, SUB. 7, W.I.S**  
 BUILDERS CONST. INC., FEB. 2, 1955  
 BK. NO. K-23 , PROJ. NO. C24-69

