


NOTE:
 Line from 0+00 to 0+41.9 is a City Sewer built by Private Contract. Line 0+41.9 to 1+58.0 is a private Sewer. Don't issue any permit on private line

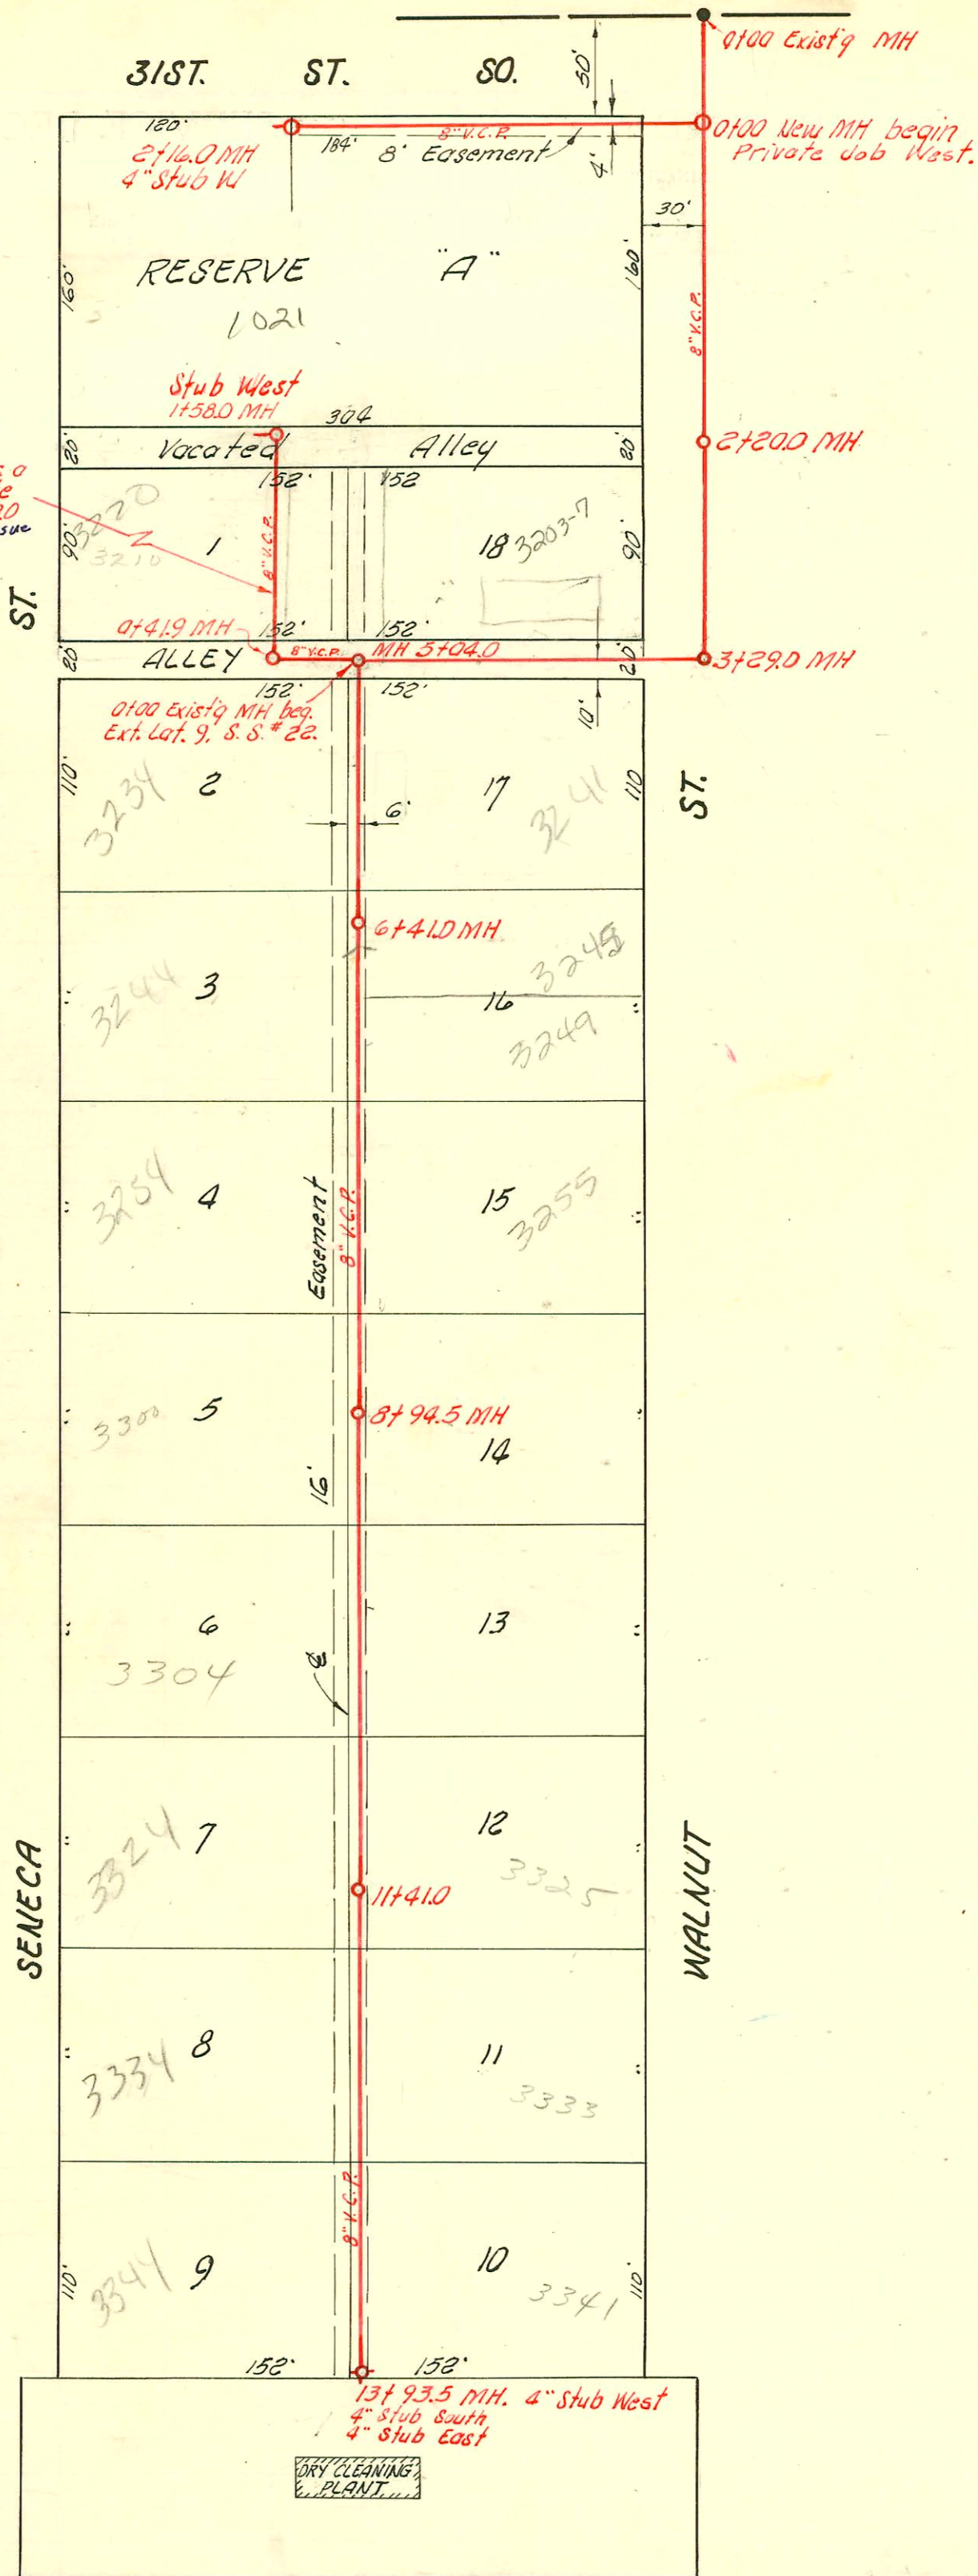

43-286317 S10 07
 tap #9196-3203-05 6" stub 3/4 in MH
 #13715-3221 S Walnut - Fredrick P. Bq. 1-28-59 NE side 0+00
 S Walnut - Ted Jones 1-24-64 - tap (4+82)

LAT. 9, S. S. NO. 22

UTILITY CONT. INC., FEB. 24, 1955
 BK. JF 67, PROJ. NO. C24-84

