


Also Refer To Book I-54

200 Scale


FORREST HILLS AREA

VAC. CENTRAL PARKWAY

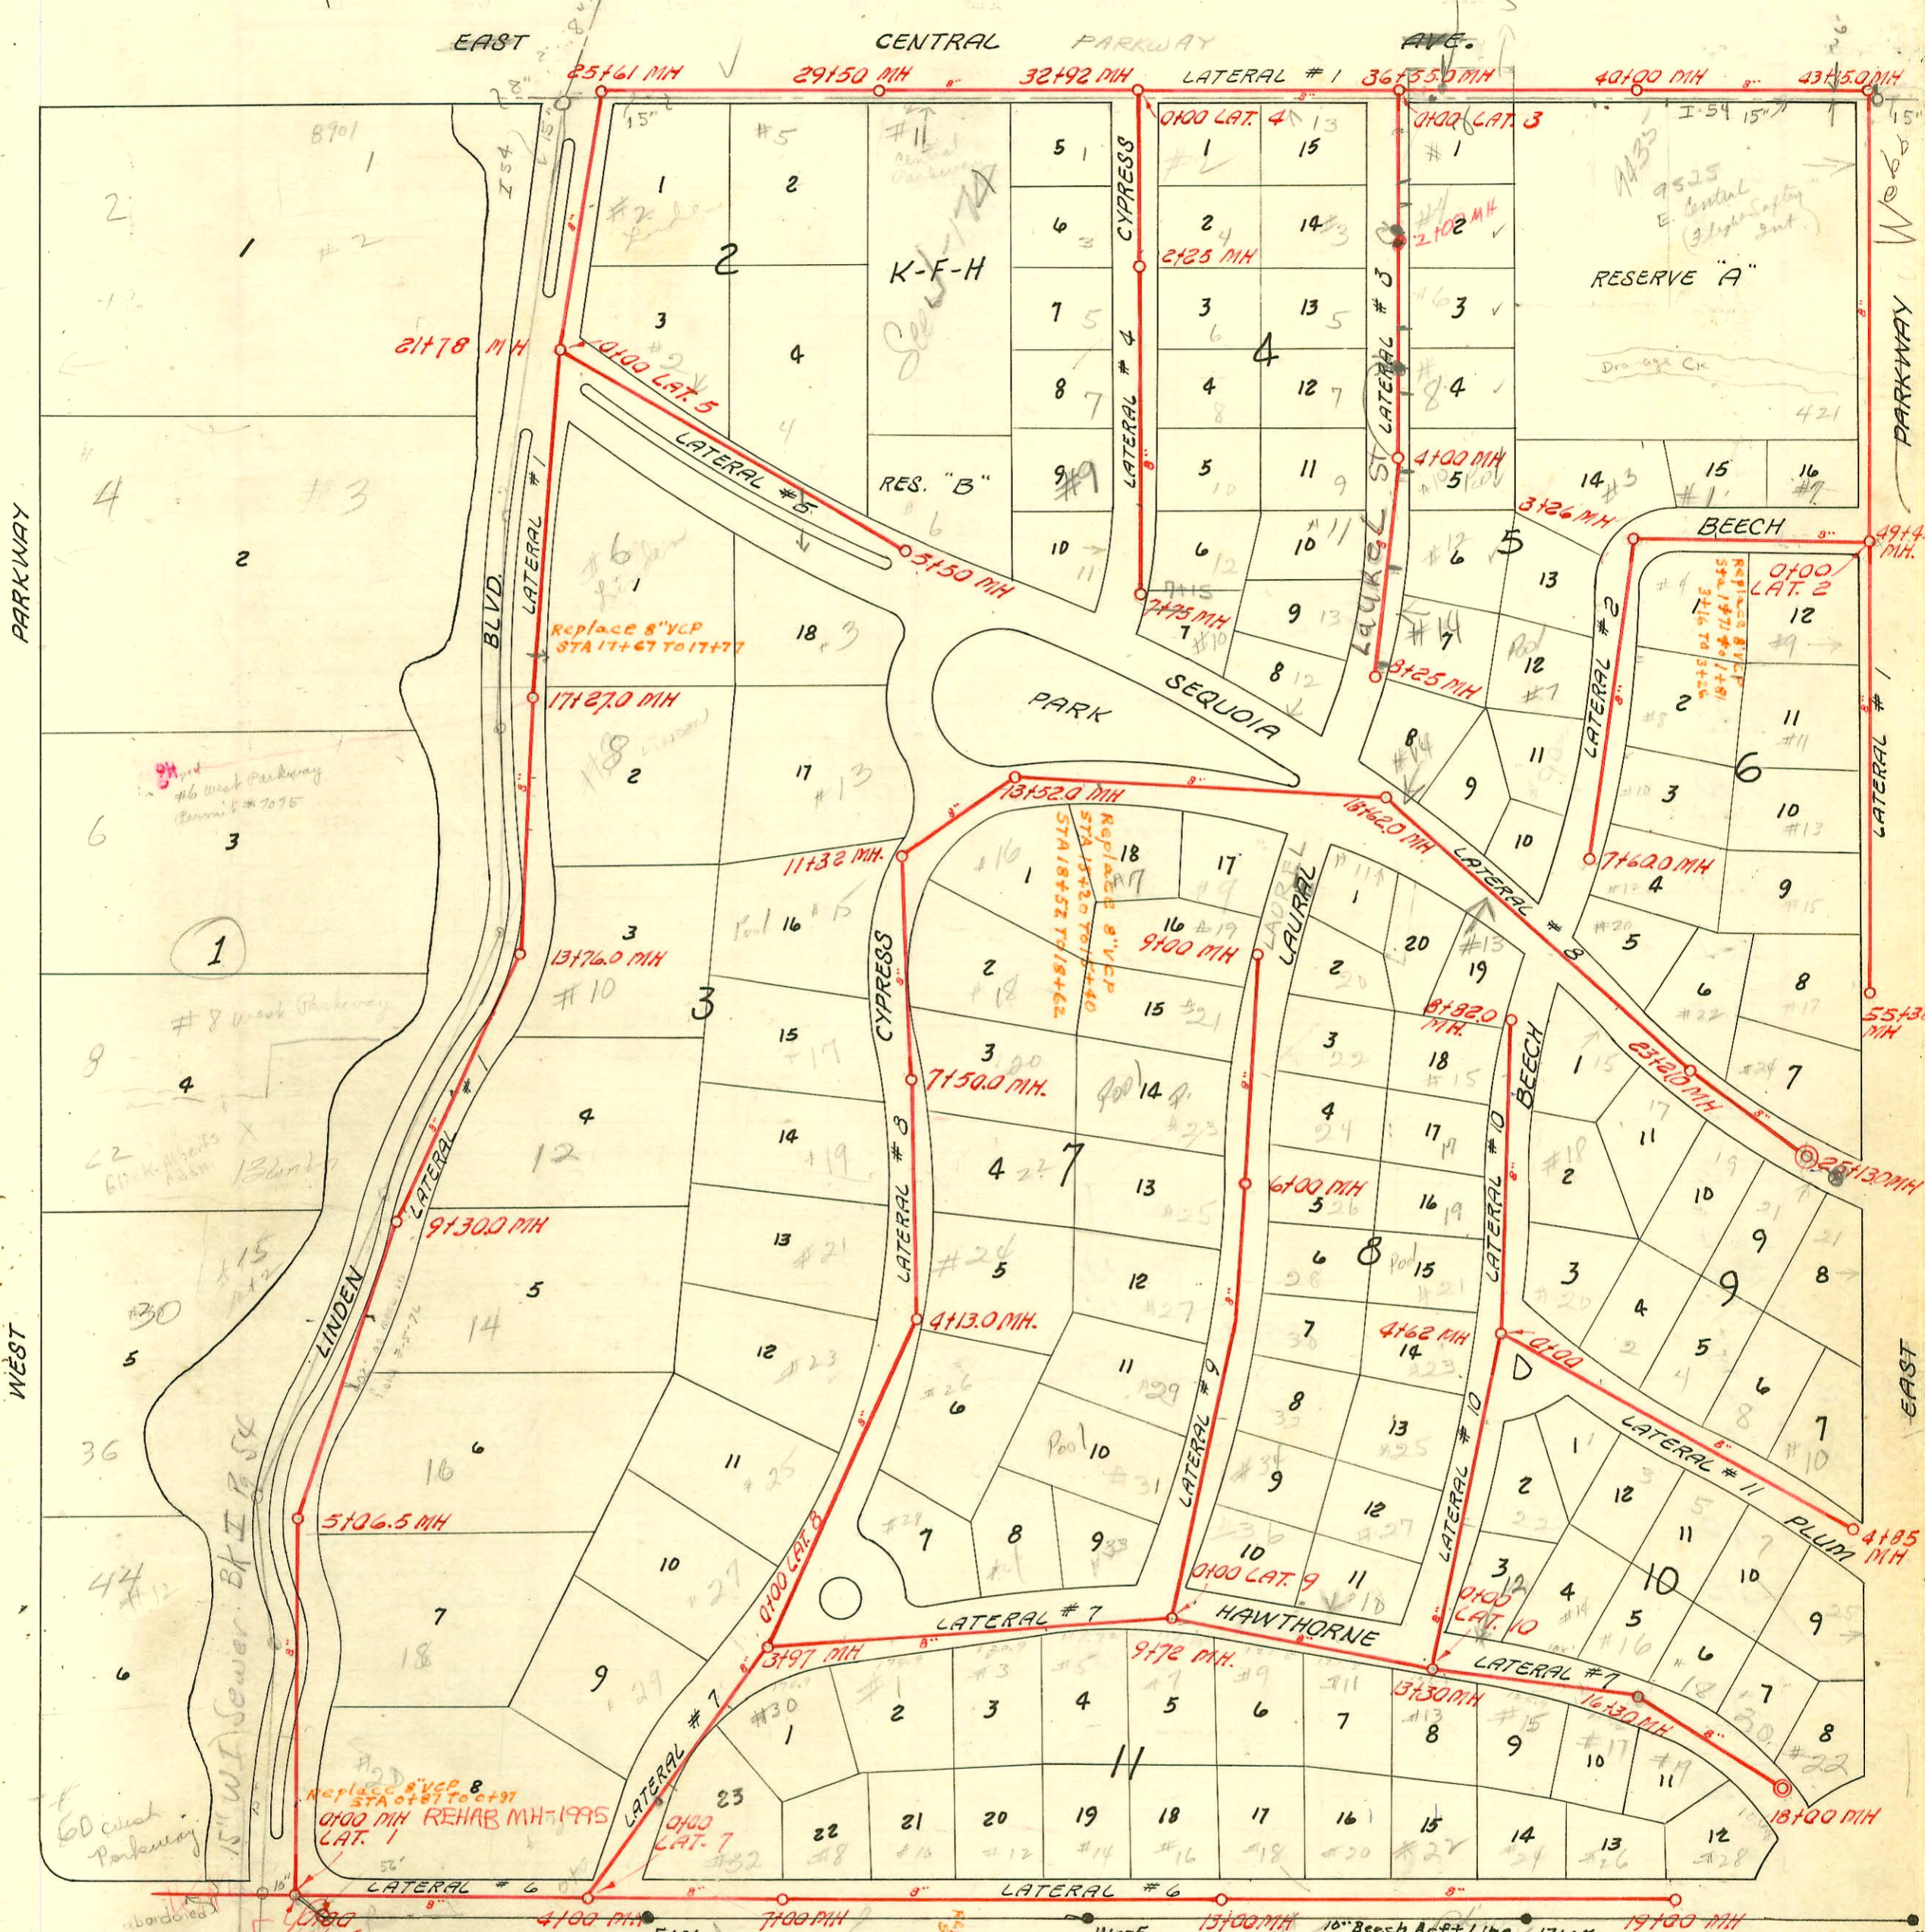

RECON FOREST HILLS SEWER
 BUILT BY: WB CARTER CONST CO.
 PROJ. NO 468-76-245-80623-000-000-001
 BOOKED 9-18-78

- #1566 Tap
- #14 Douglas
- #5589 Top
- #24 Cypress
- #2133 Top #8 Linden
- #5224 Top - 13 Hawthorne
- #1712 Top - 4 Hawthorne
- #2441 Top - 7 Beech Rd.
- #2750 Top - 31 Central Dr.
- #2447 Top - 7 Laurel Dr.
- #2443 Top - 11 Hawthorne
- #3190 Top - 6 Cypress Dr.
- #1537 Top - 27 Laurel Dr.
- nc 665989 - #29 Laurel - 9 Stamp - 4-19-78
- nc 665990 - #30 Laurel -
- nc 665991 - #130 Laurel -
- nc 665992 - #27 Laurel -
- nc 665993 - #28 Laurel -

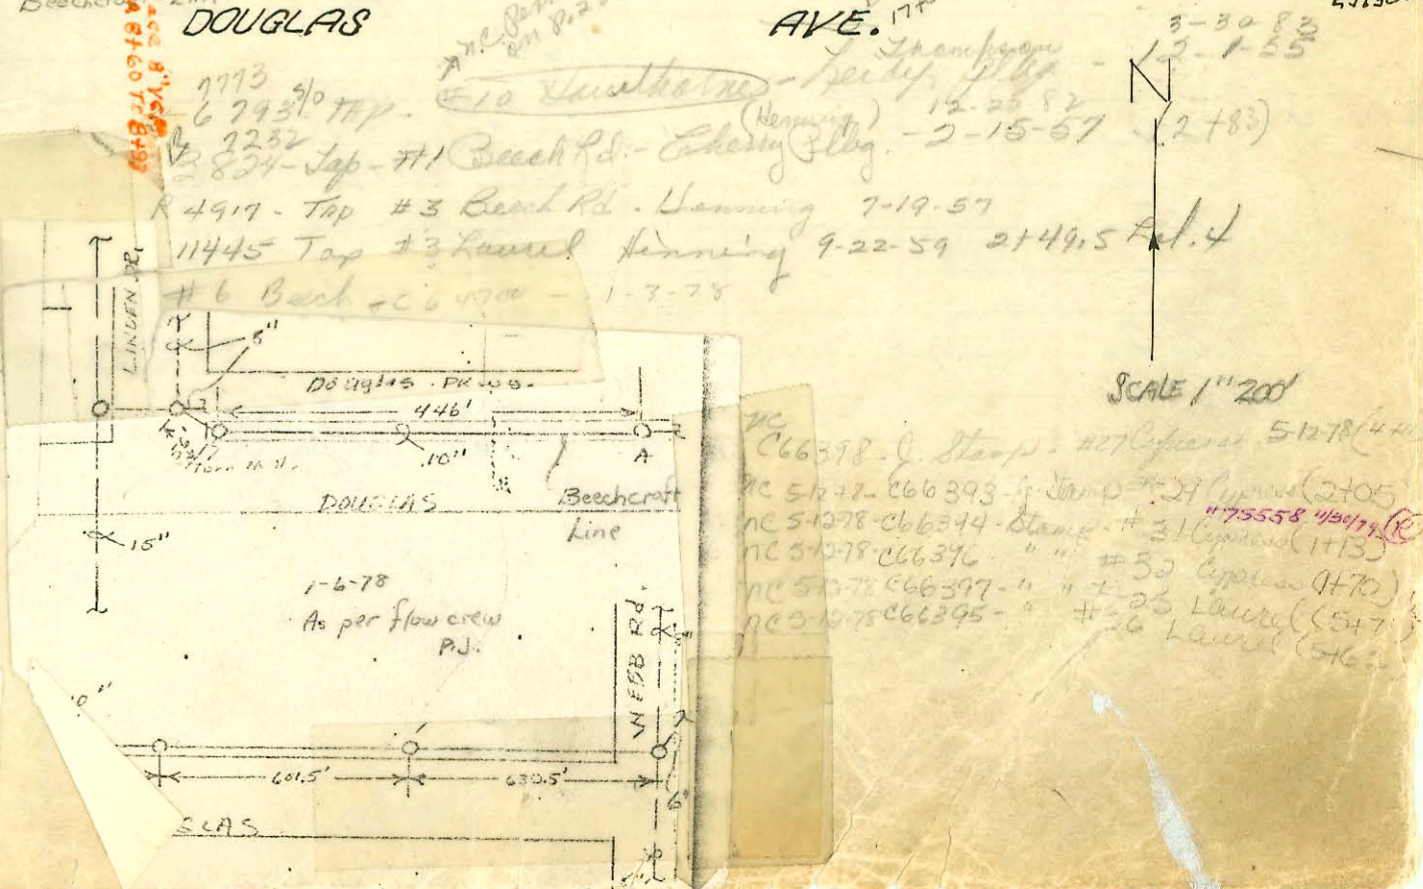

SCALE 1"=200'

nc 666378 - Stamp #27 Cypress 5-12-78
 nc 5672 - 666393 - Stamp #24 Laurel 2-10-78
 nc 51078 - 666344 - Stamp #31 Cypress 11-13-78
 nc 51078 - 666376 - Stamp #30 Cypress 11-13-78
 nc 51078 - 666397 - Stamp #27 Cypress 11-13-78
 nc 51078 - 666395 - Stamp #26 Laurel 11-13-78

