


CENTRAL

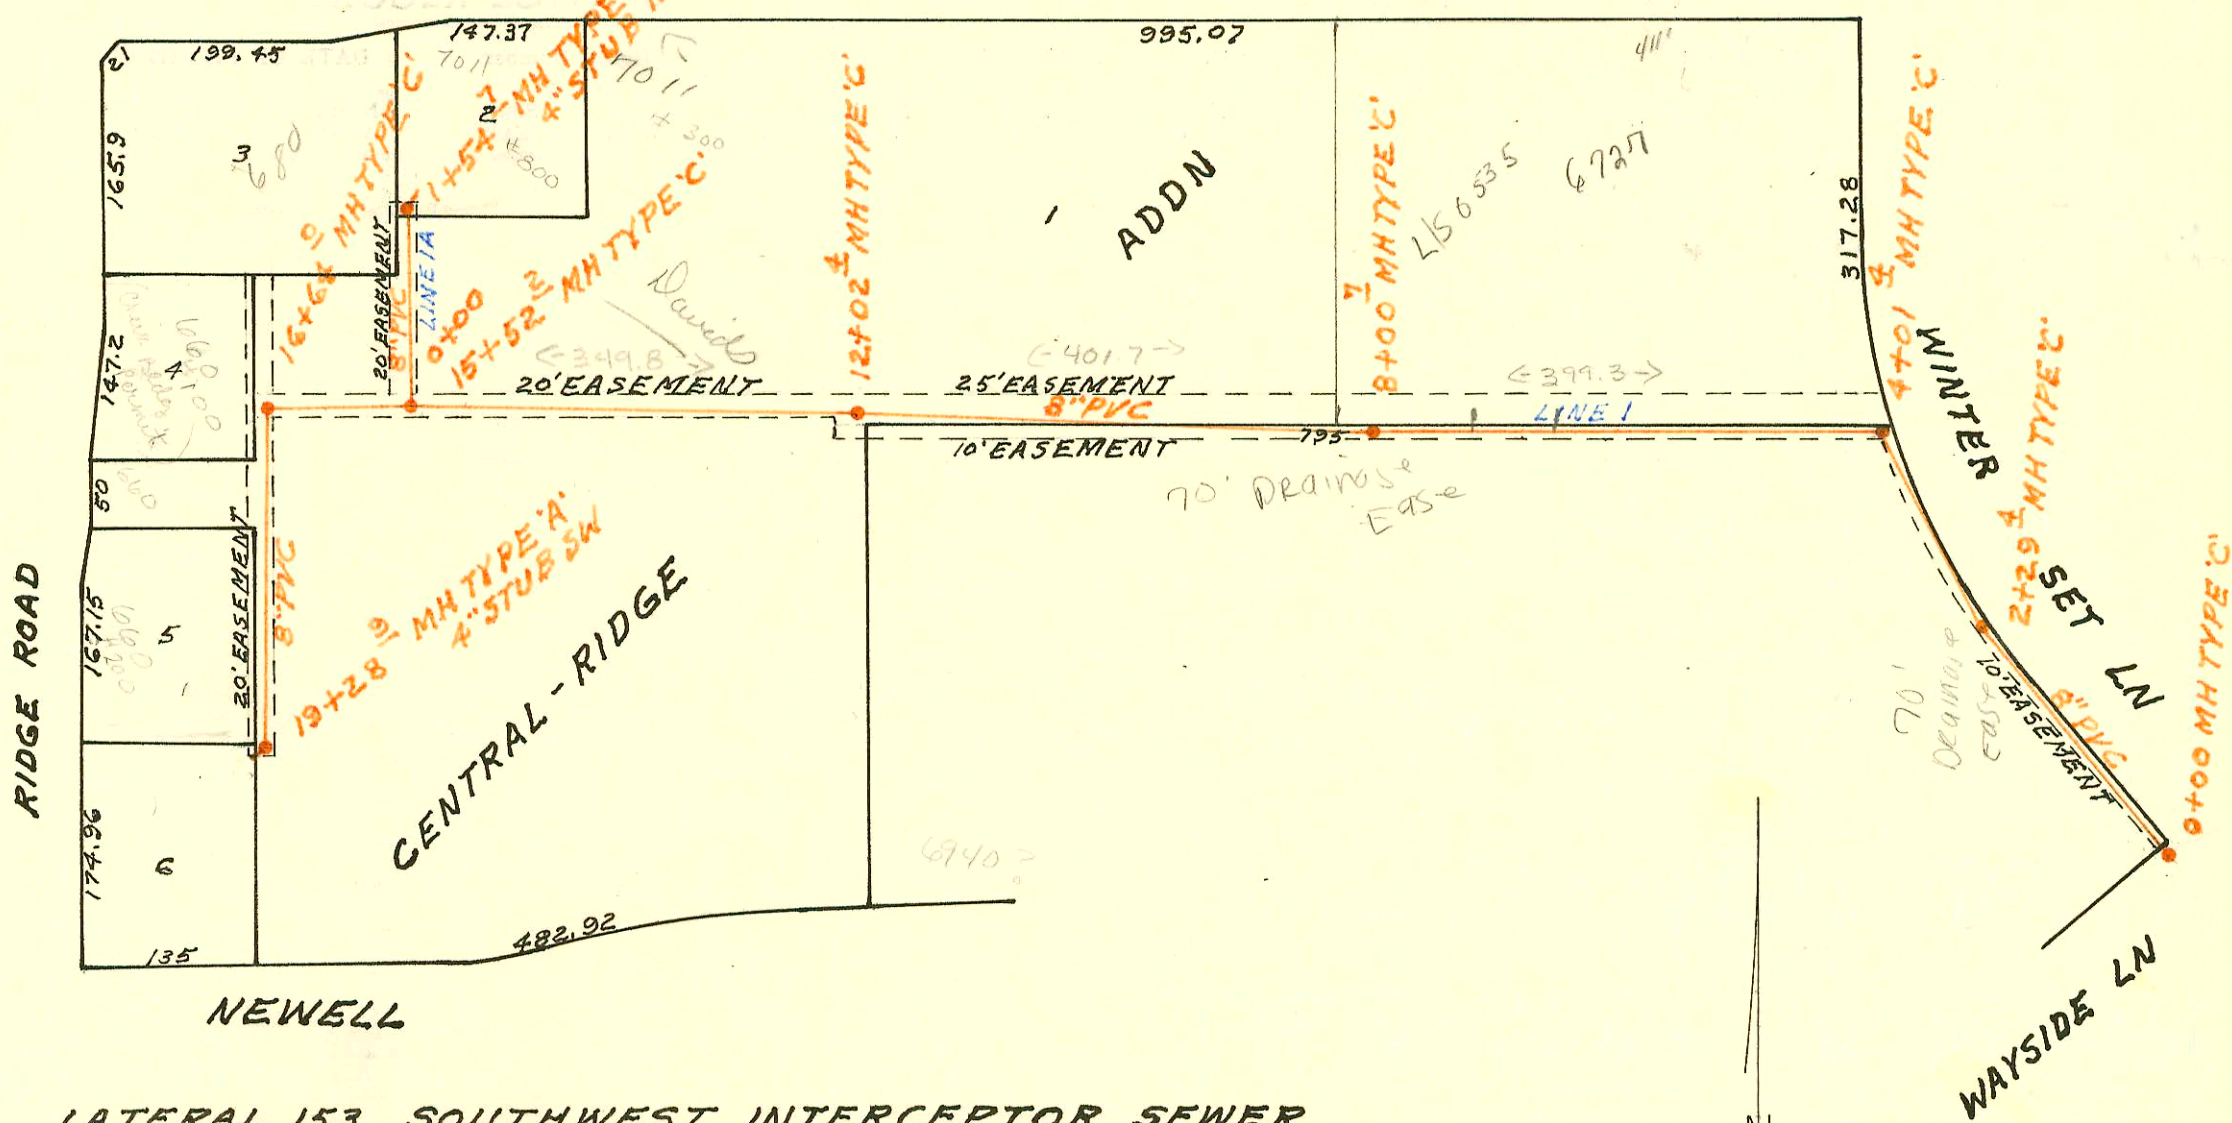

LATERAL 153 SOUTHWEST INTERCEPTOR SEWER  
 BUILT BY: DEAN EXCAVATION CO.  
 PROJ. NO 468-76-245-80952-000-000-001  
 BOOKED 1-17-81 FROM DRH 12

SCALE 1" = 150'

011 110 P  
 6-110 P

CONSTRUCTION RECORD

SERVICE RECORD

STATION	ELEVATION		Depth	MANHOLE	4-INCH "Y" BRANCHES		No. of Permit		House Number		DATE OF PERMITS	
	Ground	Grade			North West	South East	North West	South East	North West	South East	North West	South East
<b>LATERAL 153 SOUTHWEST INTERCEPTOR SEWER</b>												
LINE 1 0+00	126.7	115.00	11.7	0+00								
1+00	126.0	116.18	9.8									
2+00	125.2	117.36	7.8									
	128.0	117.72	10.3	2+29.4								
		117.92	10.1									
3+00	125.3	118.20	7.1									
4+00	125.9	118.60	7.3									
	128.0	118.61	9.4	4+01.4								
		118.81	9.2									
5+00	125.6	119.20	6.4									
6+00	125.3	119.60	5.7									
7+00	125.0	120.00	5.0		6+56.7		5895		6727 W		5-20-82	
					7+25.0		5896		Central		5-20-82	
8+00	128.5	120.40	8.1	8+00.7								
		120.60	7.9									
9+00	124.6	121.00	3.6									
10+00	124.2	121.40	2.8									
11+00	124.0	121.80	2.2		10+41.0		6424		7011 W		8-26-82	
									Central			
12+00	124.0	122.20	1.8	12+02.4								
	130.3	122.21	8.1									
		122.41	7.9		12+81.0		6425		7011 W		8-26-82	
13+00	124.2	122.80	1.4						Central			
14+00	124.3	123.20	1.1		14+28.9		1326		7011 W		9-23-80	
									Central			
15+00	124.6	123.60	1.0	15+52.2								
	132.6	123.81	8.8									
		124.21	8.4									
16+00	125.6	124.77	0.8	16+64.0			7257		660 N		1-3-83	
	135.7	125.51	10.2		16+67.0				Ridge Rd			
		125.71	10.0									
17+00	128.4	126.79	1.6									
18+00	133.6	129.79	3.8									
19+00	138.7	132.79	5.9	19+28.9			8689		660 N		7-12-83	
	138.6	133.66	4.9		4" R/C sch 40		27117		555 N		2-21-91	
					4" stub SW				Ridge Rd			
LINE 1A 0+00	132.6	124.20	8.4	0+00 = 15+52.2								
				LINE 1								
1+00	124.7	124.50	0.2	1+43.7			9080		680 N		8-29-83	
	131.7	124.66	7.0	1+54.7			3226		7011 W		4-30-81	
					4" STUB NE				Central			
<b>LAT 47 MAIN 1 SOUTHWEST INTERCEPTOR SEWER</b>												
LINE 1 0+00	85.5	76.04	9.5	0+00 EXISTING								
0+55	85.5	76.15	9.4	Begin Pipe								
1+00	86.7	76.24	10.5									
2+00	86.4	76.44	10.0									
	86.9	76.52	10.4	2+42.3								
3+00	86.3	76.75	9.6									
4+00	86.6	77.15	9.5									
	86.7	77.20	9.5	4+12.3								
		77.30	9.4									
	87.0	77.58	9.4	4+83.1								
		77.68	9.3									
5+00	87.0	77.75	9.3				2108		1520		12-15-80	
					5+48.1				Mills			
							2123		1602		12-16-80	
					5+52.6				Mills			

David's

CONT'D NEXT PAGE