


SCALE 1" = 150'

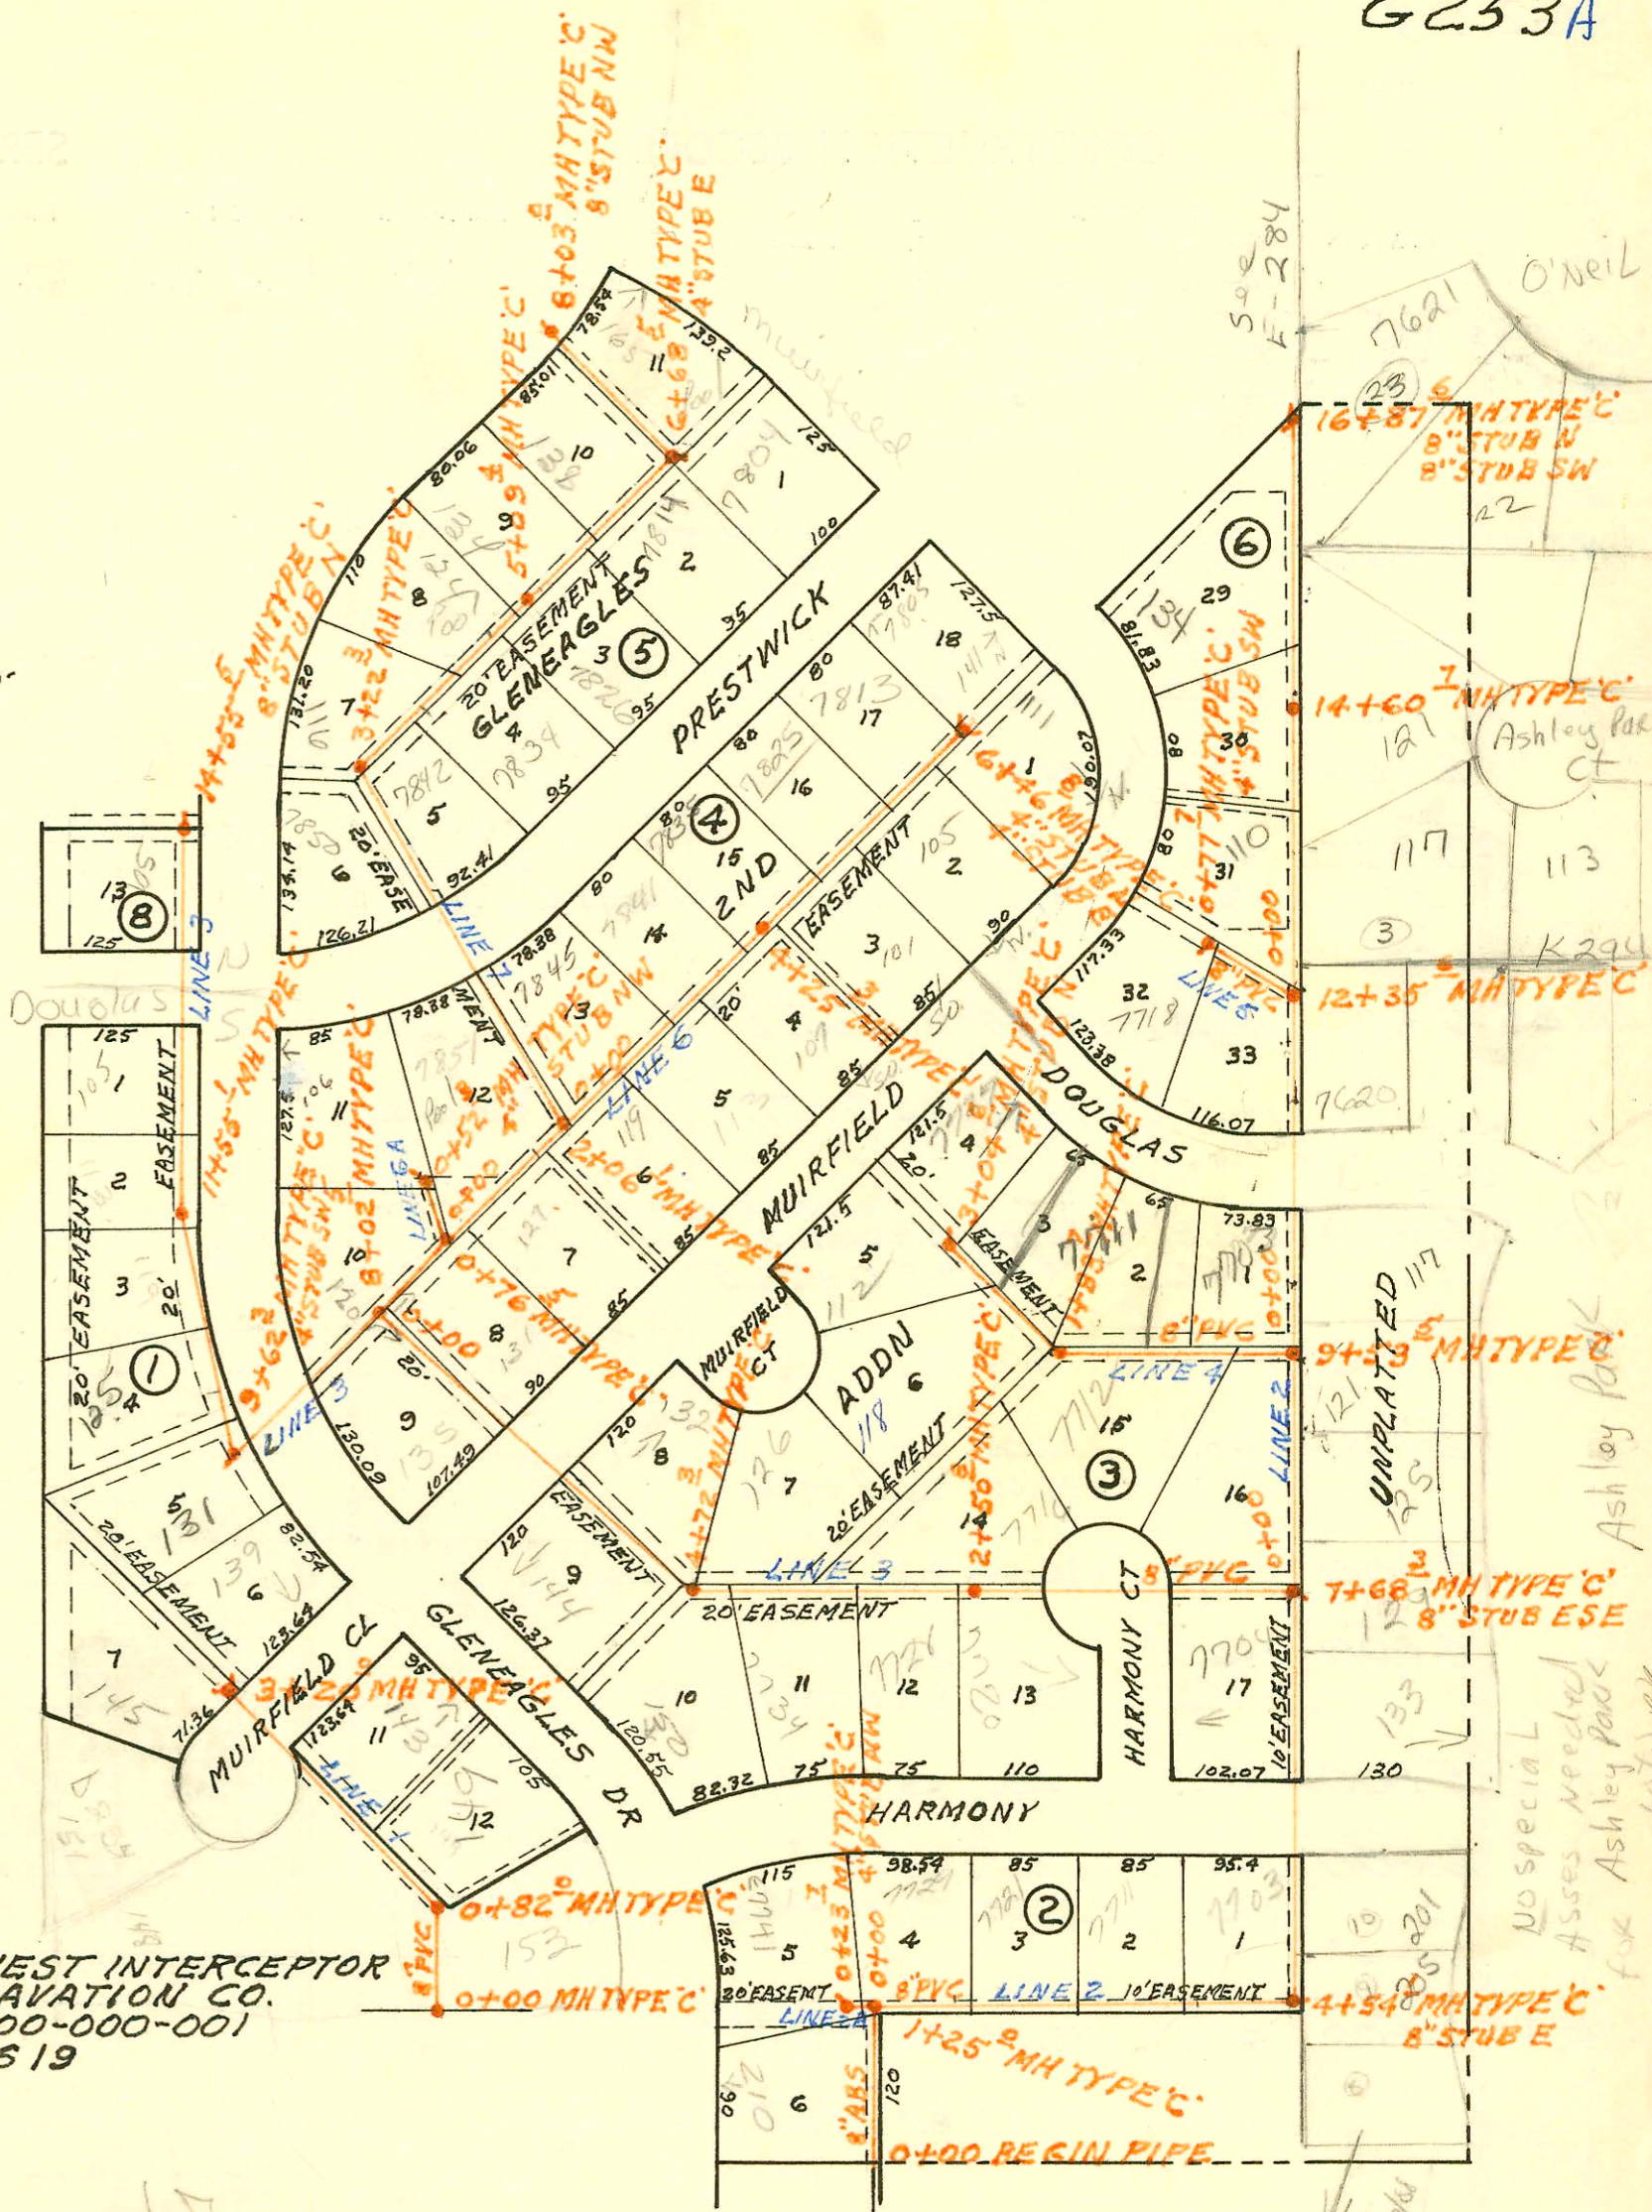

LATERAL 33 MAIN 4 SOUTHWEST INTERCEPTOR
 BUILT BY: CLEARWATER EXCAVATION CO.
 PROJ. N^o 468-76-245-80855-000-001
 BOOKED 1-24 -81 FROM LES 19

on map

70-5

0254

Refer to New
 Line for this Lot
 Not Rel as of 11/17/04
 B/L

No special
 Asses needed
 for Ashley Park
 10/15/04

CONSTRUCTION RECORD

SERVICE RECORD

LAT 33 MAIN 4 SWI (CONT'D)
LINE 2 CONT'D

STATION	ELEVATION		Depth	MANHOLE	4-INCH "Y" BRANCHES		No. of Permit		House Number		DATE OF PERMITS	
	Ground	Grade			North West	South East	North West	South East	North West	South East	North West	South East
4+00	140.3	131.51	8.8									
	140.3	131.66	8.6									
	140.3	131.76	8.5	4+54.1	8" STUB E		22212		205 S Ashley PK		12-13-88	
5+00	140.3	131.89	8.4		4" SDR 35 5+27.1 NC		9512127		201 S Ashley PK		8-7-95	
6+00	141.2	132.17	9.0		6+43.3 TAP		84184		133 S Ashley PK		10-24-89	
					6+50.3 TAP		20899		7704 Harmony		6-20-86	
7+00	142.0	132.45	9.6									
	143.0	132.64	10.4	7+68.3	8" STUB ESE							
8+00	143.4	132.73	10.7		8+01.3 TAP		24254		129 S Ashley PK		11-9-89	
					8+17.5 TAP		22906		125 S Ashley PK		4-12-89	
9+00	143.7	133.01	10.7		4" SDR 35 N/C 9+45.5		94-13451-7		121 S Ashley PK		8-18-94	
	144.0	133.16	10.8	9+53.5								
10+00	144.2	133.29	10.9				13953		7703 W Douglas		6-4-85	
					10+38.5 TAP		26625		117 S Ashley PK		11-26-90	
11+00	144.7	133.57	11.1									
12+00	145.6	133.84	11.8				23640		7620 W Douglas		7-28-89	
	145.8	133.94	11.9	12+35.6	12+23.0 TAP							
13+00	146.2	134.12	12.1		4" SDR 35 NC 13+37.6	4" SDR 35 M.H. Stub	95-31697	92-69357	110 W W. Douglas	117 W Ashley PK	3-8-95	5-12-92
14+00	146.5	134.40	12.1									
	145.9	134.57	11.3	14+60.7	14+30.7 TAP		91-08657-7		121 W Ashley PK		8-1-91	
15+00	145.8	134.68	11.1				16619	95-151197	134 W Mansfield	7621 O'Neil	7-15-86	9-18-95
16+00	146.9	134.96	11.9									
	144.4	135.20	9.2	16+87.6	8" STUB N 8" STUB SW							
LINE 2 0+00	140.6	130.74	9.9	0+00 = 1+25.0								
	140.7	130.83	9.9	0+23.7	4" STUB NW		9067		7741 Harmony		12-10-80	
LINE 3 0+00	143.2	132.85	10.4	0+00 = 7+68.3								
1+00	143.3	133.15	10.2									
2+00	143.1	133.45	9.7				13149		7700 W Douglas		3-5-85	
	143.2	133.60	9.6	2+50.8	2+77.2 TAP		11505		7716 W Harmony		9-18-84	
3+00	142.7	133.75	9.0				18230		7708 Harmony		4-28-87	
4+00	143.2	134.05	9.2				16489		7734 Harmony		6-17-86	
	143.7	134.27	9.4	4+72.3	4+06.5 TAP		9996		126 S Mansfield		1-11-89	1-21-87
	143.7	134.37	9.3		4+53.5 TAP		2480		150 S Mansfield		1-26-81	
5+00	143.7	134.45	9.3				17664		144 S Mansfield		6-27-87	
6+00	143.8	134.75	9.1				6523				9-10-80	
7+00	144.0	135.05	9.0									
8+00	143.8	135.35	8.5									
	143.8	135.36	8.4	8+02.5	8+63.1 TAP		17594		135 S Mansfield		1-7-87	
	143.8	135.46	8.3									
9+00	143.7	135.75	8.0									
	144.3	135.94	8.4	9+62.3	4" STUB SW		17452		131 S Mansfield		2-12-86	
	144.3	136.44	7.9		9+81.3 TAP							
10+00	142.8	136.55	6.3				7573		125 S Mansfield		2-28-83	
11+00	143.1	136.85	6.3				8483		119 S Mansfield		6-22-83	
	144.7	137.02	7.7	11+55.1								
	144.7	137.12	7.6				9419		113 S Mansfield		10-12-83	
12+00	143.4	137.25	6.2									
13+00	144.2	137.55	6.7				7403		105 S Mansfield		12-11-83	

CONT'D NEXT PAGE