


MAIN 11 SOUTHWEST INTERCEPTOR SEWER  
BUILT BY: W.B. CARTER CONST. CO  
PROJ. NO 468-76-245-80733-000-000-001  
BOOKED 2-3 -81 FROM LES 20

Plot 4-63

SCALE 1" = 300'

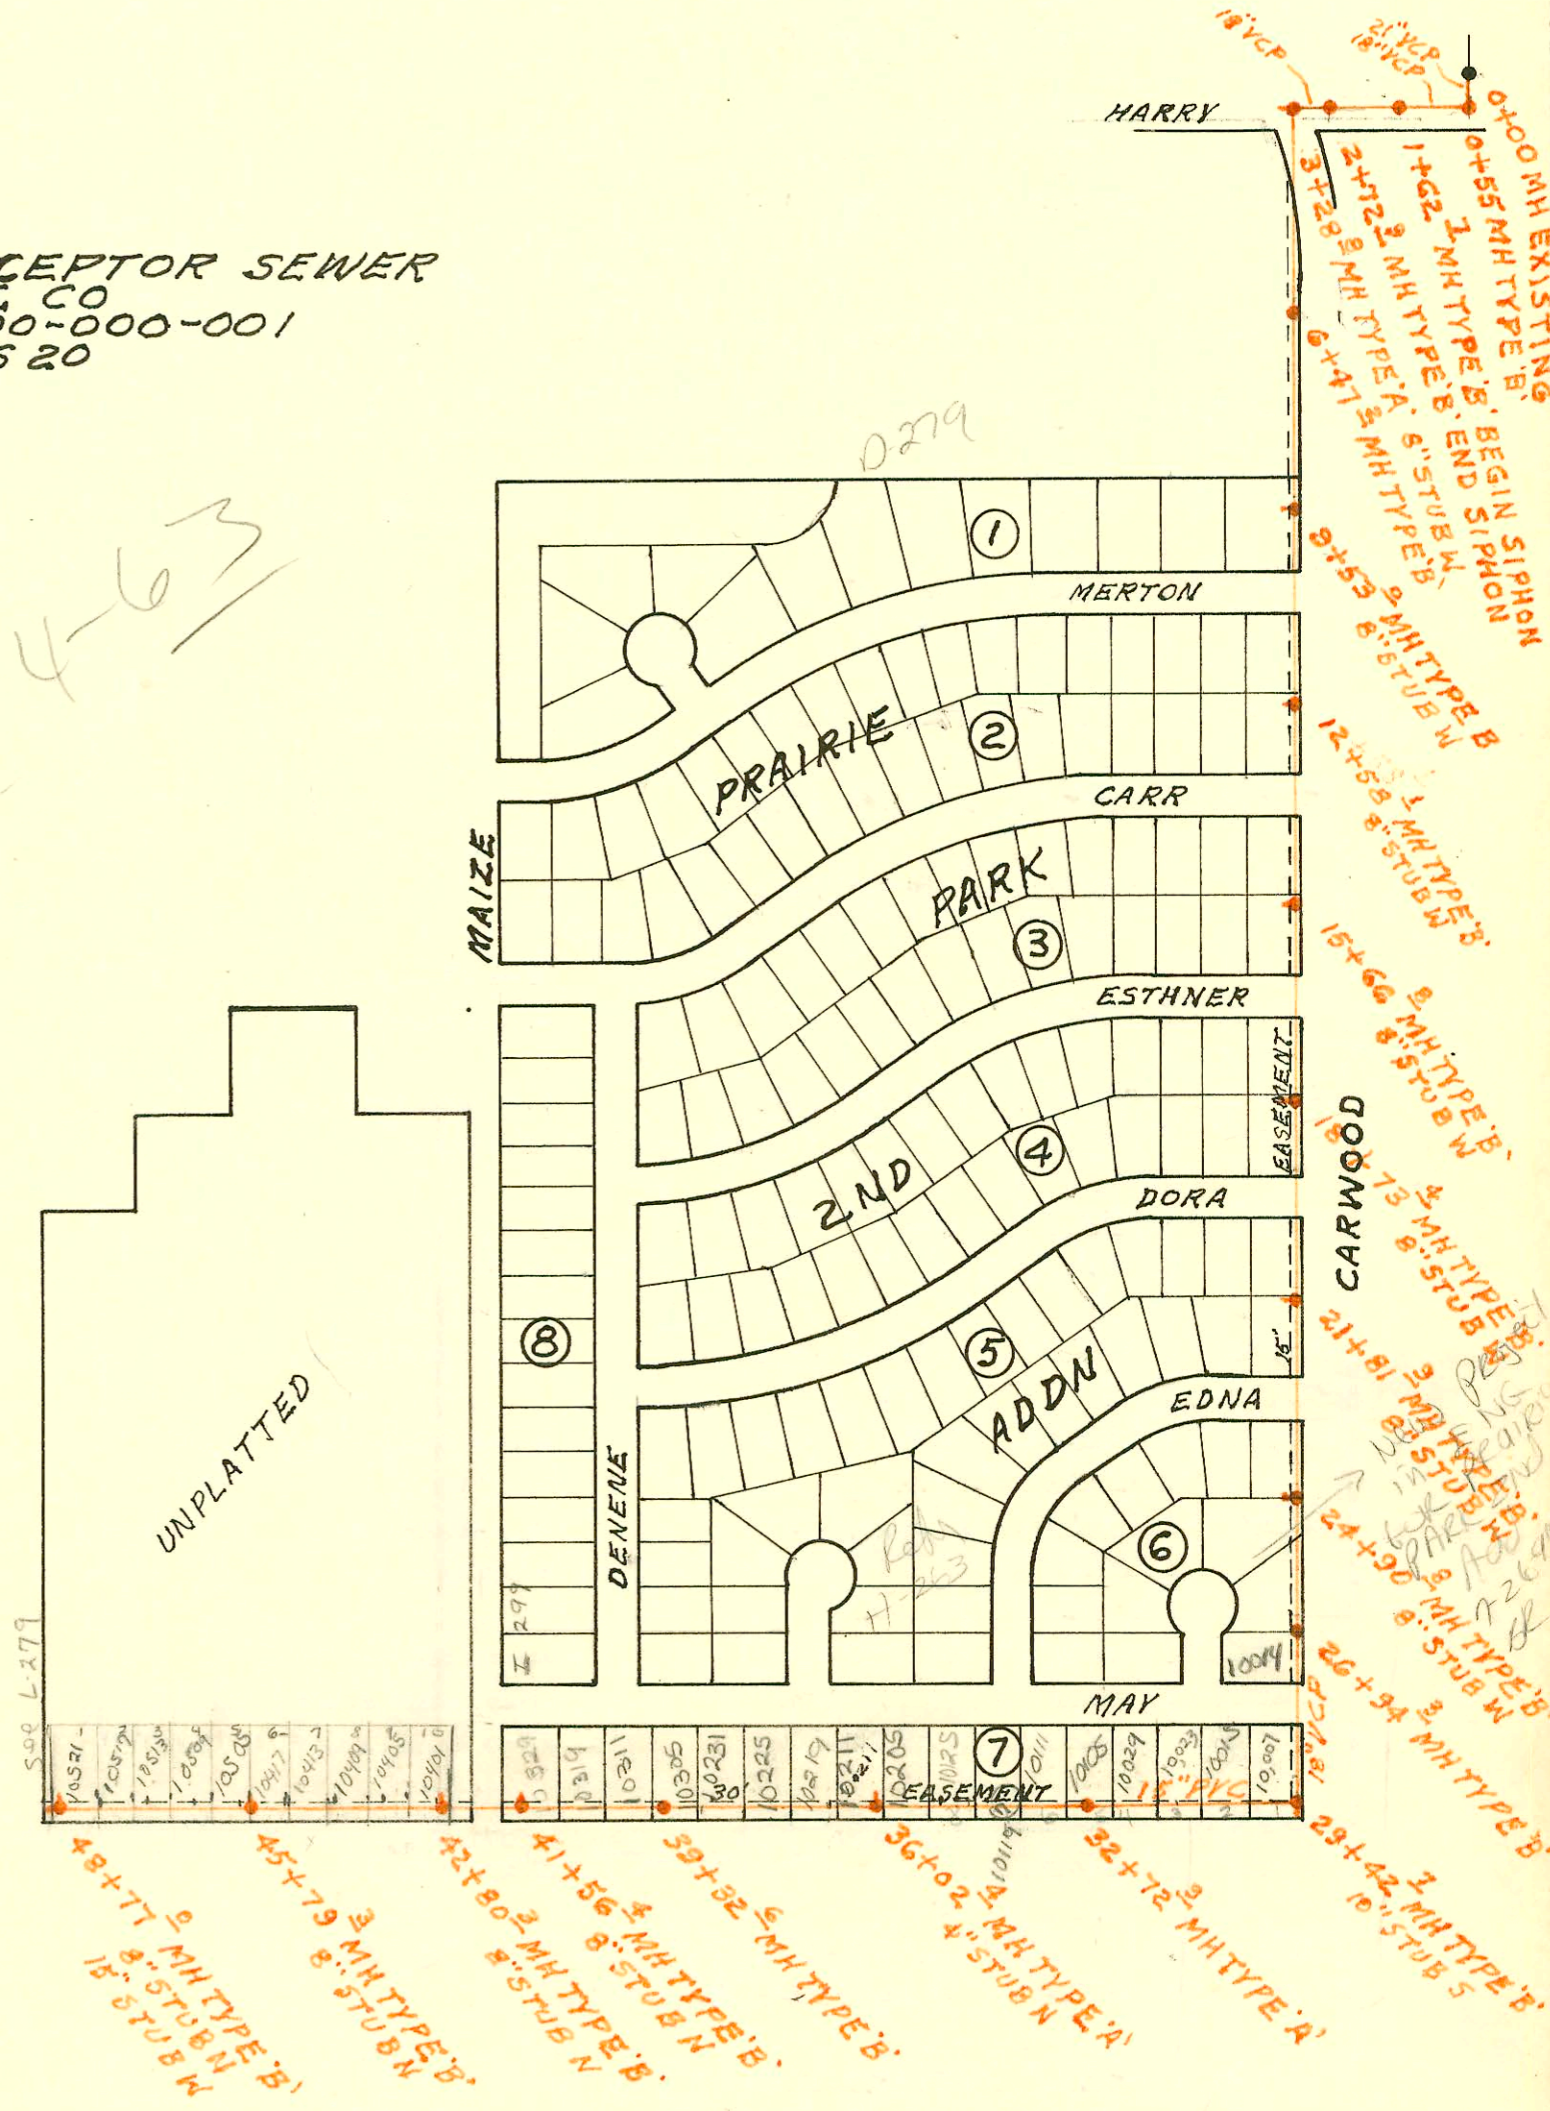

Note:

No. Add'l Fee Req'd for  
Building Connections to Main  
per Gene Rath 11-23-92  
BR

CONSTRUCTION RECORD

SERVICE RECORD

MAIN 11 SOUTHWEST INTERCEPTOR

STATION	ELEVATION		Depth	MANHOLE	4-INCH "Y" BRANCHES		No. of Permit		House Number		DATE OF PERMITS	
	Ground	Grade			North West	South East	North West	South East	North West	South East	North West	South East
0+00	125.8	106.09	19.7	0+00 EXISTING								
	117.3	106.21	11.1	0+55								
1+00	117.7	106.50	11.2									
	116.5	106.58	9.9	1+62.7								
2+00	114.7	107.69	7.0									
	118.0	108.13	9.9	2+72.9								
3+00	119.7	108.16	11.5									
	121.4	108.20	13.2	3+28.8	8" STUB W							
4+00	121.7	108.38	13.3									
5+00	123.0	108.50	14.5									
6+00	125.0	108.62	16.4									
	126.3	108.68	17.6	6+47.2								
7+00	127.5	108.74	18.8									
8+00	129.6	108.86	20.7									
9+00	130.3	108.98	21.3									
	130.7	109.05	21.7	9+53.0	8" STUB W							
10+00	130.6	109.11	21.5									
11+00	130.6	109.23	21.4									
12+00	130.5	109.35	21.2									
	130.5	109.42	21.1	12+58.1	8" STUB W							
13+00	130.5	109.47	21.0									
14+00	130.4	109.59	20.8									
15+00	130.3	109.71	20.6									
	130.4	109.79	20.6	15+66.8	8" STUB W							
16+00	130.5	110.33	20.2									
17+00	131.1	110.45	20.7									
18+00	131.7	110.57	21.1									
	132.1	110.66	21.4	18+73.4	8" STUB W							
19+00	132.0	110.69	21.3									
20+00	131.3	110.81	20.5									
21+00	130.6	110.93	19.7									
	130.1	111.03	19.1	21+81.9	8" STUB W							
22+00	129.8	111.05	18.8									
23+00	129.2	111.17	18.0									
24+00	128.4	111.29	17.1									
	127.8	111.40	16.4	24+90.8	8" STUB W			94-146527	10018 May Ct		9-13-94	
25+00	127.7	111.41	16.3									
26+00	128.0	111.53	16.5									
	128.1	111.64	16.5	26+94.3								
27+00	128.1	111.64	16.5									
				27+00 34" Riser W/121.50 see below				94-16477	10014 May Ct		10-20-94	
28+00	128.1	111.76	16.3									

(10014 W May Ct - 10-20-94 - 27+04.3 - RISER NOT CORRECT - 10' South - 4" Riser - 1/4" BENT - 4" SDR 35