



LATERAL 105 MAIN 4 SAN SEWER N223  
BUILT BY: WB CARTER CONST. CO.  
PROJ. N2 468-76-245-80960-000-000-001  
BOOKED 2-14-81 FROM CG18

on map  
9-29

SCALE 1" = 200'

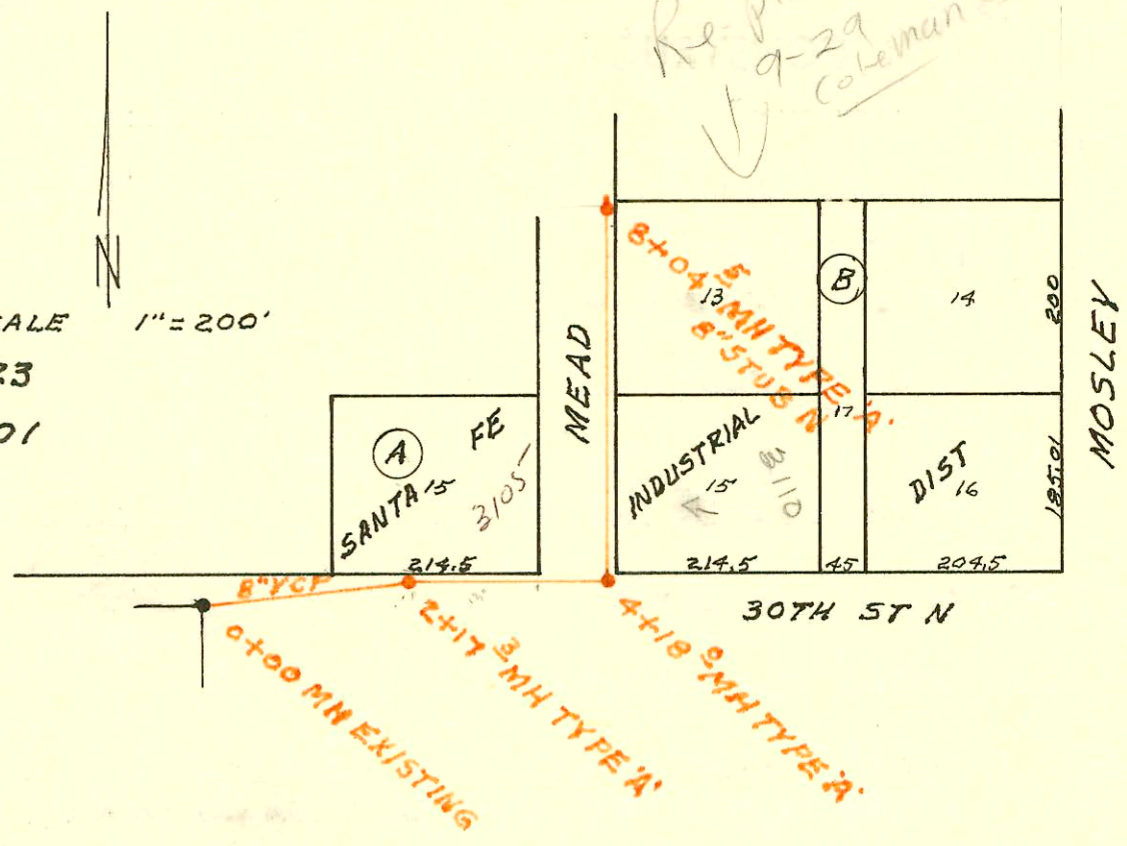

SCALE 1" = 150'

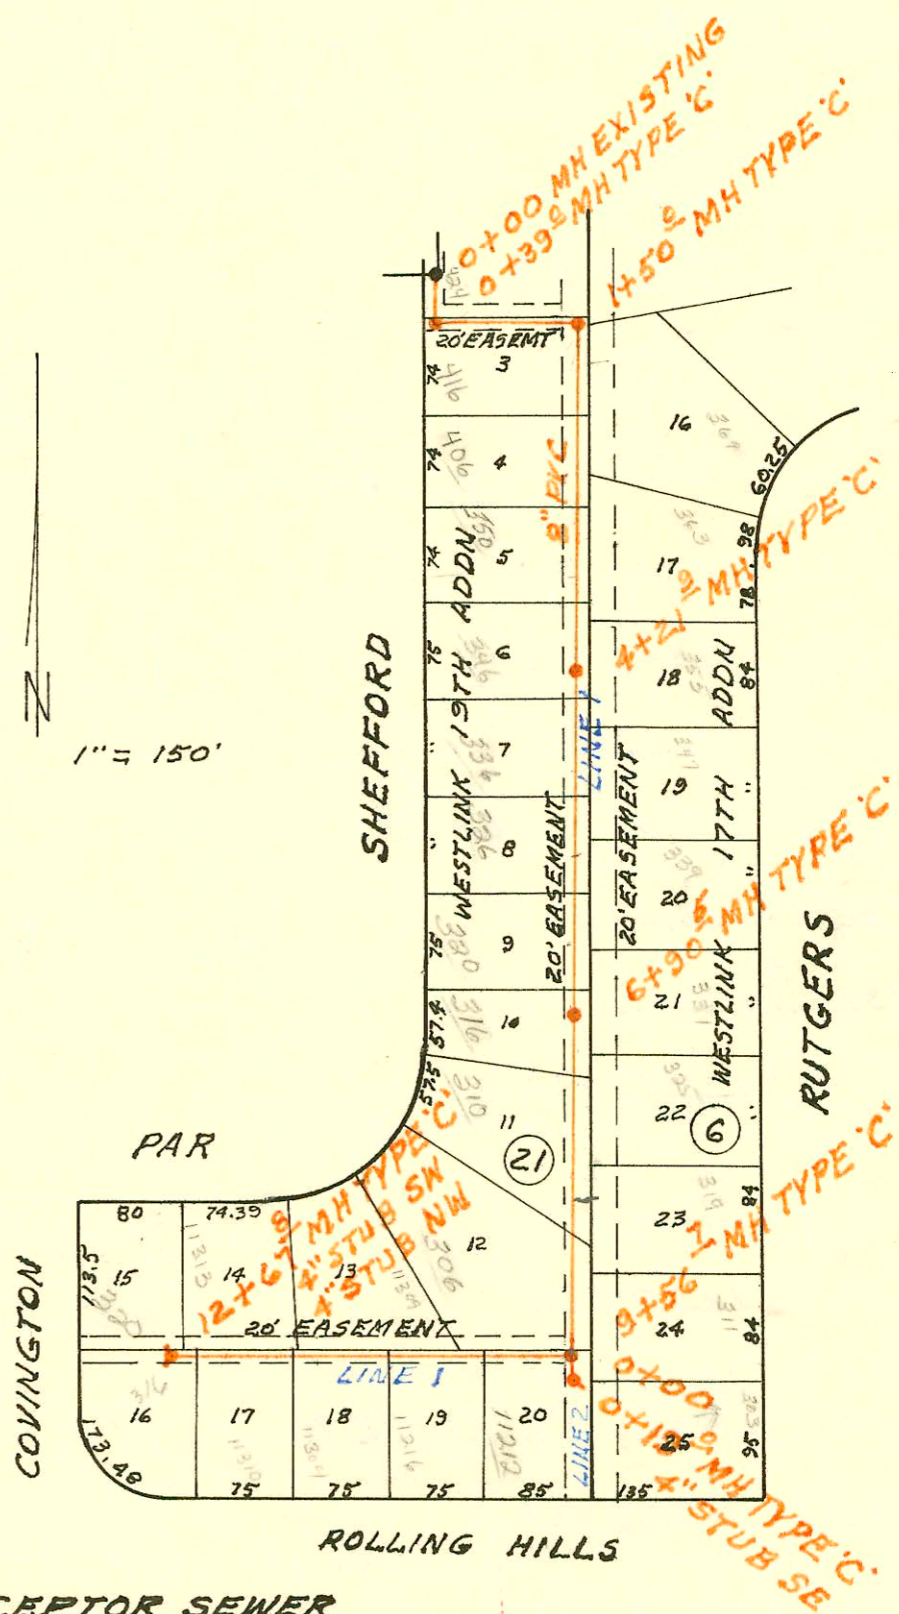

LATERAL 9 MAIN 10 SOUTHWEST INTERCEPTOR SEWER  
BUILT BY: CLEARWATER CONST. CO.  
PROJ. N2 468-76-245-80987-000-000-001  
BOOKED 2-16-81 FROM AG9

on map  
4-49  
4-50

CONSTRUCTION RECORD

SERVICE RECORD

STATION	ELEVATION		Depth	MANHOLE	4-INCH "Y" BRANCHES		No. of Permit		House Number		DATE OF PERMITS	
	Ground	Grade			North West	South East	North West	South East	North West	South East	North West	South East
<b>LAT 1 MAIN 12 SWI (CONT'D)</b>												
LINE 15 0+00	162.0	154.34	7.7	0+00=26+77.6 LINE 1								
	161.5	154.50	7.0	0+39.7	4" STUB N		16849		1630 Judith		8-18-86	
LINE 16 0+00	165.3	154.72	10.6	0+00=30+24.5 LINE 1				18555	1615 Judith		6-23-87	
								18554	1710 N Pinegrove		6-23-87	6-25-87
1+00	166.0	155.50	10.5					17113	1704 N Pinegrove		10-13-86	4-2-87
	166.3	156.00	10.3	1+63.3	4" STUB NW		18542		1609 Judith		6-2-87	
LINE 17 0+00	165.3	154.72	10.6	0+00=30+24.5 LINE 1								
	164.3	155.05	9.3	0+83.6	4" STUB NW	4" STUB E	17112	17303	1716 N Pinegrove	1681 N Judith	10-13-86	11-14-86
							18225	19411	1728 N Pinegrove	1629 Judith	4-27-87	10/26/87
LINE 18 0+00	165.7	156.02	9.7	0+00=32+76.1 LINE 1				20088		1709 Pinegrove		2-16-88
1+00	166.2	157.02	9.2									
	166.2	157.08	9.1	1+06.0	4" STUB SW		17779			1703 N Pinegrove		2-10-87
LINE 19 0+00	165.6	155.48	10.1	0+00=33+40.9 LINE 1				17778	1715 N Pinegrove		2-10-87	
	165.2	155.99	9.2	0+50.6	4" STUB SE		18475			1721 N Pinegrove		6-9-87
<b>LATERAL 105 MAIN 4 SAN SEWER N#23</b>												
0+00	127.0	118.47	8.5	EXISTING								
1+00	127.3	118.77	8.5									
2+00	127.7	119.07	8.6									
	129.0	119.12	9.9	2+17.3								
3+00	128.0	119.37	8.6									
4+00	128.0	119.67	8.3									
	127.9	119.75	8.2	4+18.0								
		119.82	8.1									
5+00	128.0	120.07	7.9									
6+00	127.8	120.37	7.4									
7+00	128.1	120.67	7.4									
8+00	128.7	120.97	7.7									
	128.7	120.98	7.7	8+04.5	8" STUB N			17726		3110 N Meadow		2-4-87
<b>LATERAL 9 MAIN 10 SOUTHWEST INTERCEPTOR</b>												
LINE 1 0+00	150.2	136.00	14.2	EXISTING								
	150.8	136.23	14.6	0+39.0								
		136.33	14.5									
1+00	151.3	136.70	14.6									
	151.2	137.00	14.2	1+50.0				3187	424 N Sheffield		4-27-81	
		137.10	14.1									
2+00	151.8	137.40	14.4									
3+00	152.7	138.00	14.7									
4+00	152.5	138.60	13.9									
	152.6	138.73	13.9	4+21.9				2988	346 N Sheffield		4-1-81	
5+00	152.2	139.20	13.0									
6+00	152.0	139.80	12.2									
	151.9	140.34	11.6	6+90.5				7296	316 N Sheffield	355 N Rutgers	4-13-89	1-3-83

CONT'D NEXT PAGE