


3-7-95 - Lot 6  
 1220-1230 E 37th  
 MHTapokid for Leak Bldg Per  
 calvin must core drill  
 within 2' of bottom & have  
 sewer admit in spec MHT Tap  
 IF add 1' Bldg's Bail on Lot  
 work portion of Lot  
 MUST extend City Sewer

1106 E 37th N  
 Refer to  
 Sewer Book  
 L-67 and  
 L-84 for Conn.  
 11/8/92  
 BK

3511 Ohio  
 DO NOT  
 supply  
 Sewer Permit  
 341-1514  
 12-2-92

1970

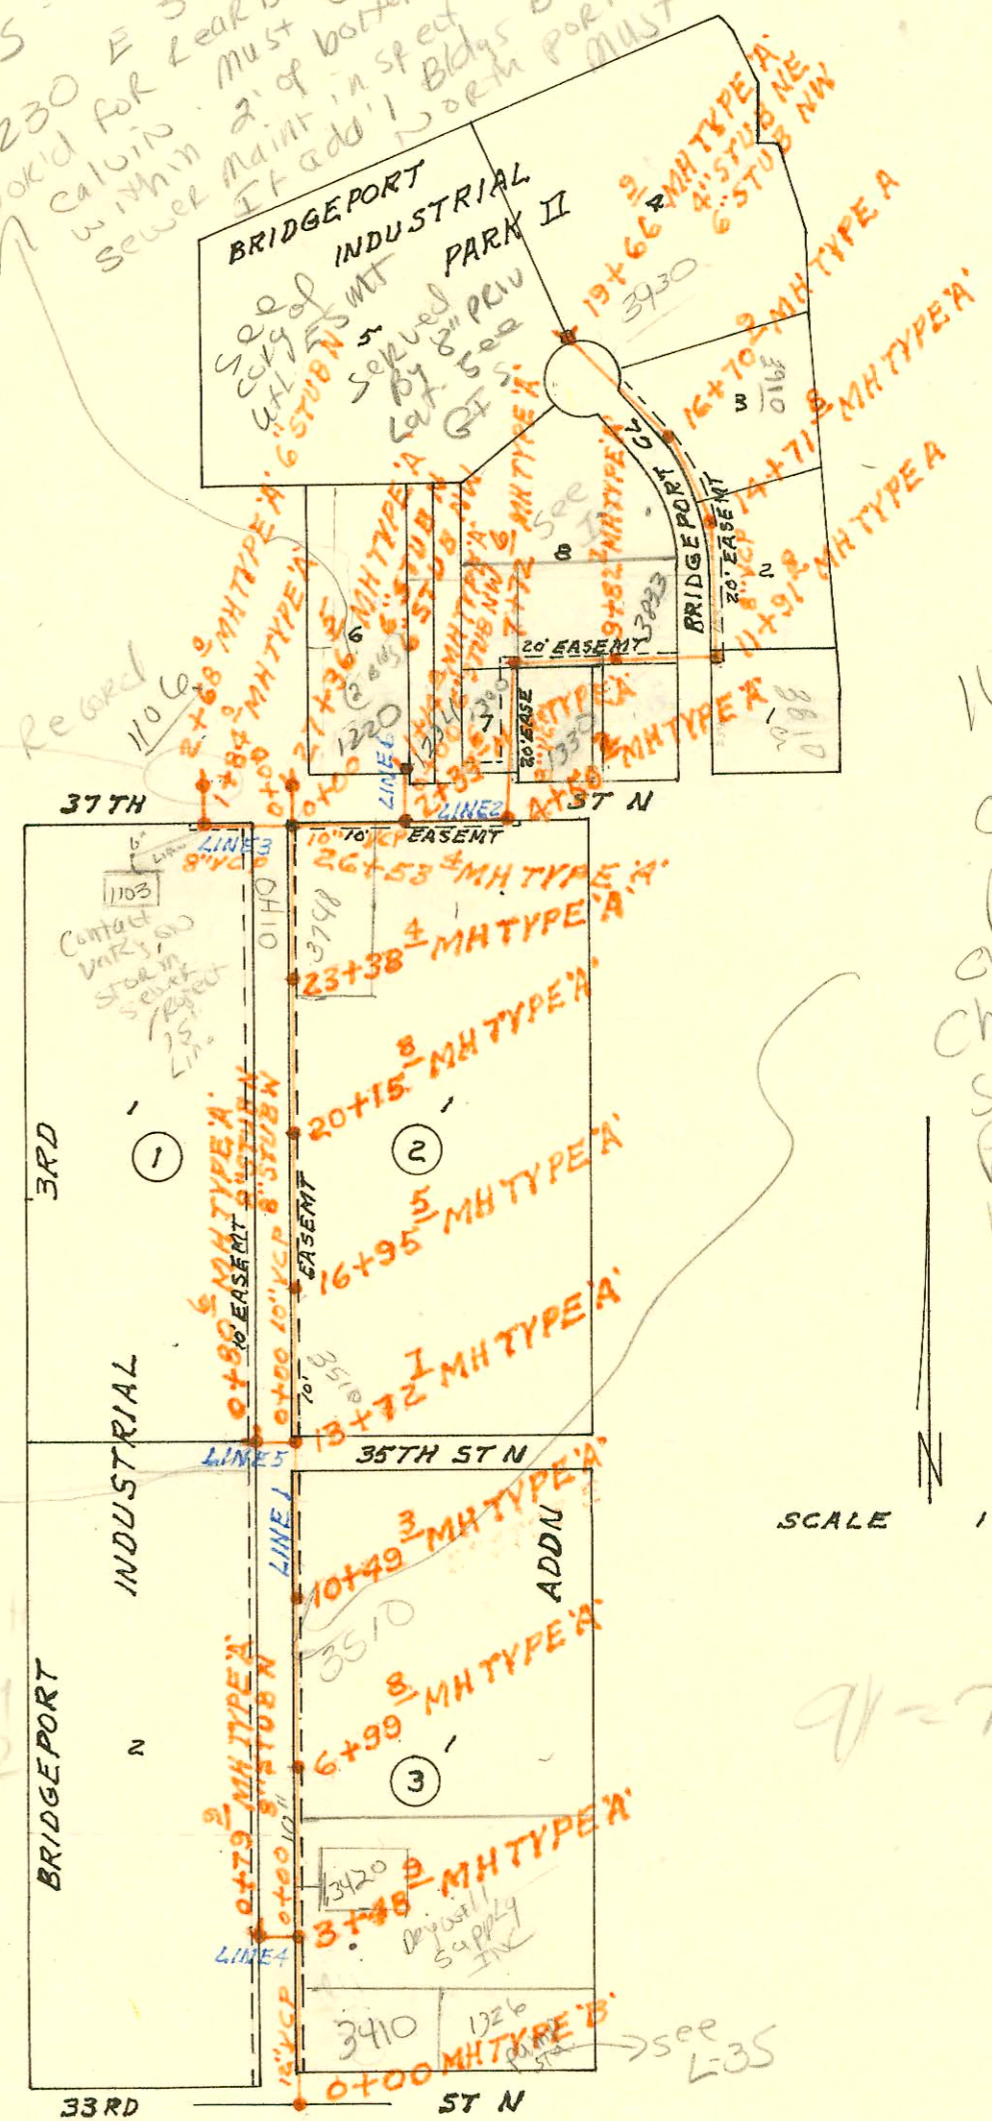

Note  
 on Don  
 problem  
 on main -  
 check with  
 sewer maint.  
 first before  
 issue sewer  
 permit to see  
 if a trap  
 will be  
 beg'd  
 12/6/92  
 BSR

SCALE 1" = 400'

LATERAL 102 MAIN 4 SAN SEWER N223  
 BUILT BY: COLEMAN EXCAVATING CO.  
 PROJ. N2 468-76-245-80928-000-000-001  
 BOOKED 2-19-81 FROM AG 10

2-6-92  
 2-6-92  
 F

CONSTRUCTION RECORD

SERVICE RECORD

STATION	ELEVATION		Depth	MANHOLE	4-INCH "Y" BRANCHES		No. of Permit		House Number		DATE OF PERMITS	
	Ground	Grade			North West	South East	North West	South East	North West	South East	North West	South East
<b>LAT 9 MAIN 10 SWI</b>												
LINE 1 CONT'D 7+00	151.8	140.40	11.4		7+87.2 <sup>top</sup>	7+64.5 <sup>top</sup>	3814	11167	310 N. Sheffield	325 Rutgers	7-31-81	6-12-84
8+00	151.5	141.00	10.5			8+34.7 <sup>top</sup>	9220			319 N. Rutgers		9-16-83
9+00	151.5	141.60	9.9		9+27.7 <sup>top</sup>	9+36.7 <sup>top</sup>	2534	8297	306 N. Sheffield	311 Rutgers	2-2-81	6-2-83
	151.8	141.94 142.04	9.3 9.8	9+56.7		9+63.8 <sup>top</sup>	6085			11212 Pulling Hills		7-1-82
10+00	152.0	142.30	9.7			10+44.1 <sup>top</sup>	6155			11212 Pulling Hills		7-14-82
11+00	152.6	142.90	9.7		11+24.7 <sup>top</sup>	10+60.7 <sup>top</sup>	4096		11309 Par		9-11-81	6-11-82
12+00	153.5	143.50	10.0		12+11.8 <sup>top</sup>		7754	5347	11313 Par	11310 Pulling Hills	3-24-83	3-11-82
	153.7	143.91	9.8	12+67.8	4" STUB NW	4" STUB SW	5186	5393	320 N. Conington	316 N. Conington	3-16-82	3-22-82
<b>LINE 2</b>												
0+00	151.8	141.94	9.9	0+00 = 9+56.7 LINE 1								
	151.9	142.05	9.9	0+19.0	4" STUB SE			6305		303 N. Rutgers		8-5-82
<b>LATERAL 102 MAIN 4 SAN SEWER N<sup>o</sup> 23</b>												
LINE 1 0+00	129.9	120.45	9.5	0+00				9980		10806 Jewell		1-25-88
1+00	130.5	120.65	9.9									
2+00	130.3	120.84	9.5			2+32.0 <sup>top</sup>	26621			3410 N. Ohio		5-5-88
3+00	130.2	121.04	9.2									
	131.3	121.13	10.2	3+48.9								
4+00	130.3	121.23	9.1					2004-01306		3420 Ohio		5-7-84
5+00	130.7	121.43	9.3									
6+00	130.9	121.62	9.3									
7+00	131.3	121.81	9.5	6+99.8								
						4" PVC 40 8+04.3 <sup>top</sup> 9+47.1 <sup>top</sup>		954018-114 91-000045-7		3510 N. Ohio		3-22-95 1-3-92
8+00	132.2	122.01	10.2									
9+00	132.2	122.21	10.0									
10+00	131.8	122.40	9.4									
	132.8	122.50	10.3	10+49.3								
11+00	130.9	122.60	8.3									
12+00	131.1	122.79	8.3									
13+00	131.3	122.99	8.3									
	132.1	123.13	9.0	13+72.7								
		123.30	8.8									
14+00	132.5	123.37	9.1									
15+00	132.7	123.62	9.1									
16+00	132.9	123.87	9.0									
	133.4	124.11	9.3	16+95.5								
17+00	133.3	124.12	9.2									
18+00	133.7	124.37	9.3									
19+00	133.9	124.62	9.3									
20+00	134.0	124.87	9.1									
	134.6	124.91	9.7	20+15.8								
21+00	134.3	125.12	9.2									

CONT'D NEXT PAGE