


3-7-95 - Lot 6
 1220-1230 E 37th
 MHTapokid for Leak Bldg Per
 calvin must core drill
 within 2' of bottom & have
 sewer admit in spec MHT Tap
 IF add 1' work portion of Lot
 MUST extend City Sewer

1106 E 37th N
 Refer to
 Sewer Book
 L-67 and
 L-84 for Conn.
 11/8/92
 BK

3511 Ohio
 DO NOT
 supply
 Sewer Permit
 341-1514
 12-2-92

1970

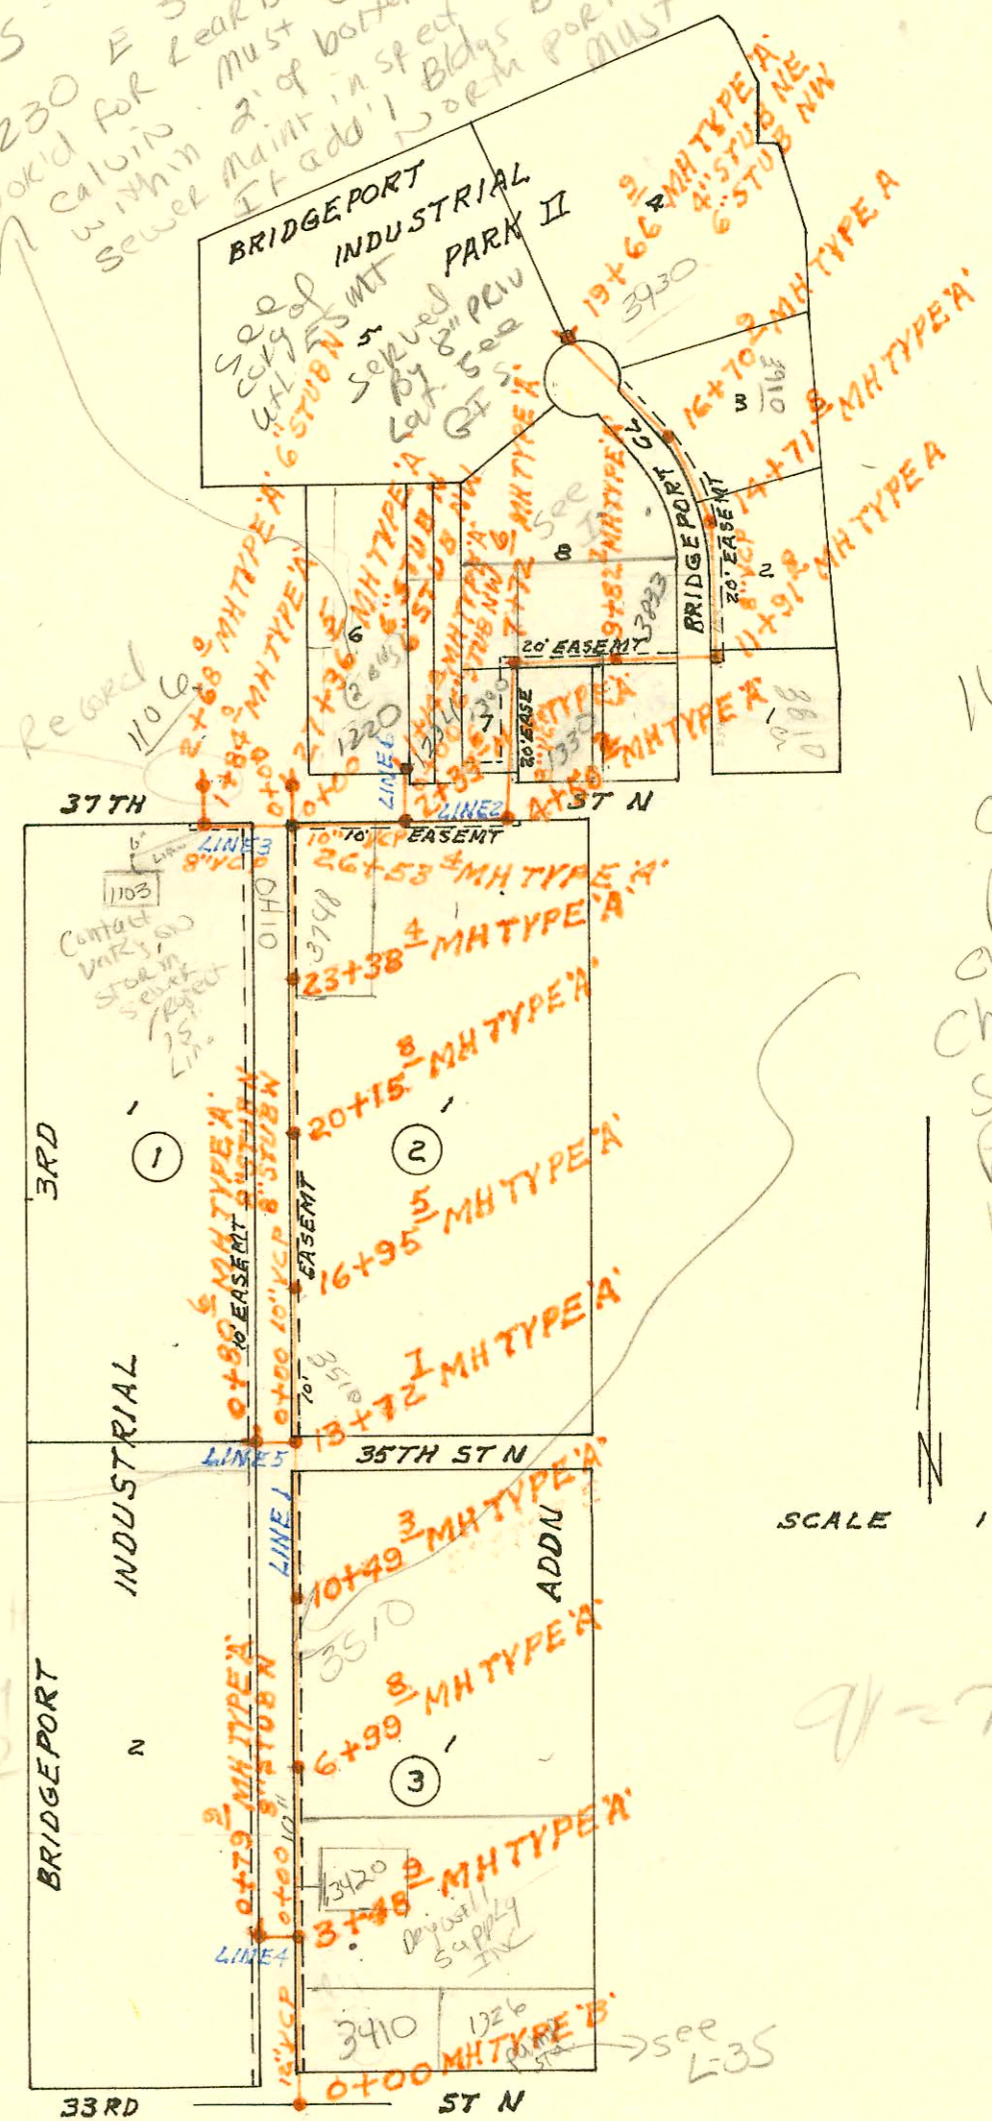

Note
 on Don
 problem
 on main -
 check with
 sewer maint.
 first before
 permit to see
 if a trap
 will be
 beg'd
 12/6/92
 BSR

SCALE 1" = 400'

LATERAL 102 MAIN 4 SAN SEWER N23
 BUILT BY: COLEMAN EXCAVATING CO.
 PROJ. N2 468-76-245-80928-000-000-001
 BOOKED 2-19-81 FROM AG 10

2-6-92
 2-6-92
 F

CONSTRUCTION RECORD

SERVICE RECORD

STATION	ELEVATION		Depth	MANHOLE	4-INCH "Y" BRANCHES		No. of Permit		House Number		DATE OF PERMITS	
	Ground	Grade			North West	South East	North West	South East	North West	South East	North West	South East
LAT 102 MAIN 4 SAN SEWER No 23 (CONT'D)												
LINE 1 CONT'D	22+00	134.4	125.37	9.0								
	23+00	134.8	125.62	9.2								
		135.8	125.71	10.1	23+38.4							
	24+00	135.1	125.87	9.2								
	25+00	135.2	126.12	9.1								
	26+00	135.4	126.37	9.0								
		136.2	126.50	9.7	26+53.4							
	27+00	135.9	126.62	9.3								
		136.2	126.71	9.5	27+36.5	6" STUB N	6" STUB NW					
LINE 2	0+00	136.2	126.61	9.6	0+00 = 26+53.4							
	1+00	135.0	126.85	8.2								
	2+00	135.4	127.09	8.3								
		135.3	127.17	8.1	2+33.6							
	3+00	136.5	127.33	9.2								
	4+00	135.4	127.57	7.8								
		135.7	127.69	8.0								
			127.83	7.9	4+50.2							
	5+00	136.8	127.98	8.8								
	6+00	136.8	128.28	8.5		5+60.2 ^{top}		14368		1330 E		8-1-85
										37TH N		
	7+00	137.1	128.58	8.5		6+95 top		11-382297		1300 E (total cap low)		12-2-91
		137.5	128.80	8.7						37TH N		
			128.90	8.6	7+72.6							
	8+00	137.4	129.01	8.4								
	9+00	137.5	129.41	8.1				10392		3833 N		2-2-84
		138.0	129.74	8.3	9+82.7					Bridgeport		
	10+00	137.7	129.81	7.9								
	11+00	138.5	130.21	8.3								
		138.3	130.58	7.7								
			130.78	7.5	11+91.8							
	12+00	138.0	130.81	7.2		11+97.8 ^{top}		3205		3810		4-28-81
										Bridgeport		
	13+00	138.9	131.21	7.7								
	14+00	140.5	131.61	8.9								
		139.6	131.90	7.7								
			132.10	7.5	14+71.8							
	15+00	140.6	132.21	8.4								
	16+00	141.1	132.61	8.5		15+61.7 ^{top}		2184		3910		12-18-80
		140.3	132.89	7.4						Bridgeport		
			132.99	7.3	16+70.9							
	17+00	141.5	133.11	8.4								
	18+00	141.4	133.51	7.9								
	19+00	141.1	133.91	7.2								
		140.9	134.18	6.7	19+66.9	4" stub - NE	4 PVC 40	90-6519-7		3930 N		5-6-92
										Bridgeport		
LINE 3	0+00	136.2	126.61	9.6	0+00 = 26+53.4							
	1+00	136.4	126.81	9.6								
		135.3	126.98	8.3								
			127.08	8.2	1+84.0							
	2+00	135.3	127.11	8.2								

CONT'D NEXT PAGE

1300 E 37th - Now known as 1234 E 37th owned by Love Box Co (5/28/99)

THE UNIVERSITY OF CHICAGO
LIBRARY

