

LATERAL 20 MAIN 7 SAN SEWER N23
BUILT BY: UTILITY CONTR. INC
PROJ. NO 468-76-245-80837-000-000-001
BOOKED 3-13-81 FROM CG15

211 m21
12-31

29TH ST N

0+00 MH EXISTING

SCALE 1" = 100'

2+29 3" MH TYPE 'C'

8" PVC
4+24 8" MH TYPE 'C'

PEPPERWOOD







FLOODWAY RESERVE
& UTIL EASEMENT

Priv. S.S. Ext. to serve Lot 13 & 14,
Blk 1, Pepperwood Village
PJ # 468-76-245-80000-000-000-008
Built By Triple C
Booked 5-4-81 FROM PLAN

2+94 4" MH TYPE 'C'

5+90 3" MH TYPE 'C'

8+87 2" MH TYPE 'C'

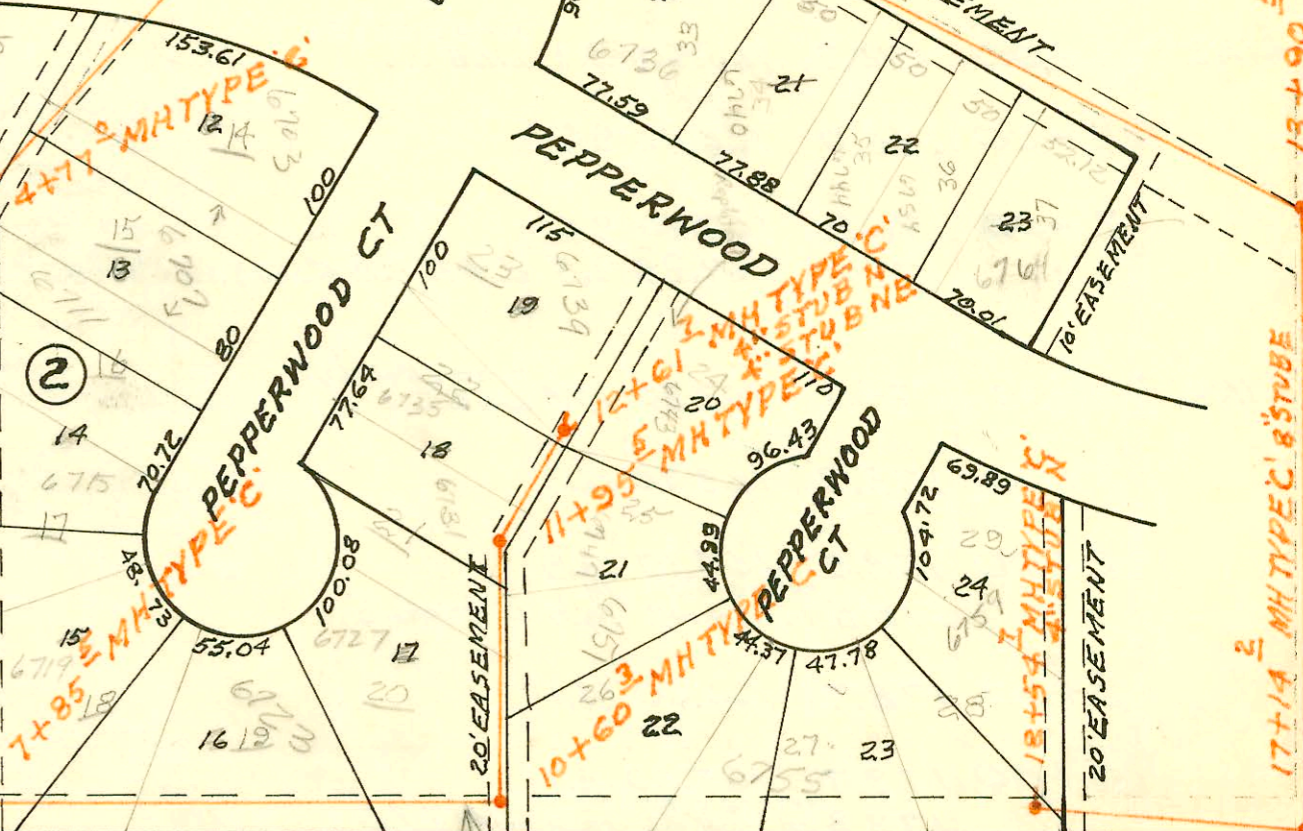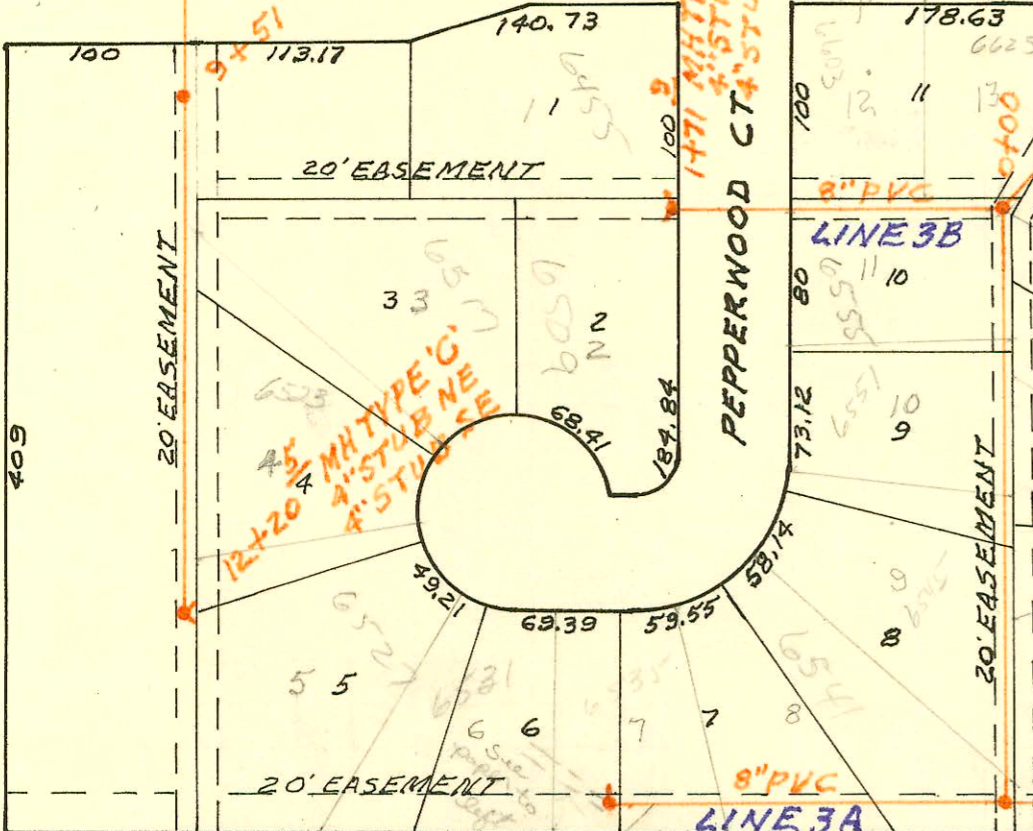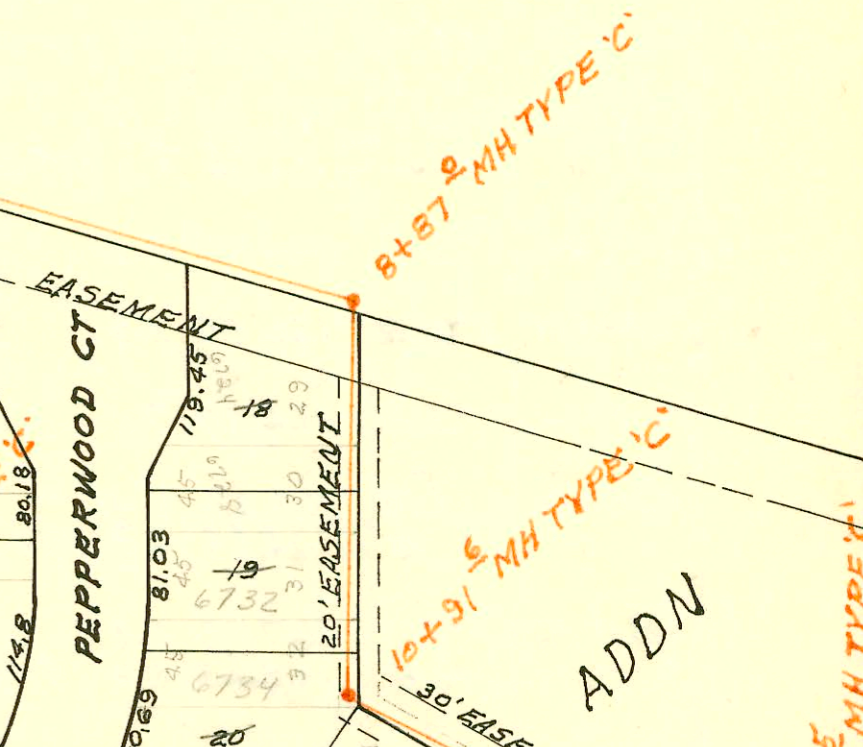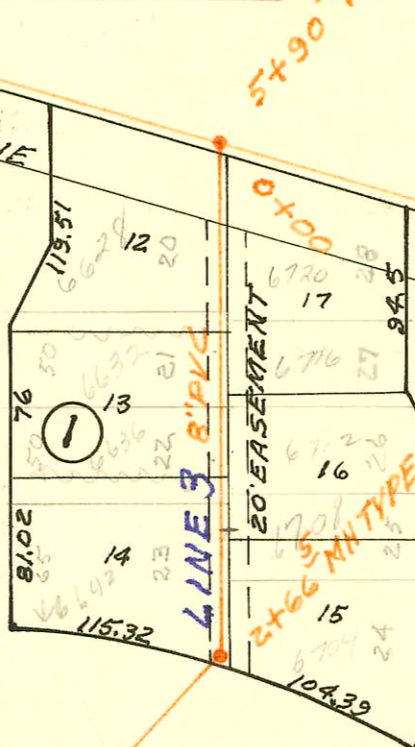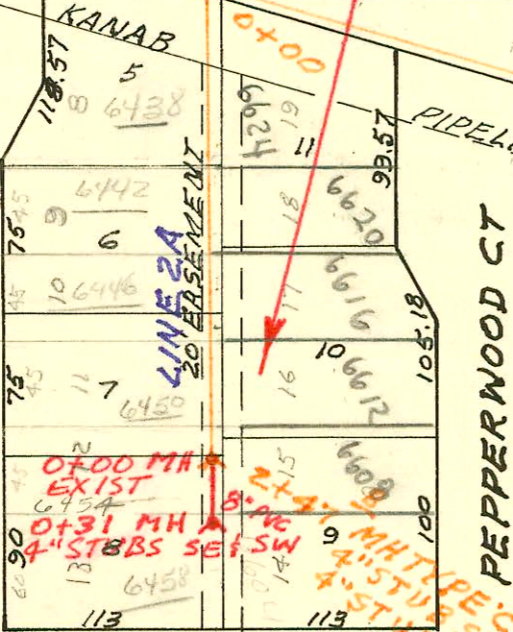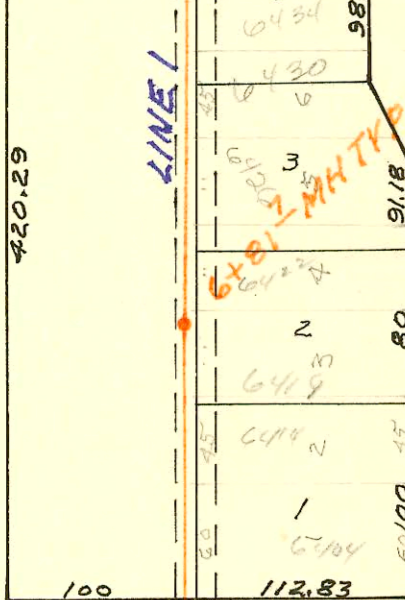

See
PRF 2002-00015
Re 2600 W
Woodlawn
Blk
1-31-02

Replat 13
Pepperwood
Village Addn

CONSTRUCTION RECORD

SERVICE RECORD

STATION	ELEVATION		Depth	MANHOLE	4-INCH "Y" BRANCHES		No. of Permit		House Number		DATE OF PERMITS	
	Ground	Grade			North West	South East	North West	South East	North West	South East	North West	South East
LAT 20 MAIN 7 SS N ^o 23 (CONT'D)												
LINE 2 0+00	177.6	160.23	17.4	0+00=4+24.8 LINE 1								
1+00	176.5	160.63	15.9									
2+00	175.8 174.7	161.03 161.41	14.8 13.3	2+94.1								
3+00	174.6	161.43	13.2									
4+00	174.2	161.83	12.4									
5+00	174.3 174.1	162.23 162.53	12.1 11.5	5+90.3								
6+00	174.1	162.63	11.5									
7+00	174.6	163.03	11.6									
8+00	175.2 172.5	163.43 163.78 163.88	11.8 8.7 8.6	8+87.0								
9+00	173.1	163.93	9.2		9+35 top 9+83 top		13262 13261		6734 6738 6739 6734 6736 6736		3-19-85 3-19-85	
10+00	175.6 176.2	164.33 164.70 164.80	11.3 11.3 11.4	10+91.6	10+32.0 top 10+56.0 top 10+99.1 top		11883 11882 11881		6734 6734 6736		8-28-84 8-28-84 8-28-84	
11+00	176.1	164.83	11.3		11+26.5 top 11+71.6 top		13260 13343		6740 6744 6754		3-19-85 4-23-85	
12+00	173.4	165.23	8.2		12+21.3 top 12+70.5 top		13544 14273		6754 6744		4-23-85 7-18-85	
13+00	175.1 175.6	165.63 165.99 166.09	9.5 9.6 9.5	13+90.5								
14+00	175.6	166.13	9.5									
15+00	176.0	166.53	9.5									
16+00	176.3	166.93	9.4									
17+00	176.7 176.8	167.33 167.39 167.49	9.4 9.4 9.3	17+14.2		8" STUB E 8" STUB S						
18+00	177.1 176.8	167.83 168.05	9.3 8.8	18+54.7	4" STUB N	Rel Inspector in H top	8157	10923	6759 E 6755	6755	5-17-83	5-17-84
LINE 2												
0+00	174.7	165.40	9.3	0+00=2+94.1 LINE 2								
1+00	176.0	166.40	9.6		0+68.0 top 1+16.6 top 1+62.1 top	0+91.0 top 1+34.0 top 1+55.8 top	6354 6355 6356	10199 10200 10198	6438 E 6442 6446 6450	6624 6620 6616 6612	8-17-82 8-17-82 8-17-82	2-13-84 2-13-84 2-13-84
2+00	176.8 177.4	167.40 167.88	9.4 9.5	2+47.8	4" STUB SW 4" STUB SE		6357 6358	10197 10196	6450 6451	6608 6608	8-17-82 8-17-82	2-13-84 2-13-84
LINE 3												
0+00	174.1	163.30	10.8	0+00=5+90.3 LINE 2	0+41.0 top 0+30.6 top		8857	13280	6628 6620	6720	7-29-83	3-21-85
1+00	175.9	163.70	12.2		1+01.5 top 1+60.5 top 2+12.5 top	1+19.5 top 1+67.5 top 1+99.5 top	8332 8333 8324	11150 11151 10774	6632 6636 6642 6708 6704	6716 6712 6712 6712	6-13-83 6-13-83 6-13-83	6-8-84 6-8-84 4-24-84 4-24-84
2+00	178.0 178.5	164.10 164.37 164.47	13.9 14.1 14.0	2+66.5		2+37.5 top		10773		6704 6704		4-24-84
3+00	178.7	164.60	14.1			3+84.0 top		10812		6708		4-27-84
4+00	179.7 179.3	165.00 165.31 165.41	14.7 14.6 13.9	4+77.0	in H Topok		8153	6662	6625 E 6625	6707	5-17-83	10-1-82
5+00	179.4	165.50	13.9		5+97.0 top	5+42.0 top	7464	10813	6551 6551	6711	2-14-83	4-27-84
6+00	180.3	165.90	14.4		6+93.5 top 6+39.6 top		7465	8158	6545 6545	6715	2-14-83	5-17-83

CONT'D NEXT PAGE

