


Country Place Estates Address G276A

SCALE 1" = 200'

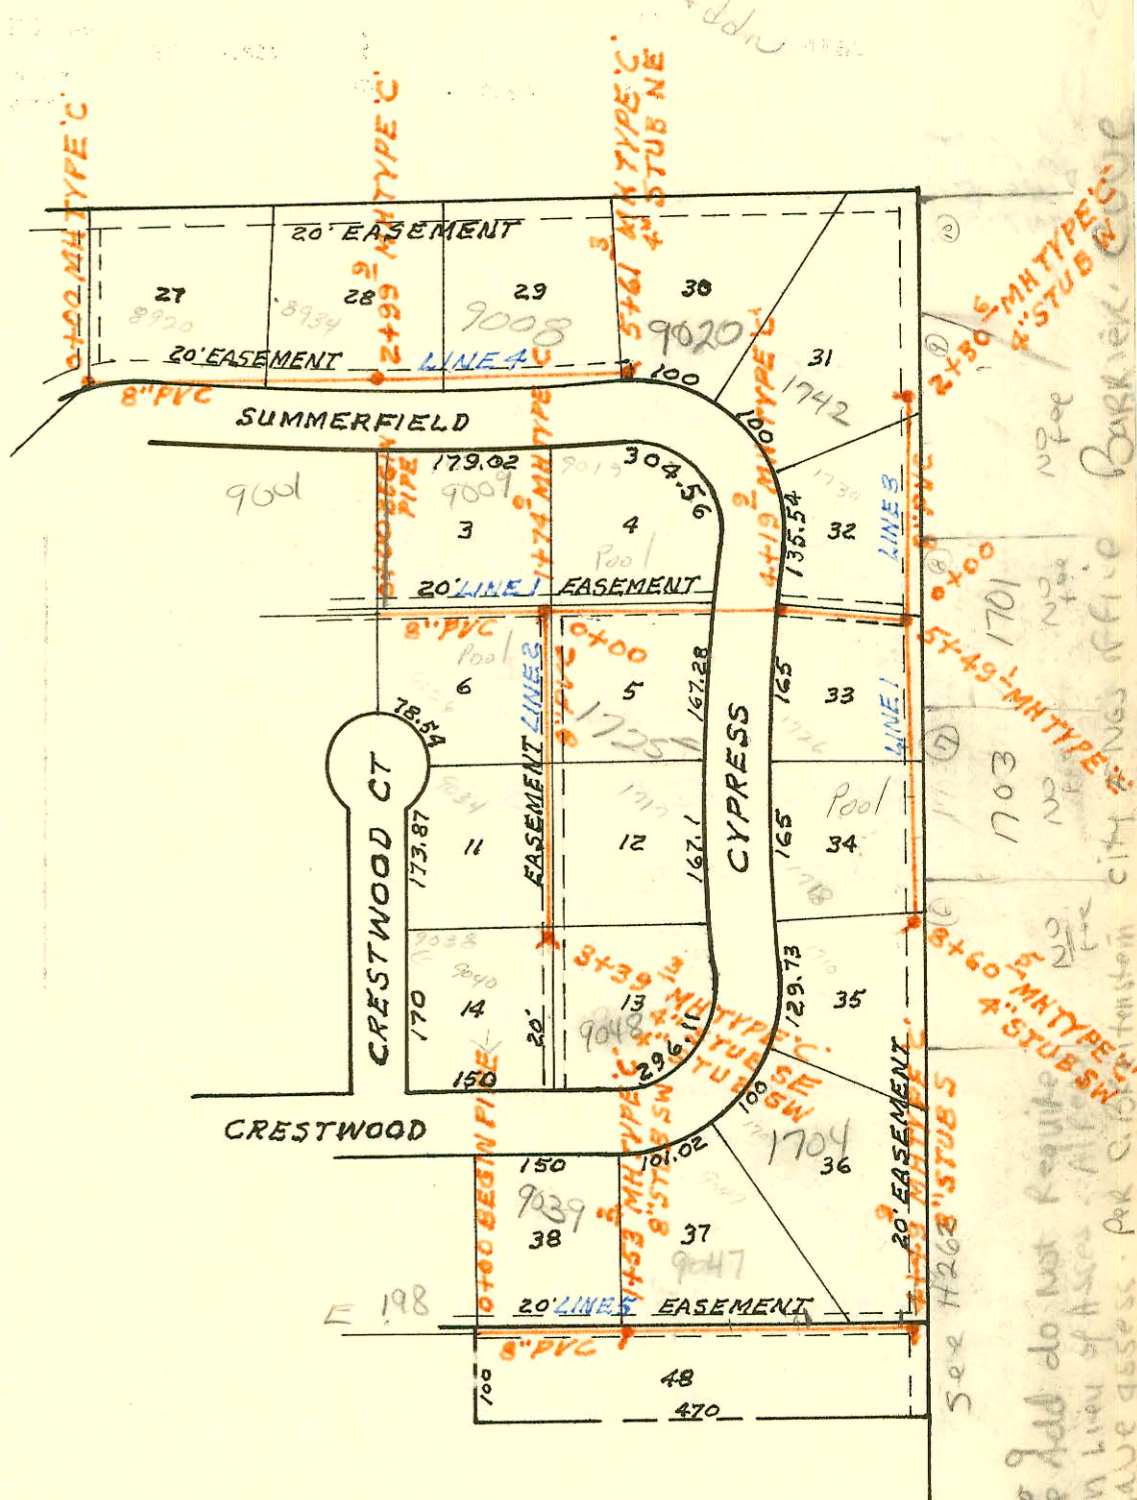

LATERAL 4 MAIN 22 WAR INDUSTRIES SEWER
 BUILT BY: W.B. CARTER CONST. CO.
 PROJ. NO 468-76-245-80717-000-000-001
 BOOKED 3-21-81 FROM DCD 24

on map
 P-13-40

1703 N. Barrier Cove
 fee of 1,925.00 in lieu of
 Lateral asses. pd 81693

Refer to H-251
 This fee collected in
 error for lot 7 - TRANS.
 fee to cover BK1 Lot 2
 of Rollage add. on
 2117194
 BK

1703 Barrier Cove
 1,925.00 pd - not needed
 see Betty R
 8-17-91

See H-251
 BK1
 Note:
 Lots 6 & 9 add do not require
 Rollage add. see Betty R
 Fee in lieu of Lateral
 have asses. per City
 City Eng. Office
 Barker

