


SCALE 1" = 150'



LATERAL B7 SOUTHWEST INTERCEPTOR SEWER
 BUILT BY: MID STATES CONST. CO.
 PROJ. NO 468-76-245-80257-000-000-001
 BOOKED 3-30-81 FROM DRH 15

on map
 4-69

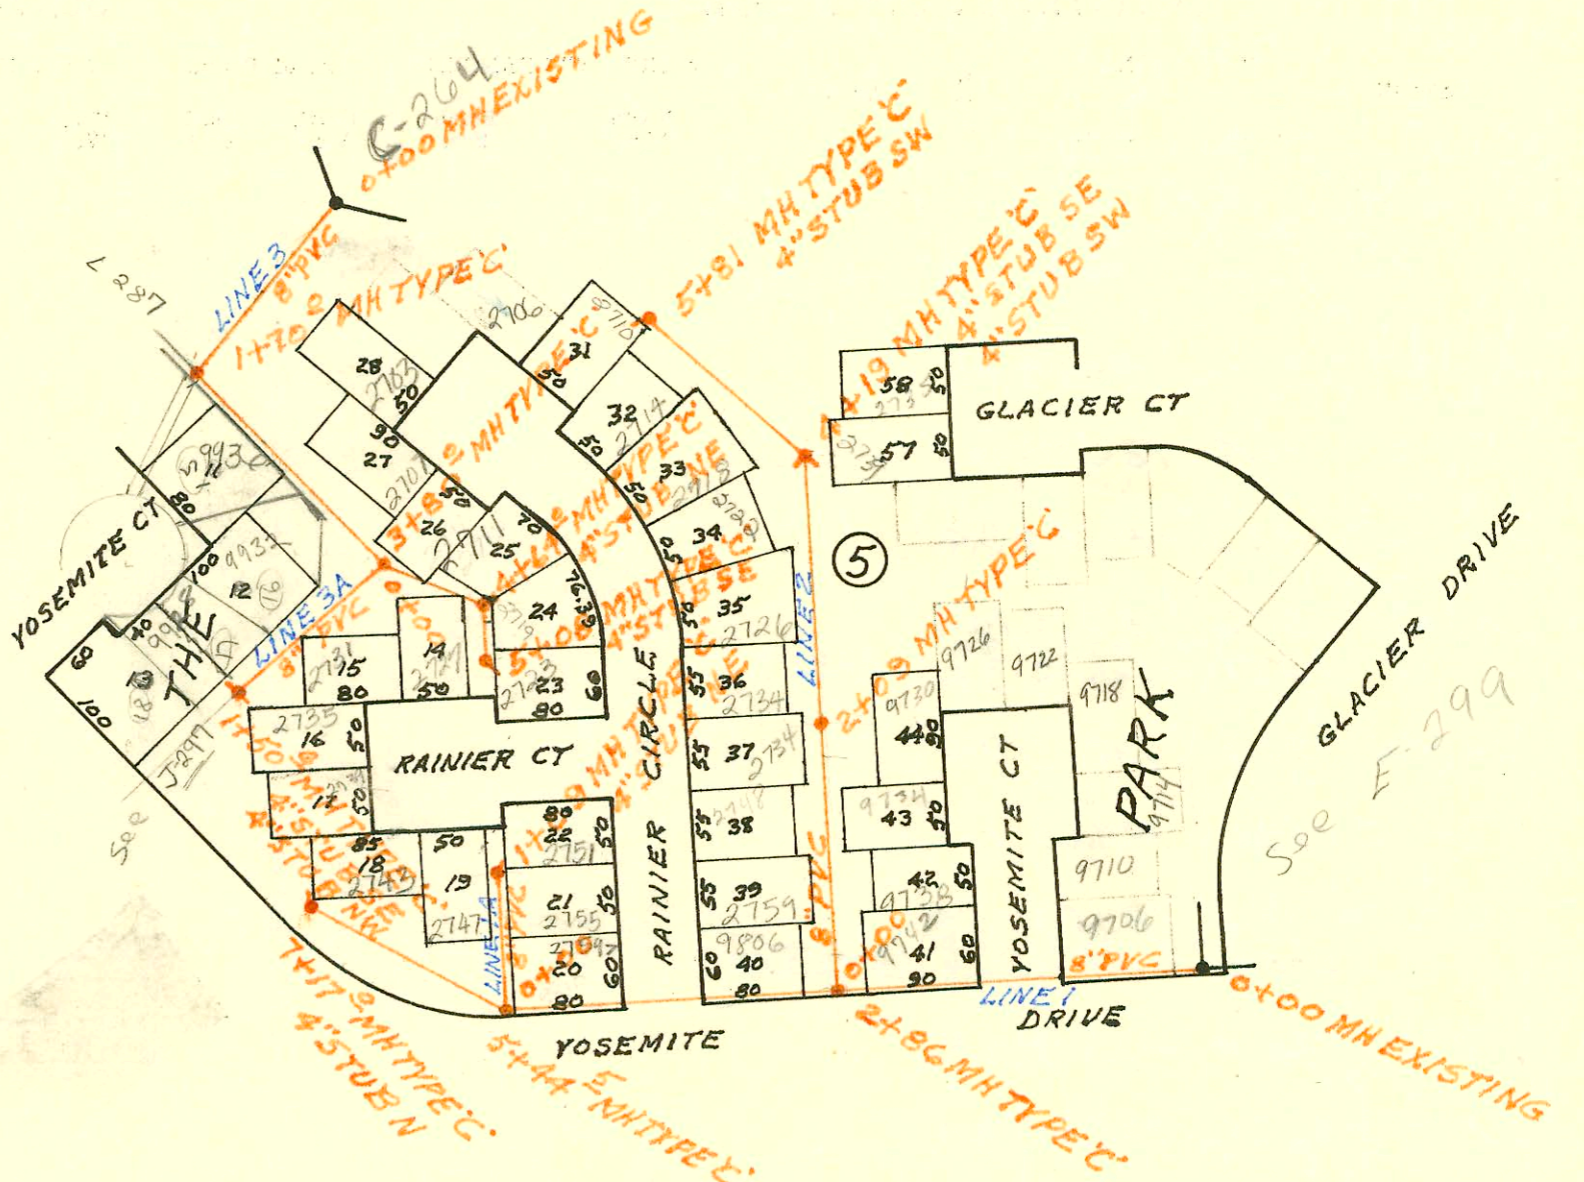