



SCALE 1" = 100'

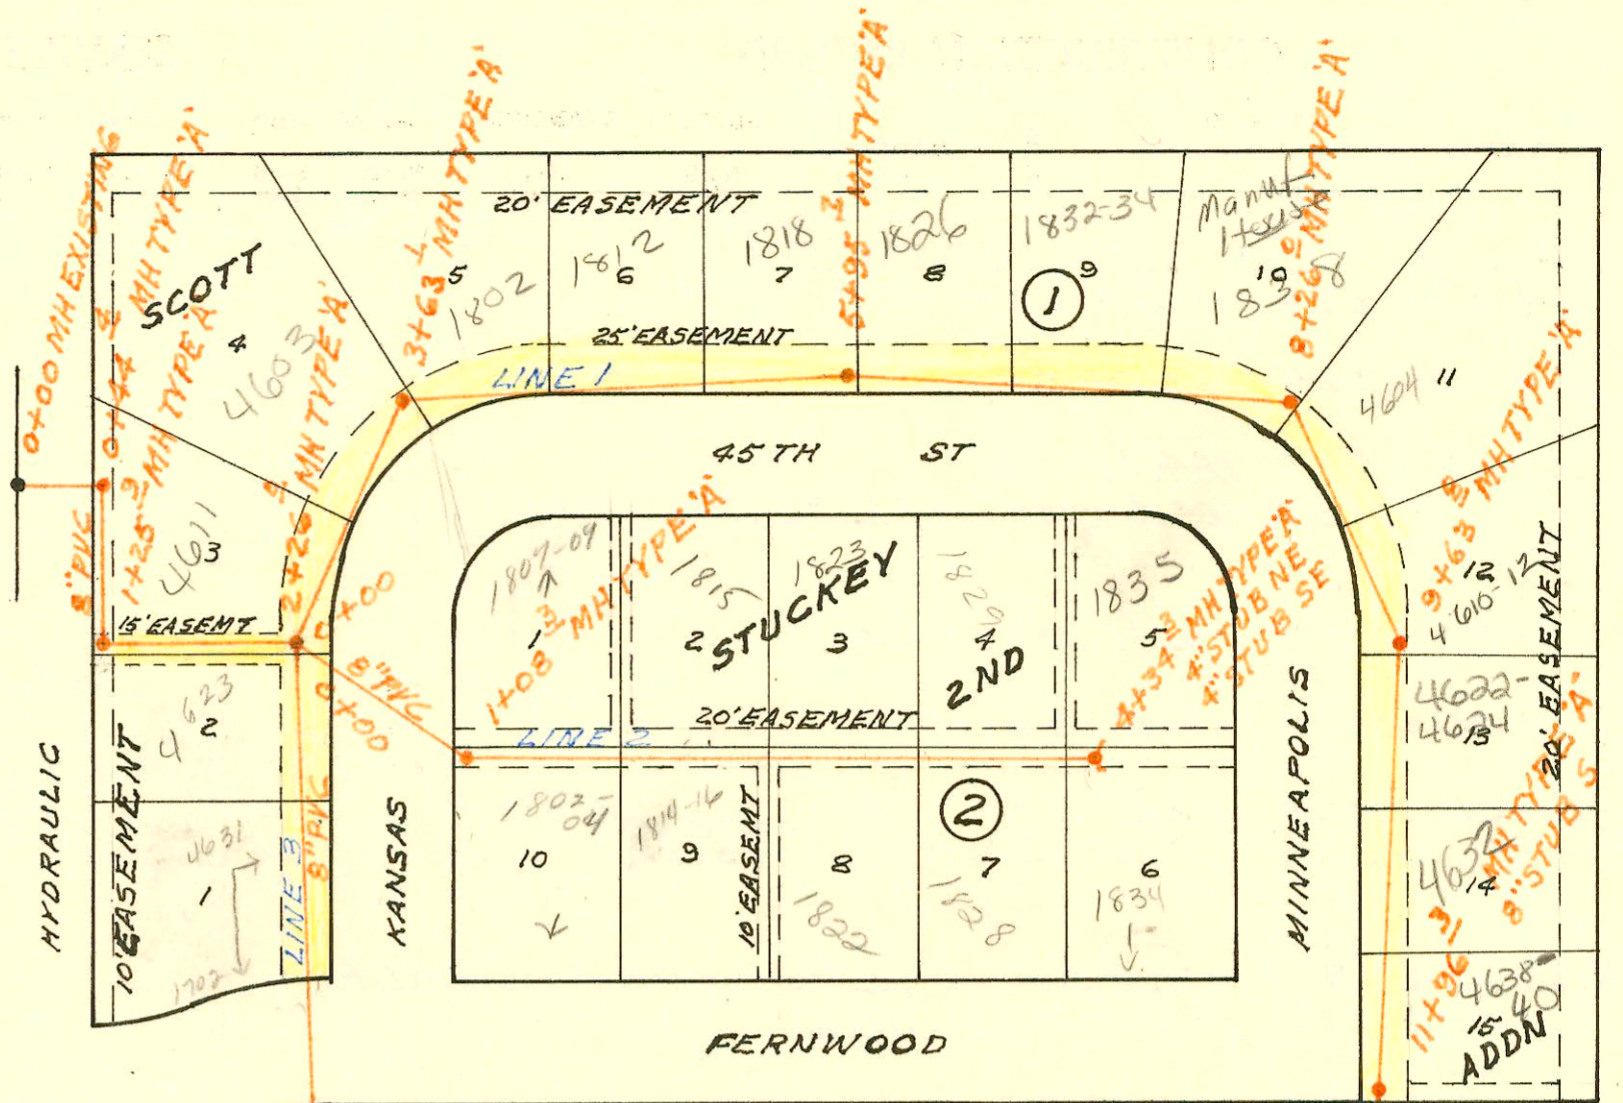

LATERAL 57 MAIN I SOUTHWEST INTERCEPTOR
 BUILT BY: UTILITY CONTR. INC.
 PROJ. NO 468-76-245-80901-000-000-001
 BOOKED 4-29-81 FROM JLA #12

on map

SCALE 1" = 100'

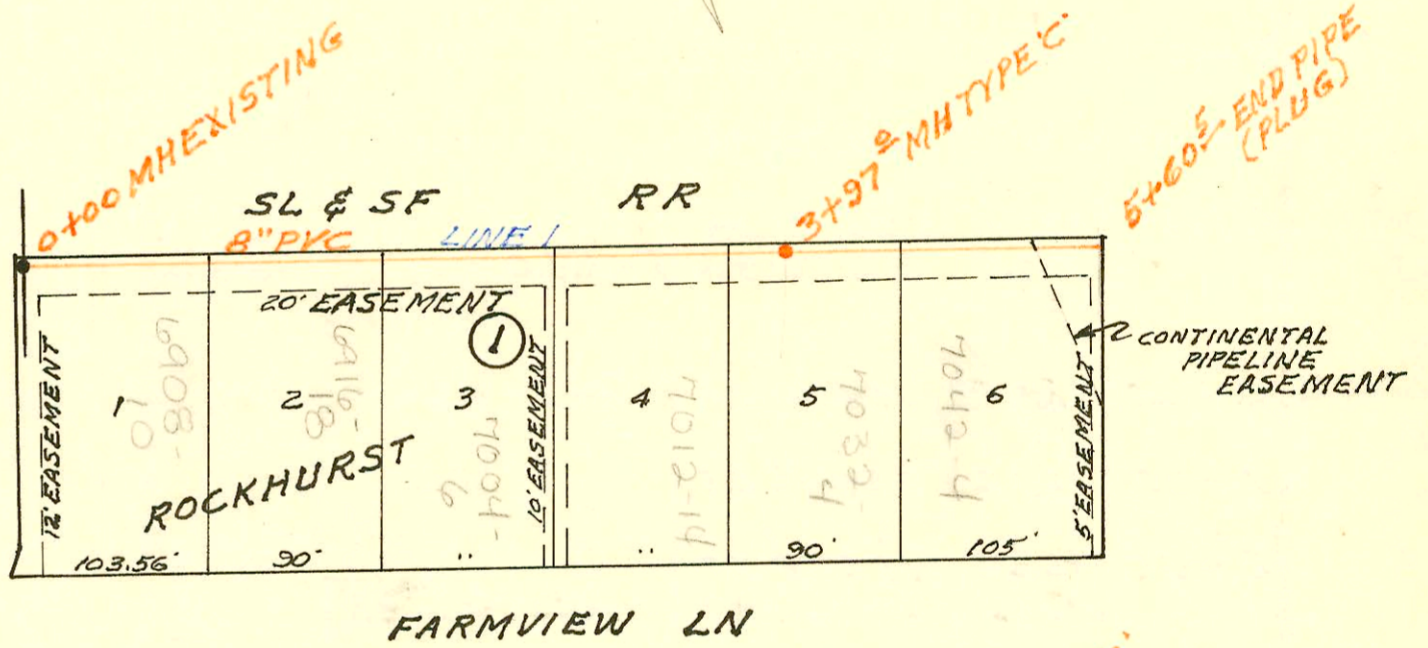

LATERAL 14 MAIN 20 WAR INDUSTRIES SEWER
 BUILT BY: CLEARWATER EXCAV. CO.
 PROJ. NO 468-76-245-80975-000-000-001
 BOOKED 5-2-81 FROM CG22

12-40

CONSTRUCTION RECORD

SERVICE RECORD

STATION	ELEVATION		Depth	MANHOLE	4-INCH "Y" BRANCHES		No. of Permit		House Number		DATE OF PERMITS	
	Ground	Grade			North West	South East	North West	South East	North West	South East	North West	South East
LATERAL 57 MAIN 1 SOUTH WEST INTERCEPTOR												
L1 0+00	83.8	73.00	10.8	EXISTING								
	82.8	OUT 73.19 IN 73.29	9.6 9.5	50+44.4								
1+00	83.0	73.51	9.5									
	82.8	OUT 73.61 IN 73.71	9.2 9.1	1+25.9								
2+00	83.2	74.01	9.2		1+87.9 TAP		18145		4623 S. KANSAS		4-20-87	
	83.1	74.16 74.26	9.0 8.9	2+26.0								
3+00	83.0	74.50	8.5		2+79.1 TAP		18811		4611 S KANSAS		8-3-87	
	83.0	74.75 74.85	8.3 8.2	3+63.1	3+09.1 TAP		18812		4602 S KANSAS		8-3-87	
4+00	83.6	75.00	8.5		4+37.7 TAP		21120		1802 E. 45th		7-20-88	
5+00	84.2	75.40	8.8		5+07.7 TAP		21121		1812 E. 45th		7-20-88	
	82.9	75.78	7.1	5+95.7	5+86.0 TAP		22875		1818 E. 45th		4-6-89	
6+00	82.9	75.80	7.1		6+41.7 TAP		21496		1826 E. 45th		9-19-88	
7+00	82.8	76.20	6.6		4" SCH 40 7+47.7		2050 2353		1832-34 E. 45th		10-27-00	
8+00	83.8	76.60	7.2				97-60981		1838 E. 45th		10-28-99	
	83.8	OUT 76.70 IN 76.80	7.1 7.0	8+26.0								
9+00	84.1	77.10	7.0		8+78.8 Tap		14840		4604 S. Minneapolis		10-15-85	
	84.0	OUT 77.36 IN 77.46	6.6 6.5	9+63.8	9+55.8 Tap		2000- 02352 2002 00416		4610-12 Minneapolis 4622-24 Minneapolis		10-27-00 2-14-02	
10+00	84.0	77.60	6.4									
11+00	84.2	78.00	6.2		4" SCH 40 PVC 11+90.3 Saddle		2051 01787		4638- 4640 minneapolis		7-18-01	
	84.0	78.39	5.6	11+96.3	8" STUB S							
LINE 2												
0+00	83.1	75.00	8.1	0+00=2+26 LINE 1								
1+00	83.4	75.40	8.0				9039	9040	1807-9 E. 45th S	1802-4 E FERNWOOD	8-22-83	8-22-83
	83.4	OUT 75.43 IN 75.53	8.0 7.9	1+08.3	1+69.3 Tap	1+72.3 Tap						
2+00	83.7	75.90	7.8		2+21.3 Tap	2+27.3 Tap	16679	10555	1815 E 45th S	1814-16 FERNWOOD	7-24-86	4-4-84
3+00	83.2	76.30	6.9		3+11.3 Tap	3+5.3 Tap	18813	14402	1823 E 45th	1822 FERNWOOD	8-3-87	8-8-85
					3+97.3 Tap			15423		1828 FERNWOOD		1-8-86
4+00	83.7	76.70	7.0		4+05.3 Tap		16588		1829 E. 45th S		7-10-86	
	83.5	76.84	6.7	4+34.3	4" STUB NE	4" STUB SE	22863	17439	1834 E 45th S	1834 E FERNWOOD	4-6-89	12-12-86
LINE 3												
0+00	83.1	74.20	8.9	0+00=2+26 LINE 1								
1+00	84.0	74.60	9.4		0+91.7 Tap		7835		4631 FERNWOOD		4-13-83	
2+00	84.2	75.00	9.2									
	84.2	75.18	9.0	2+45.8	8" STUB SW	8" STUB E						
LATERAL 14 MAIN 20 WAR INDUSTRIES SEWER												
L1 0+00	192.7	182.67	10.0	EXISTING								
1+00	194.1	184.37	9.7							6916 FARMVIEW		4-16-81
2+00	195.9	186.07	9.8							6918 FARMVIEW		4-16-81
										7004 FARMVIEW		4-16-81
3+00	198.7	187.77	10.9							7006 FARMVIEW		4-16-81
	200.4	189.42	11.0	3+97.0						7012 FARMVIEW		4-16-81
4+00	200.5	189.47	11.0							7014 FARMVIEW		4-16-81
										7032 FARMVIEW		4-16-81
5+00	202.6	191.17	11.4							7034 FARMVIEW		4-16-81
										7042 FARMVIEW		4-16-81
5+60.5	204.5	192.20	12.3	PLUG						7044 FARMVIEW		4-16-81

CONT'D NEXT PAGE