



LATERAL 63 WAR INDUSTRIES SEWER
 BUILT BY: WB CARTER CONST. CO.
 PROJ. N^o 468-76-245-80866-000-000-001
 BOOKED 5-16-81 FROM TCD 36
 (SEE G291 FOR DATA)

on map

G291A

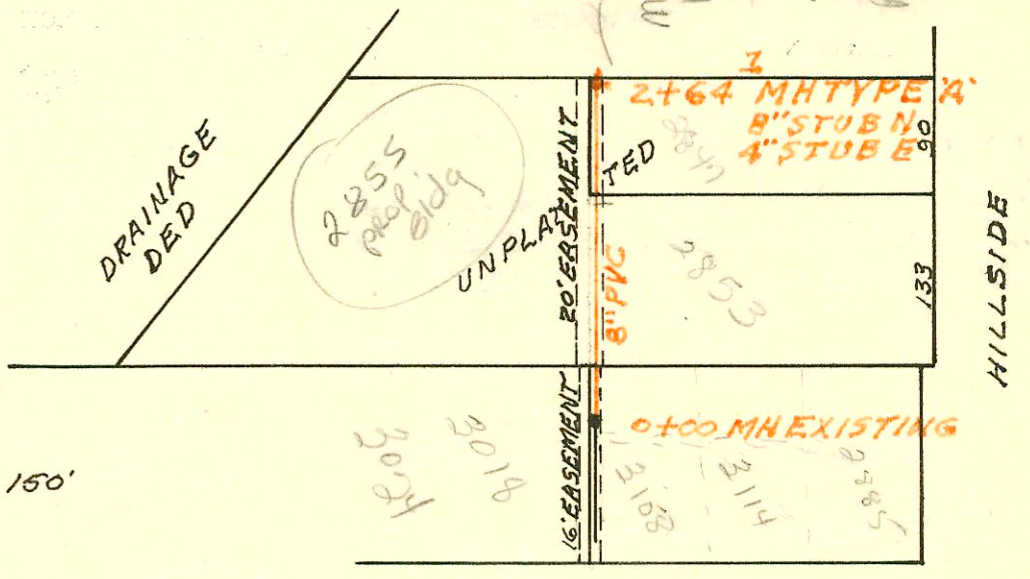

SCALE 1" = 150'

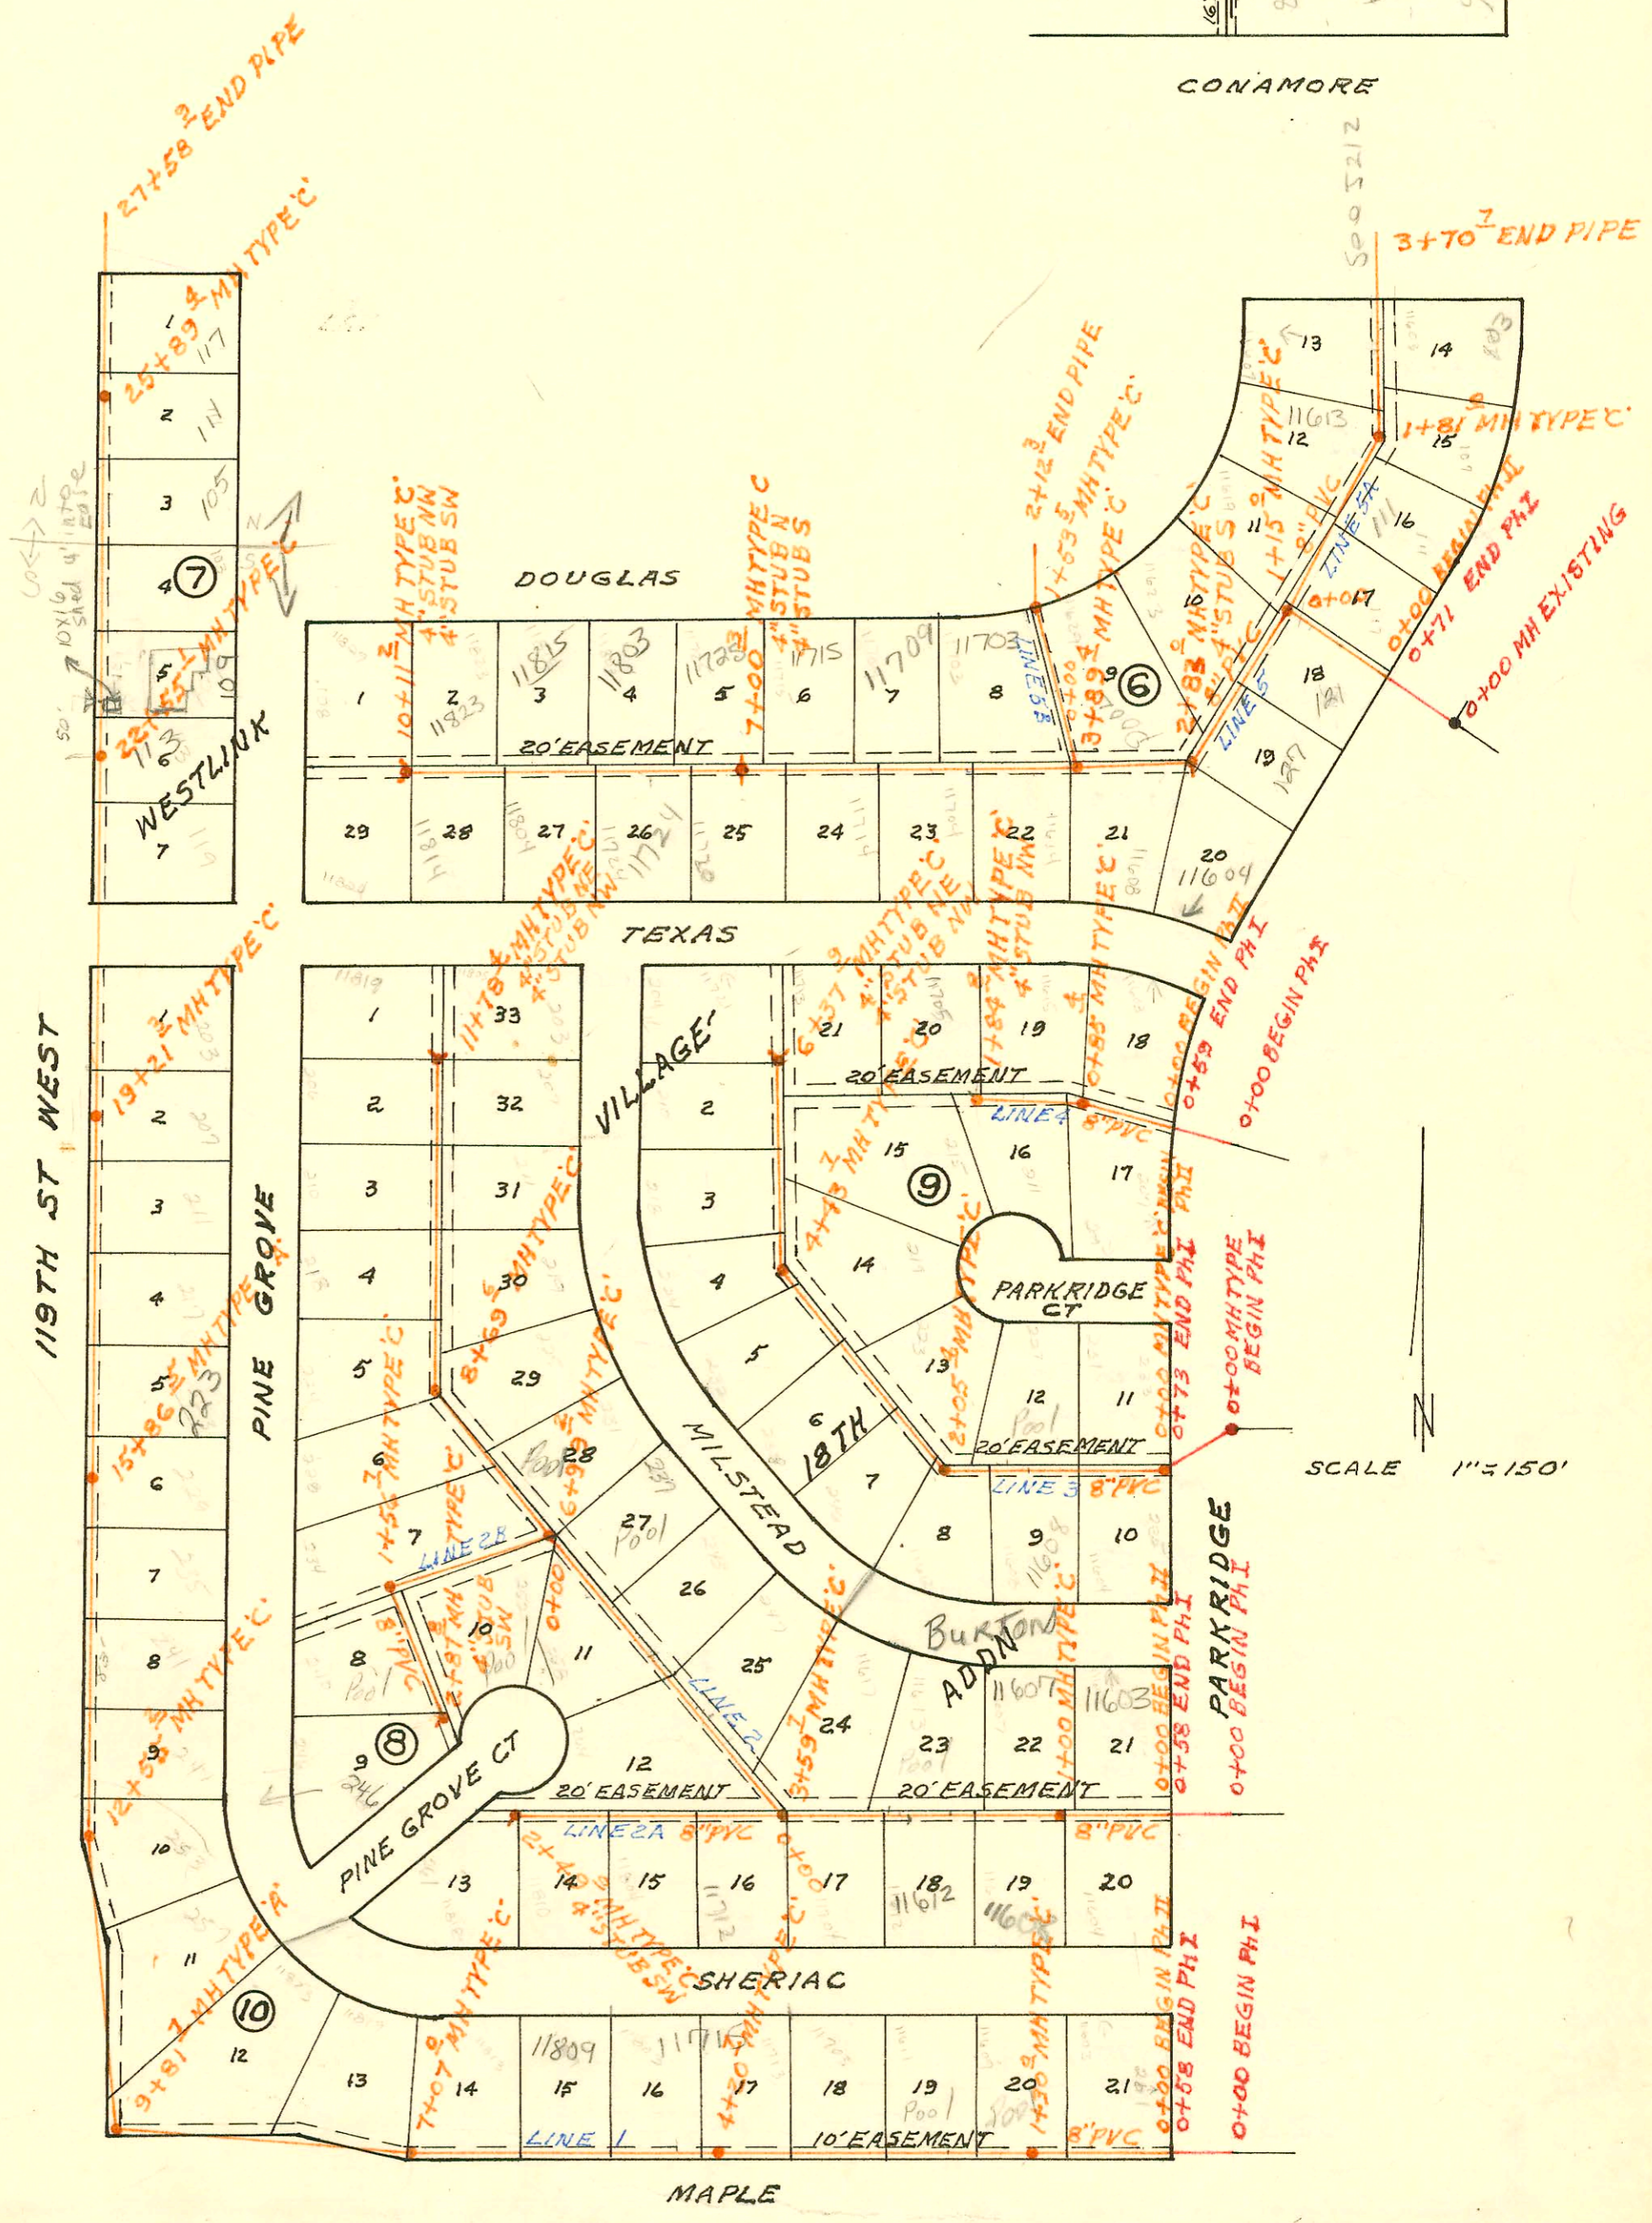

SCALE 1" = 150'

LATERAL 3 MAIN 9 SOUTHWEST INTERCEPTOR
 BUILT BY: DULING CONST. CO (PHASE II)
 PROJ. N^o 468-76-245-80641-000-000-001
 BOOKED 5-21-81 FROM LES 16
 (PHASE I) BUILT BY: MID STATES CONST. CO.

G291A

on map

CONSTRUCTION RECORD

SERVICE RECORD

STATION	ELEVATION		Depth	MANHOLE	4-INCH "Y" BRANCHES		No. of Permit		House Number		DATE OF PERMITS	
	Ground	Grade			North West	South East	North West	South East	North West	South East	North West	South East
LAT 3 MAIN 9 SWI (CONT'D)												
LINE 2	0+00	150.6	142.39	8.2								
PH I	0+58	150.6	142.55	8.1								
PH II	0+00	150.6	142.55	8.1				15493	15492	11603	11604	1-22-86
	1+00	151.8	142.95 143.02	8.9 8.8	1+00.0	1+12.0	0+69.0 1+27.0	23460	13066	11607	11608	6-30-89
	2+00	152.4	143.32	9.1		2+06.6	2+41.0 2+93.0	8022	8505	11613	11612	5-3-83
	3+00	153.0	143.62 143.80 143.90	9.4 9.5 9.4	3+59.7	3+04.7		8458		11617	11704	6-21-83
	4+00	153.6	144.02	9.6			4+49.2		9026		247 S	8-19-83
	5+00	154.5	144.32	10.2								
	6+00	154.5	144.62 144.92	9.9 9.3	6+99.2	6+16.4	6+12.0 6+35.2	8788	9061	258	243	7-28-81
	7+00	154.3	144.92	9.4			7+24.2		9304		231 S	9-27-83
	8+00	153.8	145.22 145.45 145.53	8.6 7.8 7.7	8+69.6	8+06.2	8+15.0 8+83.6	8084	13899	228	225 S	5-5-83
	9+00	153.0	145.62	7.4			9+44.4	6885		224 S	219 S	10-28-82
	10+00	153.2	145.92	7.3		10+28.4		7359	12230	218	217	1-13-83
	11+00	153.6	146.22 146.46	7.4 7.2	11+78.4	11+15.4	11+41.9	11695	12474	210	211	8-9-83
								11788	13347	206	207	8-6-84
										11819	203	8-13-84
LINE 2A	0+00	153.3	143.80	9.5	0+00=3+59.7 LINE 2		0+20.0	8459		11712	W	6-21-83
	1+00	153.5	144.40				1+04.0	10237		11804	Sherrill	2-16-84
	2+00	153.7	145.00 145.29	8.21	2+49.0		1+78.5	10995		11810	Sherrill	5-23-84
									14040	11818	Sherrill	6-20-85
LINE 2B	0+00	154.2	145.02		0+00=6+99.2 LINE 2							
	1+00	154.2	145.52 145.80 145.90	9.1	1+56.7		1+21.5	16838	#3810	234 S	252 S	8-15-86
	2+00	153.9	146.12 146.56	7.78 7.48	2+87.8		2+54.2	8085		340	346	5-5-83
								21560		246	Pine Grove	9-26-88
LINE 3	0+00	150.4	141.35	9.1	0+00=EXISTING							
PH I	0+73	151.1	141.65	9.4	0+73							
PH II	0+00	151.1	141.75	9.4	0+00	0+48.75	0+27.0	14411	13533	231	11604	8-8-85
	1+00	152.2	142.05			1+43.6	0+99.0	11417		11608	11609	7-11-84
	2+00	153.4	142.35 142.37	11.05	2+05.4	2+18.8	1+69.0	14559		227	11612	9-22-85
	3+00	154.7	142.75	11.94		3+42.4	3+07.9	1913	5370	238 S	223 S	12-14-81
	4+00	155.2	143.05 143.18 143.28	11.92	4+43.7	4+52.7	4+01.7	4912	5369	232 S	219 S	12-14-81
	5+00	155.2	143.45	11.75		5+00.3	5+34.4	4910		229 S	215 S	12-14-81
	6+00	155.3	143.75 143.86	11.55 11.54	6+37.9	4'STUB NW	4'STUB NE	4394	5368	210	210	10-23-81
								12440	17050	204	11713	11-2-84
LINE 4	0+00	151.6	140.34	11.3								
PH I	0+59	152.1	140.77	11.3								
PH II	0+00	152.1	140.77	11.3	0+85.4	0+67.4		6687		11603	W	10-5-82

CONT'D NEXT PAGE

Faint, illegible text at the top of the page, possibly bleed-through from the reverse side.

