


LATERAL 228 MAIN 5 SAN SEWER N^o22
BUILT BY: MID STATES CONST. CO.
PROJ. N^o 468-76-245-80808-000-000-001
BOOKED 5-30-81 FROM LES 10

on map 7-43


SCALE 1" = 150'

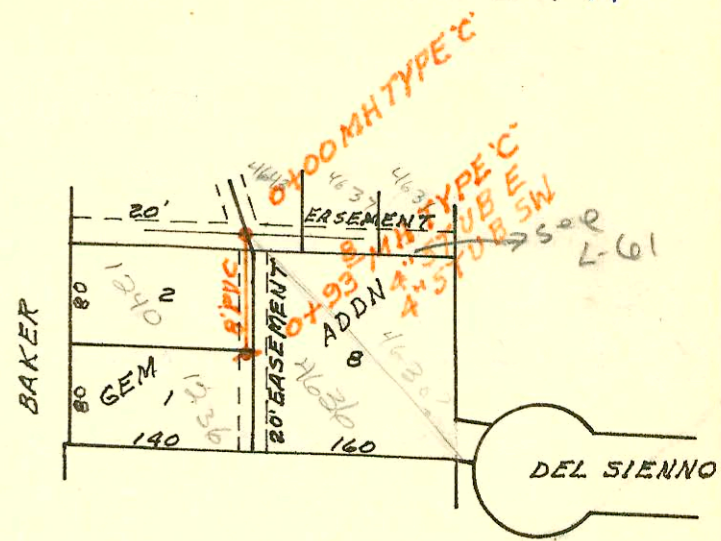

Lots 30-31-32
RELATED TO

BLK 1

36-37-38-39
SADDLE WOOD

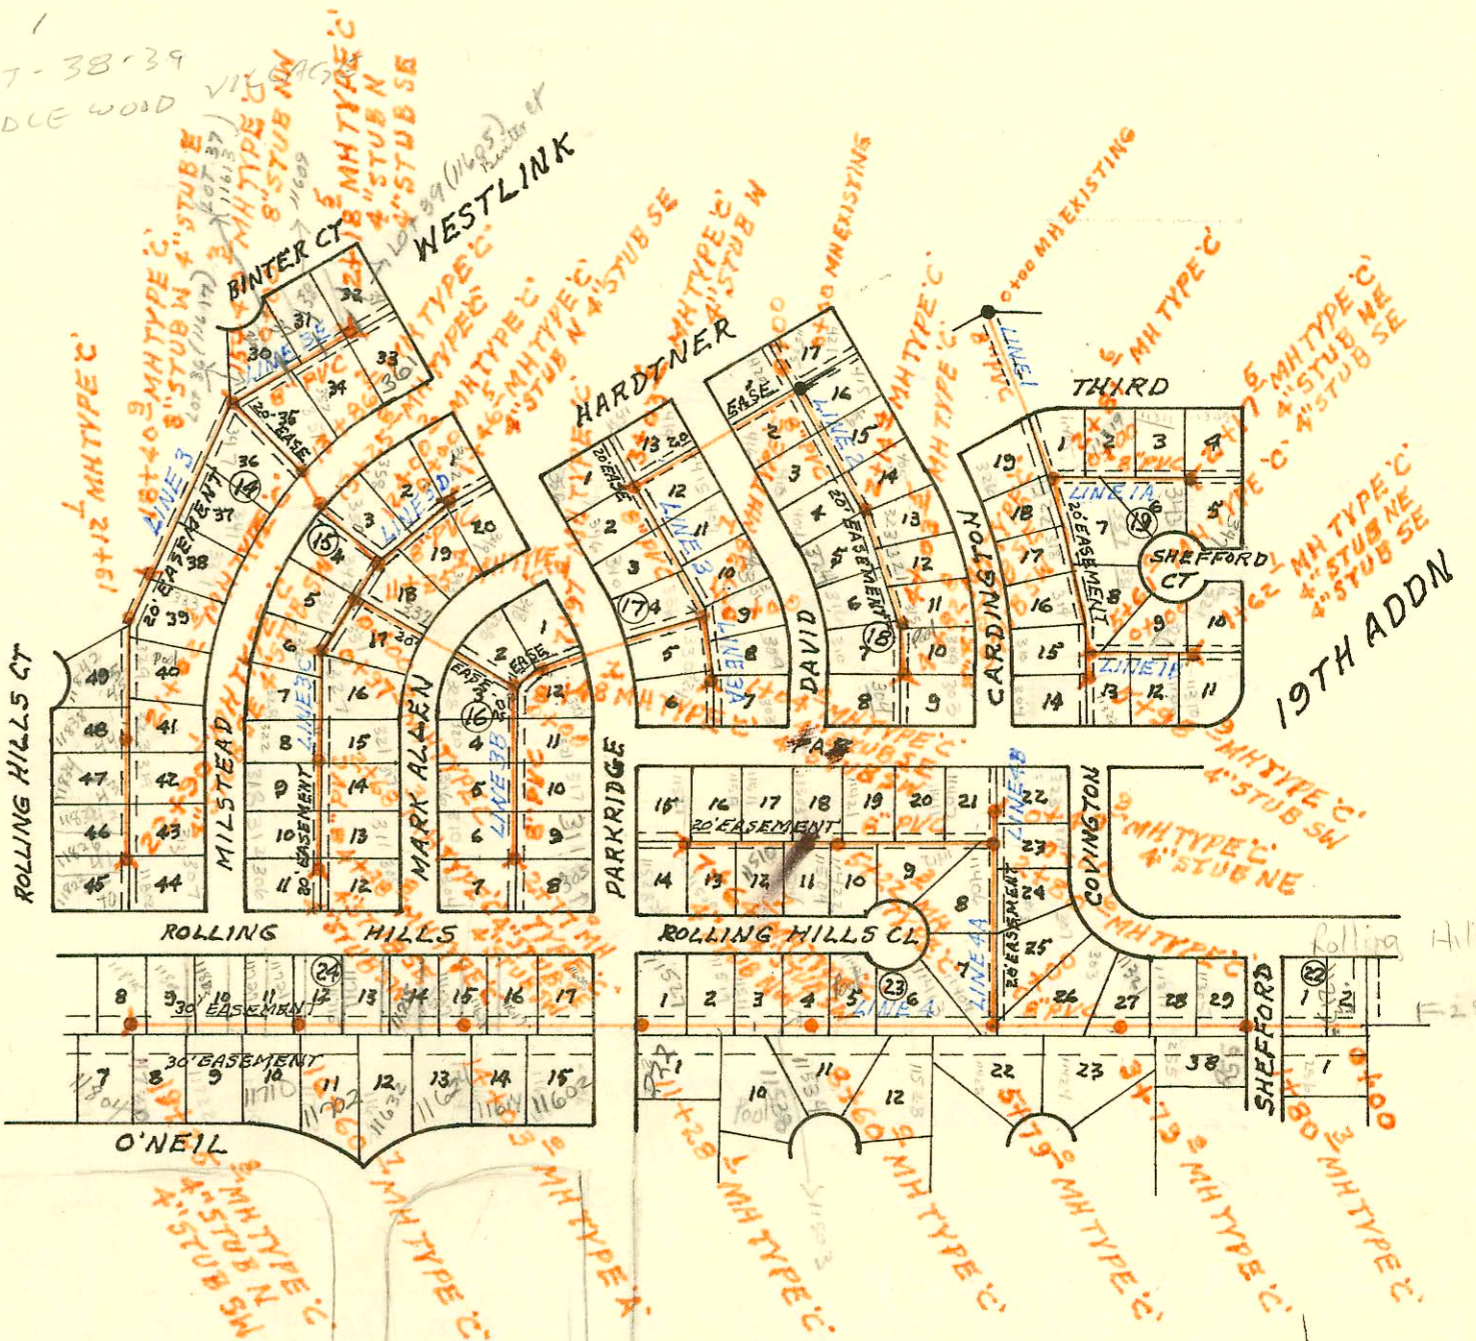

SCALE 1" = 300'

LATERAL 5 MAIN 10 SOUTHWEST INTERCEPTOR SEWER
BUILT BY: MID STATES CONST. CO.
PROJ. N^o 468-76-245-80721-000-000-001
BOOKED 6-4-81 FROM LES 10

on map 4-49

CONSTRUCTION RECORD

SERVICE RECORD

STATION	ELEVATION		Depth	MANHOLE	4-INCH "Y" BRANCHES		No. of Permit		House Number		DATE OF PERMITS	
	Ground	Grade			North West	South East	North West	South East	North West	South East	North West	South East
LAT 5 MAIN 10 SWI (CONT'D)												
LINE 1B 0+00	153.7	144.53	9.2	0+00 = 5+61 LINE 1	0+23.6 tag		4459		327 N Shifford St	11322 Fair		10-28-81
1+00	153.3	144.93	8.4		0+89.1 tag		3248				56-81	
	153.0	145.18	7.8	1+62.1	4" STUB NE	4" STUB SE	4099	4457	321 N Shifford St	11316 11310 Paru	9-10-81	10-28-81 10-28-81
LINE 2 0+00	153.8	143.87	9.9	0+00 EXISTING	0+24.6 tag	0+13.0 tag	2970	4815	416 N David	415 N Cardington	3-27-81	11-30-81
1+00	153.5	144.27	9.2		1+11.4 tag	1+09.4 tag	4256	5145	410 N David	409 N Cardington	10-6-81	2-1-82
	153.0	144.67	8.3		1+84.8 tag	1+64.4 tag	8503	7582	409 N David	405 N Cardington	6-24-83	3-3-83
	153.0	144.73	8.3									
	153.0	144.83	8.2	2+14.4	2+52.4 tag	2+56.5 tag	9247	44396	324 N David	323 N Cardington	9-22-83	10-23-81
						2+93.5 tag		7584		321 Cardington		3-3-83
3+00	153.6	145.17	8.4									
					3+63.0 tag	3+56.9 tag	5006	7583	316 N David	315 N Cardington	1-5-82	3-3-83
4+00	153.3	145.57	7.7									
	153.3	145.58	7.7	4+03.5	4+38.5 tag		5005		310 N David		1-5-82	
		145.70	7.6									
	153.7	146.02	7.7	4+82.8	4" STUB SW	4" STUB SE	3249	5313	304 N David	309 N Cardington	5-6-81	7-7-81 3-8-82
LINE 3 0+00	153.8	137.30	16.5	0+00 EXISTING	0+38.0 tag							
1+00	154.1	137.60	16.5				986		420 N David		8-14-80	
2+00	154.7	137.90	16.8									
					2+66.0 tag		4310		419 N David		10-12-81	
3+00	154.2	138.20	16.0									
	154.2	138.21	16.0	3+03.6	4" STUB W	3+40.1 tag	5581	6063	356 N David	415 David	4-9-82	6-28-82
		138.31	15.9		3+61.6 tag		3839		346 N David		8-5-81	
4+00	154.2	138.60	15.6		4+12.1 tag	4+05.6 tag	8410	9138	340 N David	409 David	6-20-83	9-7-83
						4+79.6 tag		9137		403 David		9-7-83
5+00	154.1	138.90	15.2									
	154.1	139.00	15.7	5+34.7	4" STUB NW		8409		326 Parkridge		6-20-83	
		139.10	15.0									
6+00	154.3	139.30	15.0									
7+00	155.0	139.60	15.4									
	155.9	139.89	16.0	7+97.0	with tap ok		8613		348 mt. allen		7-5-82	
		139.99	15.9									
8+00	155.9	140.00	15.9									
	155.9	140.15	15.8	8+48.7								
		140.25	15.7									
					8+71.7 tag		5531		338 Mark Allen		4-2-82	
9+00	156.2	140.40	15.8									
10+00	156.1	140.70	15.4									
11+00	156.7	141.00	15.7									
	156.7	141.11	15.6	11+35.7								
		141.21	15.5									
12+00	156.7	141.40	15.3				5100		342 mistral		1-22-82	
		141.50	15.2	12+00.2								
13+00	156.5	141.80	14.7									
	156.6	141.88	14.7	13+25.8								
		141.98	14.6									
	156.6	142.16	14.4	13+86.2								
		142.26	14.3									
14+00	156.7	142.30	14.4									
15+00	156.7	142.60	14.1									
	156.7	142.72	14.0	15+40.3	8" STUB NW							
		142.82	13.9									
					15+70 tag							
					4" RISER E		8491		347 N M.L. Stone		6-23-83	
16+00	157.2	143.00	14.2		16+58 tag		9135		341 mistral		9-7-83	
					4" RISER E							
17+00	158.5	143.30	15.2									
					17+50 tag							
					4" RISER E		10372		337 N mistral		3-2-84	
18+00	159.3	143.60	15.7									
	159.6	143.72	15.9	18+40.9	8" STUB W							
		143.81	14.3		4" STUB E							
19+00	159.9	145.61	14.3									
	159.9	145.67	14.2	19+12.1	19+50 tag		10710		323 N mistral		4-17-84	
		145.77	14.1		4" RISER W							
					19+72.7 tag		15499	10630	329 N mistral		1-22-86	4-16-84

Drain Line 3
 Layer Sand
 25' deep
 Between
 0+00 to
 5+34.7
 John
 Mills

(CONT'D NEXT PAGE)