



LATERAL 30 MAIN 3 SOUTHWEST INTERCEPTOR
BUILT BY: UTILITY CONTR. INC.
PROJ. NO 468-76-245-80745-000-000-001
BOOKED 6-6-81 FROM MRT 24

on map
00.8
09.0
09.0

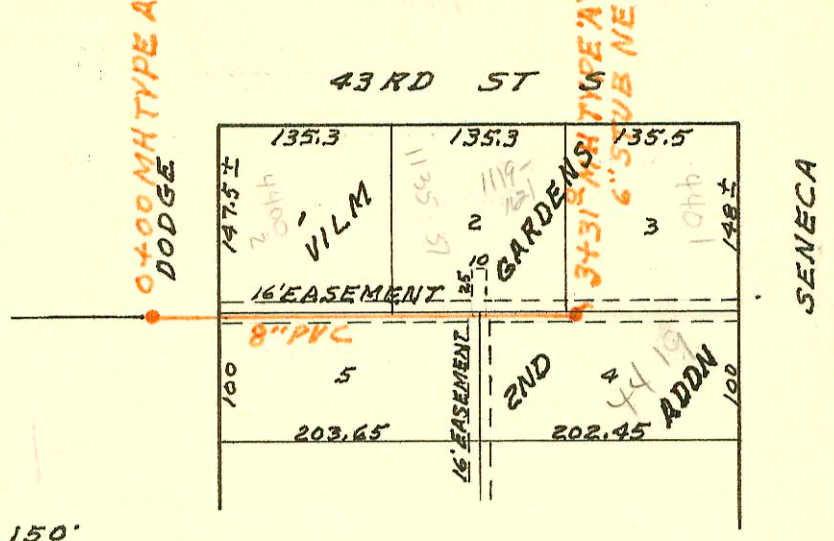

SCALE 1" = 150'

SUR I 248

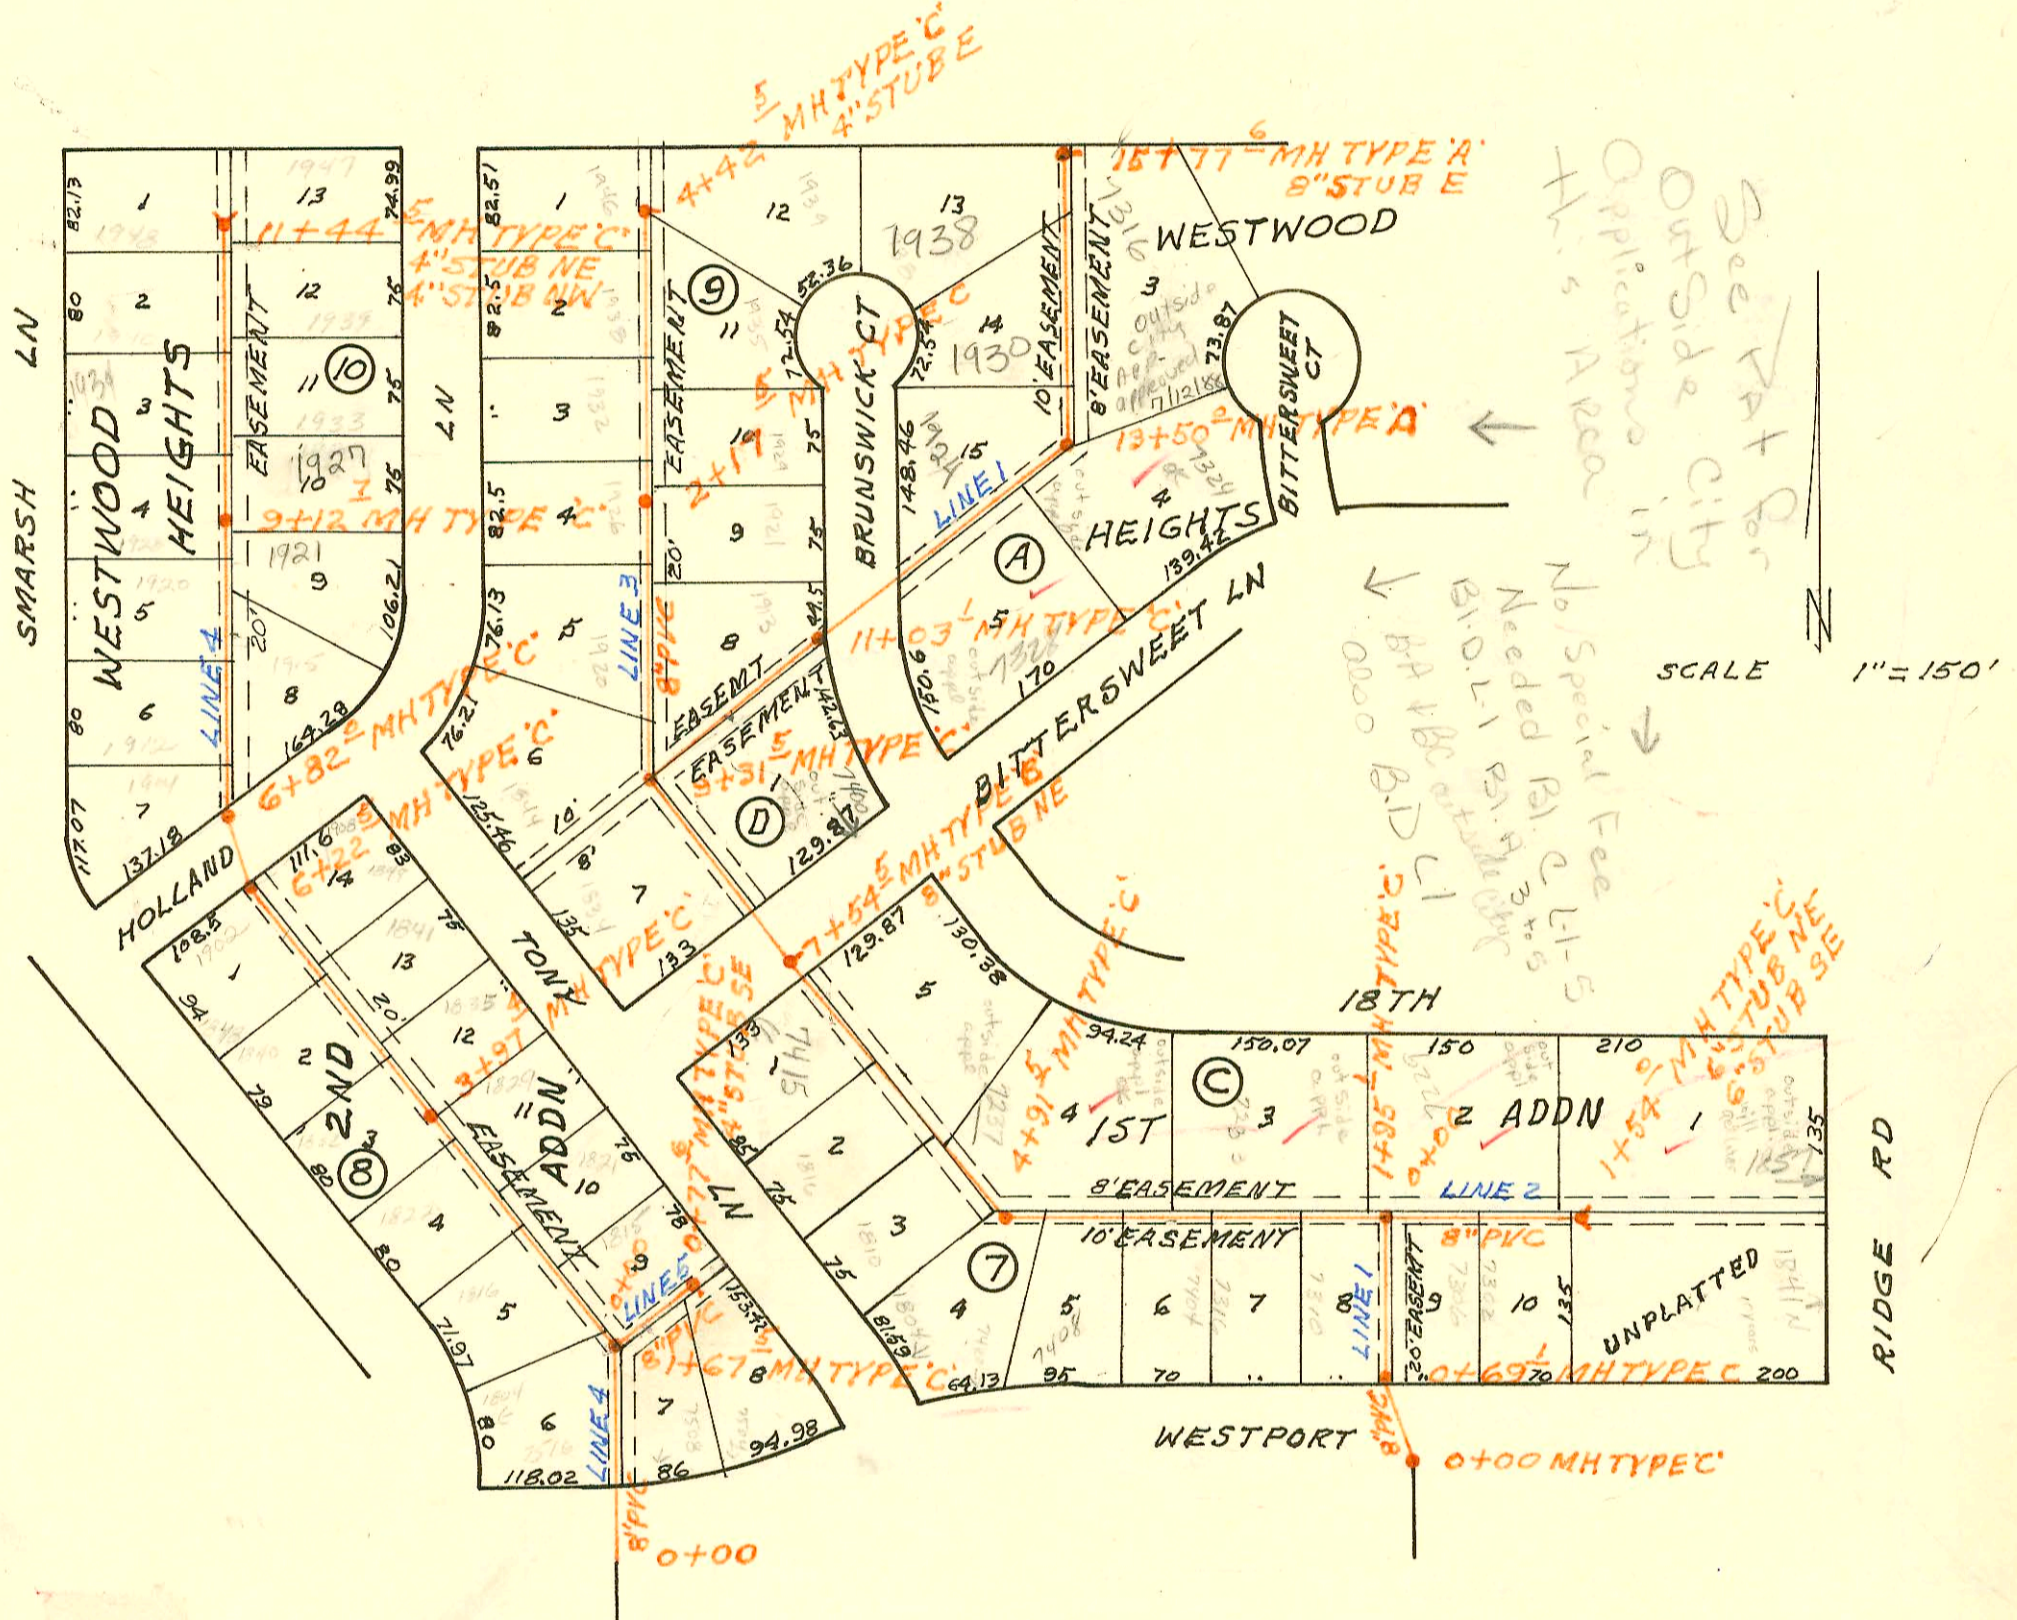

Applications for
Outside City
See TA + B
This Area

No Special Fee
Needed RA, C, L-5
B.I.O.L.I. RA, B.I.O.L.I.C
0000 B.I.D. C-1

SCALE 1" = 150'

LATERAL 140 SOUTHWEST INTERCEPTOR SEWER
BUILT BY: UTILITY CONTR. INC.
PROJ. NO 468-76-245-80681-000-000-001
BOOKED 7-6-81 FROM AG 13

on map
00.8
09.0
09.0

CONSTRUCTION RECORD

SERVICE RECORD

| STATION | ELEVATION | | Depth | MANHOLE | 4-INCH "Y" BRANCHES | | No. of Permit | | House Number | | DATE OF PERMITS | |
|-----------------------------|--------------|--------|-------|-------------------------|---------------------|------------|---------------|------------|---------------|-----------------|-----------------|------------|
| | Ground | Grade | | | North West | South East | North West | South East | North West | South East | North West | South East |
| LAT 140 LINE 4 CONT'D | SWI (CONT'D) | | | | | | | | | | | |
| 8+00 | 151.7 | 144.23 | 7.5 | | | | | | | | | |
| 9+00 | 151.3 | 144.53 | 6.8 | | | | | | | | | |
| | 151.2 | 144.57 | 6.6 | 9+12.7 | | | | | | | | |
| 10+00 | 151.1 | 144.92 | 6.2 | | | | | | | | | |
| 11+00 | 150.3 | 145.32 | 5.0 | | | | | | | | | |
| | 150.0 | 145.50 | 4.5 | 11+44.5 | 4" STUB NW | 4" STUB NE | 17006 | 14645 | 1988 Smash | 1947 Holland | 9-22-86 | 9-5-85 |
| LINE 5 | 0+00 | 151.7 | 9.6 | 0+00 = 1+67.5 LINE 4 | | | | | | | | |
| | | 151.9 | 9.5 | 0+77.6 | | 4" STUB SE | 18373 | 9551 | 1815 Smash | 1904 Holland | 4-2-83 | 10-28-83 |