


NOTE:
 Construction record and drawings for this project
 booked on pages 57 & 58.
 The drawings include the benefit district.



SUBMAIN 3, S. S. No 22
 W. B. CARTER CONST. CO. INC., MAY 18, 1955
 BK. NO. K-27, P. 22, PROJ. NO. C24-38

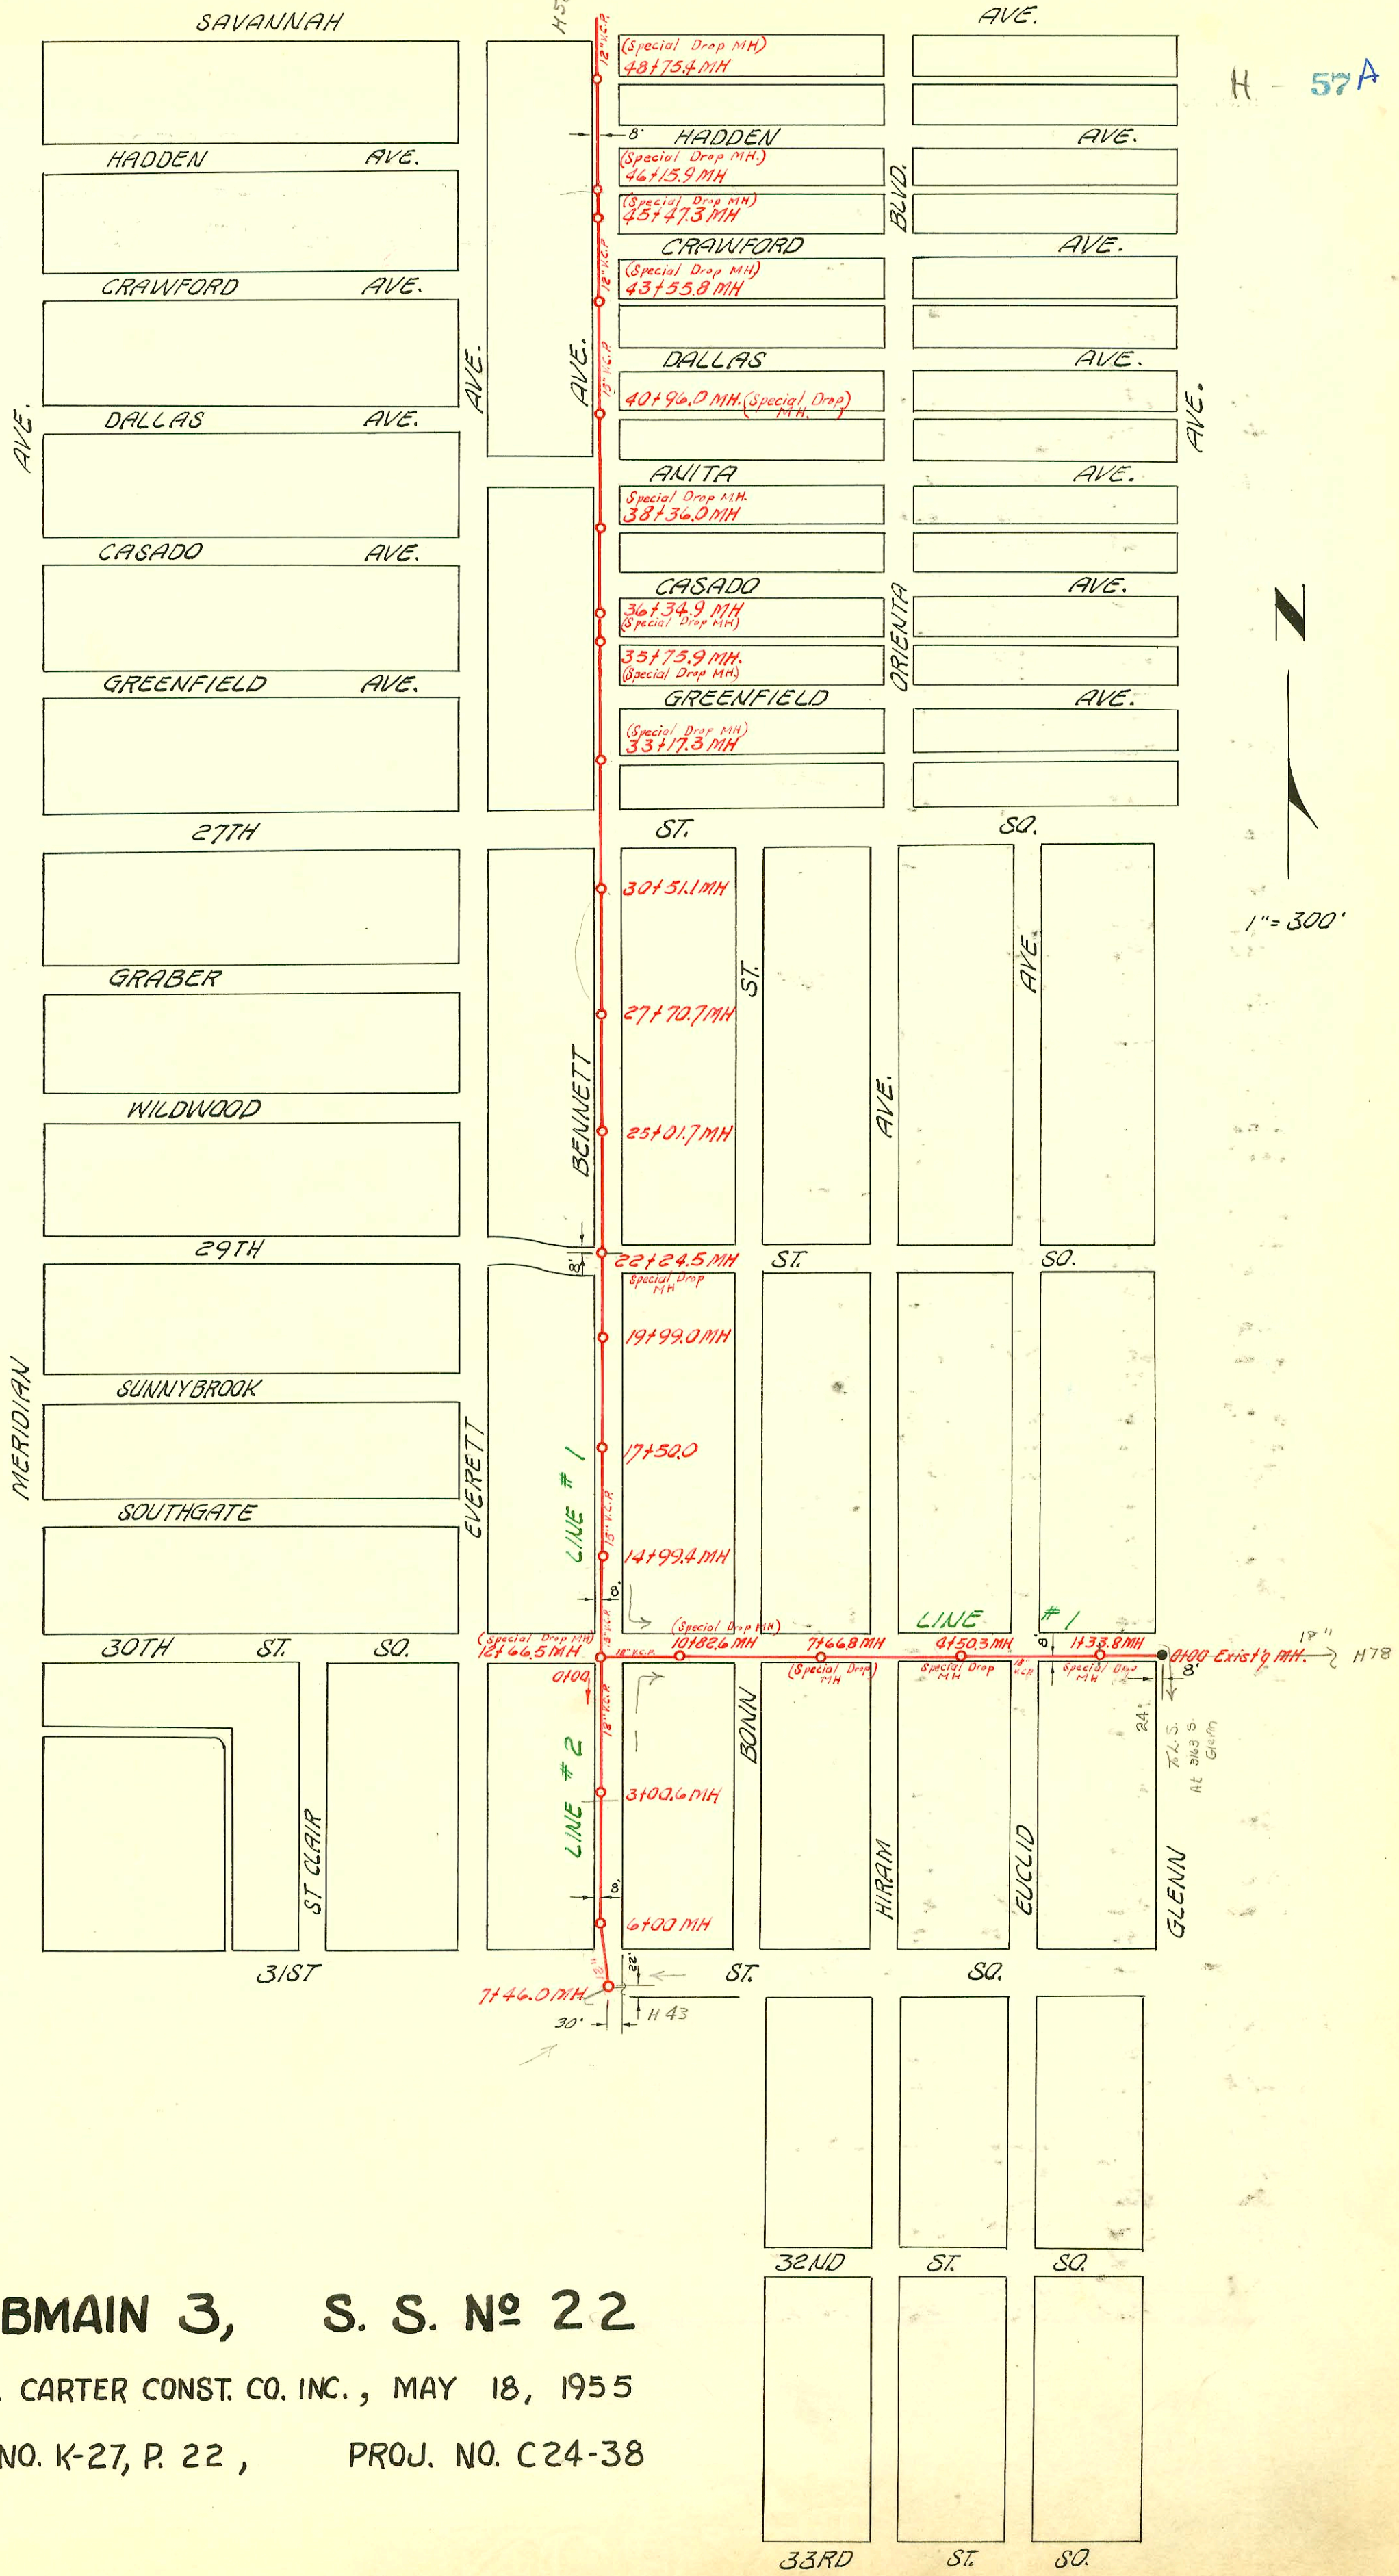