
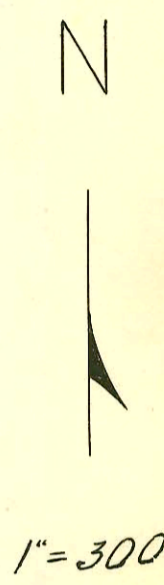


SEWER RESPONSE PLAN-PHASE 1B  
PROJ. NO. 468-8254Z (621193)  
BUILT BY INSITUFORM PLAINS, INC.  
BOOKED 10/9/96 FROM AS BUILTS

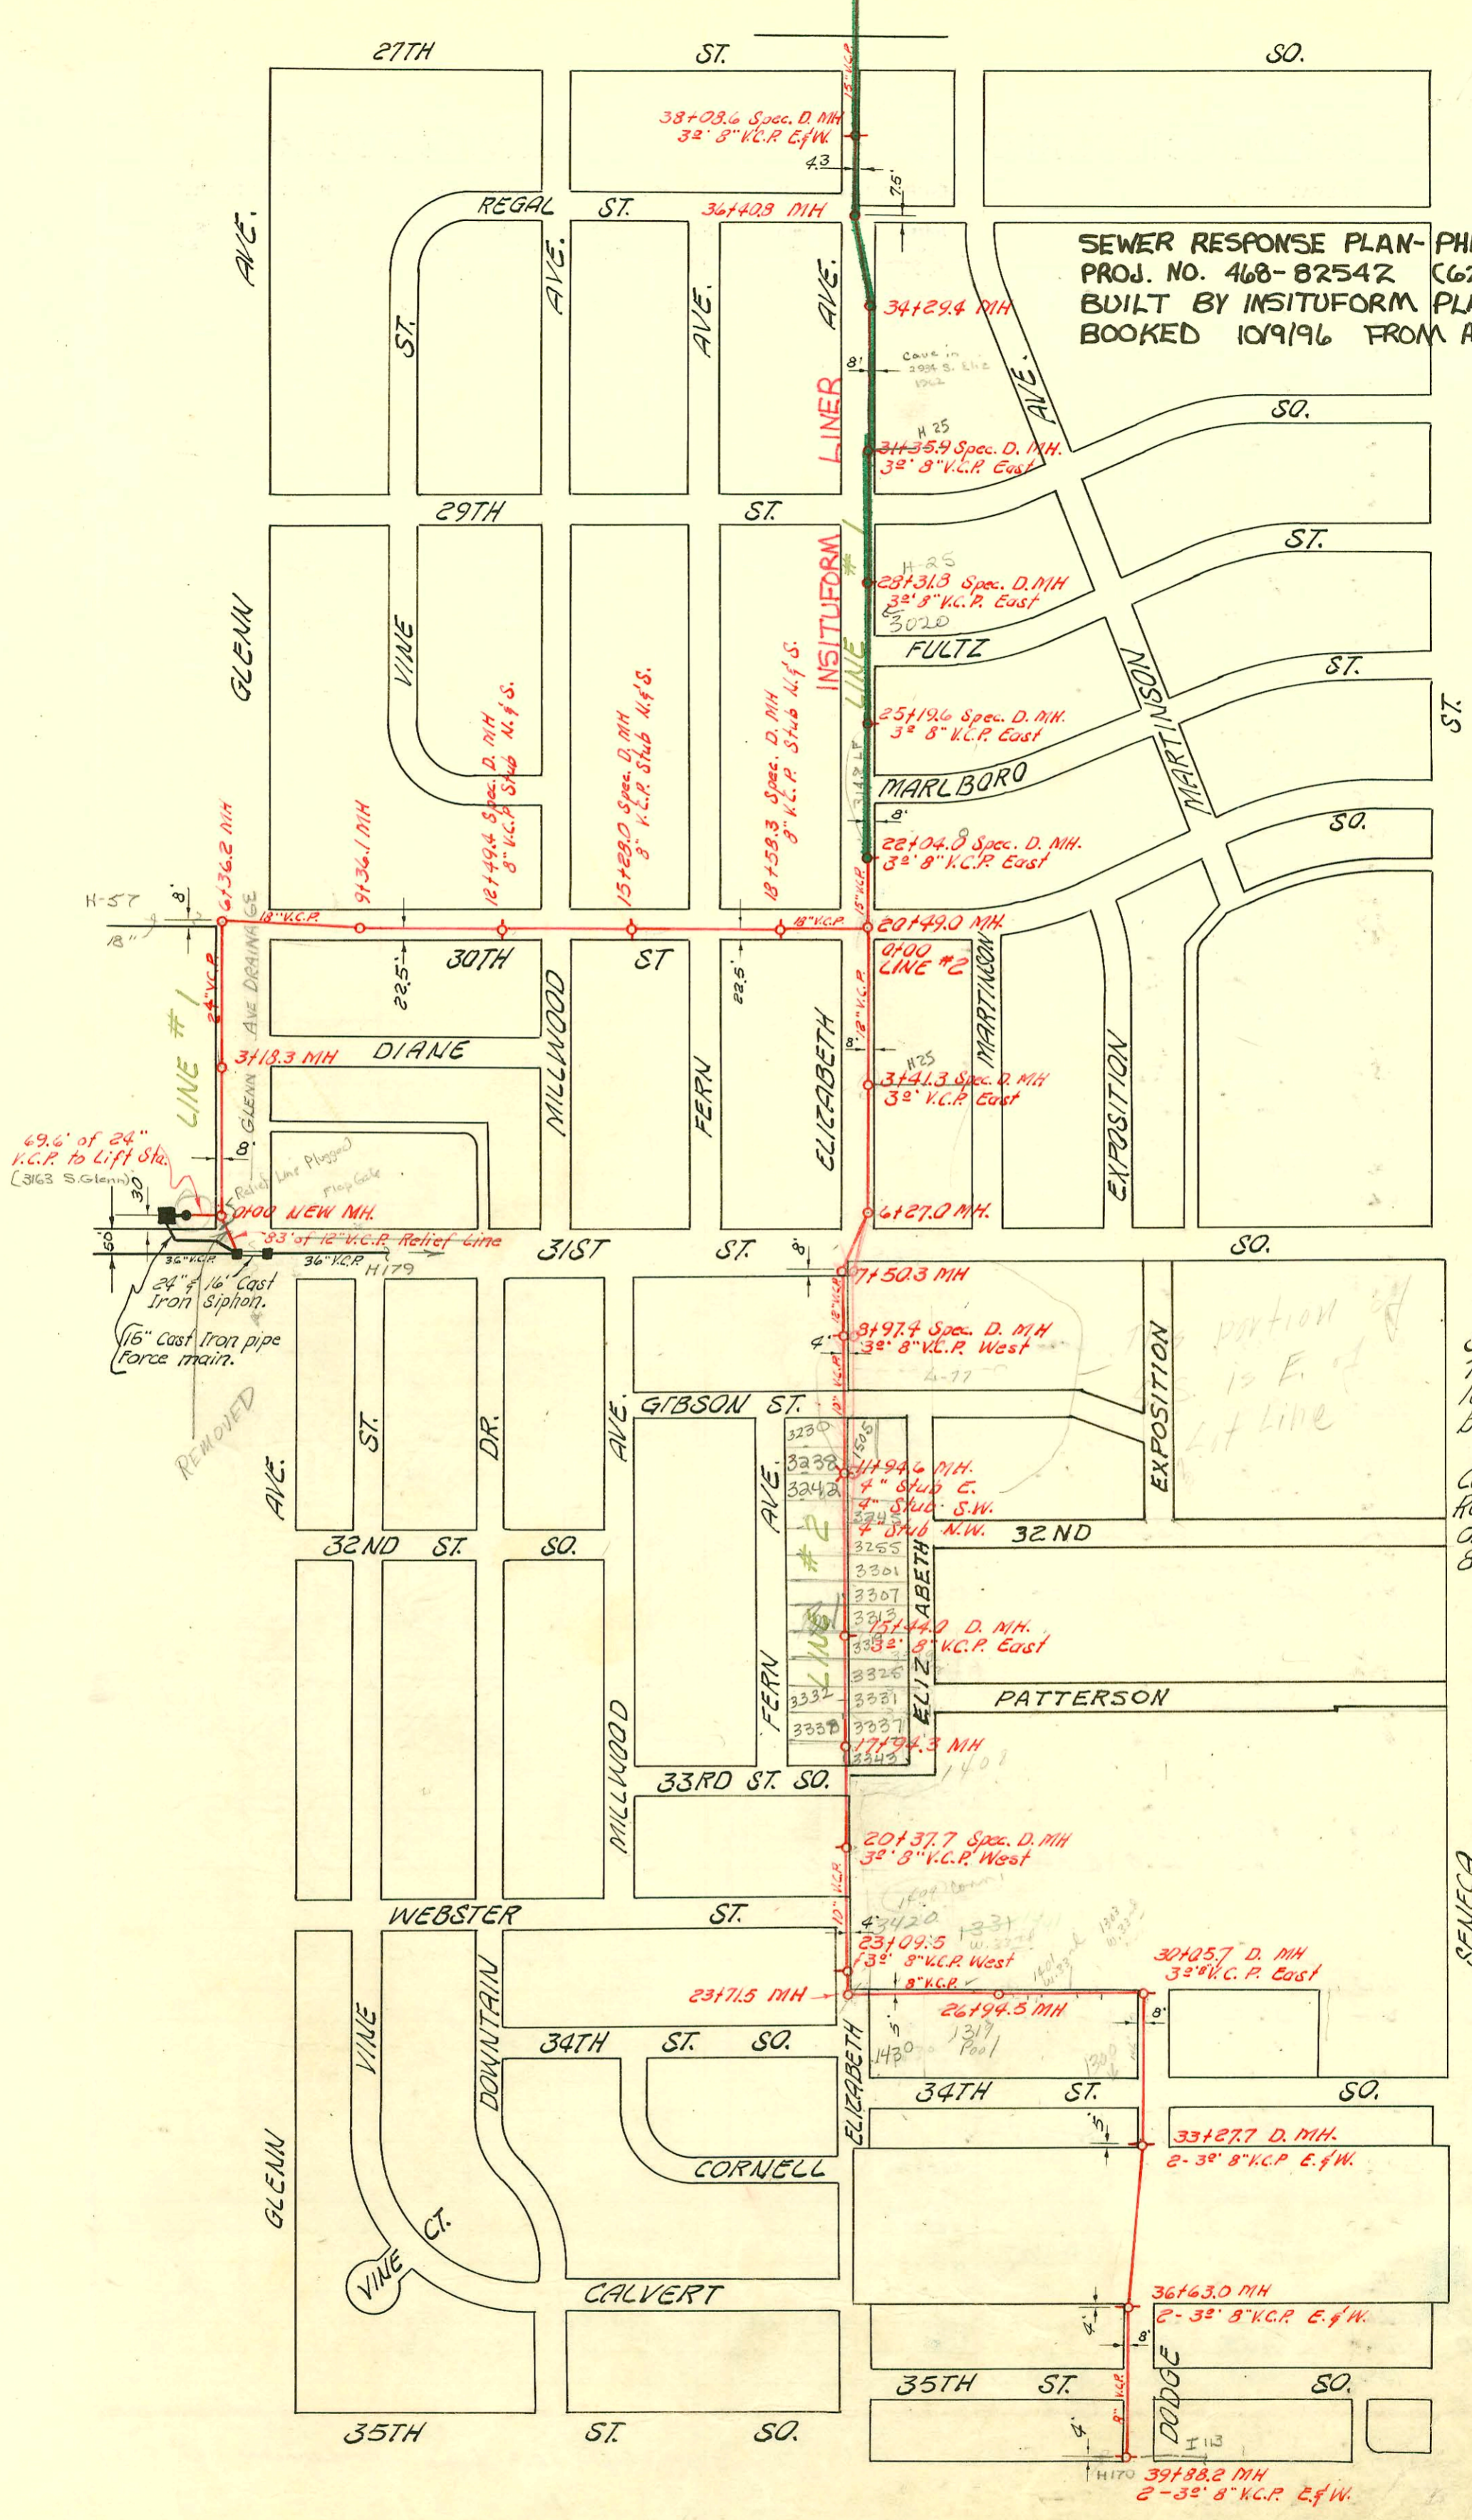

**NOTE:**  
See pages 78 & 79 for sewer location and benefit district.  
Construction Record recorded on pages 78 to 81 inclusive.

100.00  
2500  
Spec Fee

CONSTRUCTION RECORD

SERVICE RECORD

STATION	ELEVATION		Depth	MANHOLE	4 INCH "V" BRANCHES		No. of Permit		House Number		DATE OF PERMITS	
	Ground	Grade			North West	South East	North West	South East	North West	South East	North West	South East
0-69.6												
0+0	95.0	75.75	19.2	Lift Station Nov 2000 MH	97-19568-7 TAP INTO 1st MH E. of Lift Station FOR odor control unit	111507						
1+0	94.9	75.87	19.0									
2+0	95.3	75.99	19.3									
3+0	95.6	76.11	19.5									
	95.7	76.13	19.6	3+18.3								
4+0	96.0	76.23	19.8									
5+0	96.0	76.35	19.7									
6+0	96.1	76.47	19.6									
	96.1	76.52 out 77.02 in	19.1	6+36.2								
7+0	96.3	77.09	19.2									
8+0	96.2	77.21	19.0									
9+0	96.4	77.33	19.1									
	96.2	77.38	18.8	9+34.1								
10+0	96.2	77.45	18.8									
11+0	96.1	77.57	18.5									
12+0	96.3	77.69	18.6									
	96.2	77.75	18.5	12+49.4	Spec. D. MH. 8" stub N.E.S.							
13+0	96.2	77.81	18.4									
14+0	95.7	77.93	17.8									
15+0	95.8	78.05	17.7									
	95.9	78.09	17.8	15+28.0	Spec. D. MH 8" stub N.E.S.							
16+0	95.8	78.17	17.6									
17+0	96.3	78.29	18.0									
18+0	96.1	78.41	17.7									
	96.1	78.48	17.6	18+58.3	Spec. D. MH 8" stub N.E.S.							
19+0	95.9	78.53	17.4									
20+0	96.0	78.65	17.4									
	96.1	78.97	17.1	20+49.0								
21+0	96.1	79.03	17.0									
22+0	96.2	79.15	17.0									
	96.2	79.16	17.0	22+04.8	Spec. D. MH 3' 8" V.C.P. East							
23+0	96.3	79.27	17.0									
24+0	96.5	79.39	17.1									
25+0	96.4	79.51	16.9									
	96.6	79.54	17.1	25+19.6	Spec. D. MH. 3' stub E.							
26+0	96.6	79.63	17.0									
27+0	96.6	79.75	16.9									
28+0	96.9	79.87	17.0									
	96.8	79.91	16.9	28+31.8	Spec. D. MH 3' 8" V.C.P. East							
29+0	97.1	79.99	17.1									
30+0	96.8	80.11	16.7									
31+0	94.0	80.23	13.8									
	97.2	80.28	16.9	31+35.9	Spec. D. MH 3' 8" V.C.P. East							
32+0	97.2	80.35	16.8									
33+0	97.4	80.47	16.9									
34+0	97.2	80.59	16.6									
	97.5	80.61 out 80.74 in	16.8	34+29.4								
35+0	97.8	80.81	17.0									
36+0	97.7	80.93	16.8									
	97.8	80.98 out 81.08 in	16.7	36+40.8								
37+0	97.6	81.15	16.5									
38+0	97.7	81.27	16.4									
	97.7	81.28	16.4	38+08.6	Spec. D. MH. 3' 8" V.C.P. East							
39+0	97.7	81.39	16.3									
40+0	98.3	81.51	16.8									
41+0	98.3	81.63	16.7									
	97.6	81.69	15.9	41+52.0	Spec. D. MH 3' 8" V.C.P. East							
42+0	96.5	81.75	14.7									
43+0	96.0	81.87	14.1									
44+0	97.4	81.99	15.4									
	98.2	82.09 out 82.19 in	16.0	44+83.8	Spec. Drop MH 3' 8" V.C.P. West							
45+0	98.0	82.21	5.8									
46+0	98.3	82.33	16.0									
47+0	98.4	82.45	16.0									
48+0	98.5	82.57	15.9									
	98.5	82.59 out 82.69 in	15.8	48+12.4	Spec. D. MH 3' 8" V.C.P. West							
49+0	98.5	82.79	15.7									
50+0	98.3	82.91	15.4									
51+0	98.9	83.03	15.8									

Line # 1

216478 3020 S Elizabeth Elizabeth 10/11/82

NOTE: Permit C58838 - 3230 S. Fern - 11/29/76 (11+11.4)  
 Construction Record for this project 11736 Tap 13 21 W 33, to J.C. Howard 10-28-59 (26199.5)  
 continues on page 79.  
 # 21647 3020 S Elizabeth - MH #15 pulled permit (1401) (C-1991) - 3331 S. Elizabeth - lined sewer 7-1-70 - see Page 119  
 but did not complete Job. per K. Johnson  
 10/21/76 C58304 - tap 1408 W 34 S. (1+28.1 E chg 23+71.5)  
 10/23/76 C58408 - tap " " " (95.4 E 23-71.5)  
 Don Coleman