




1" = 100'

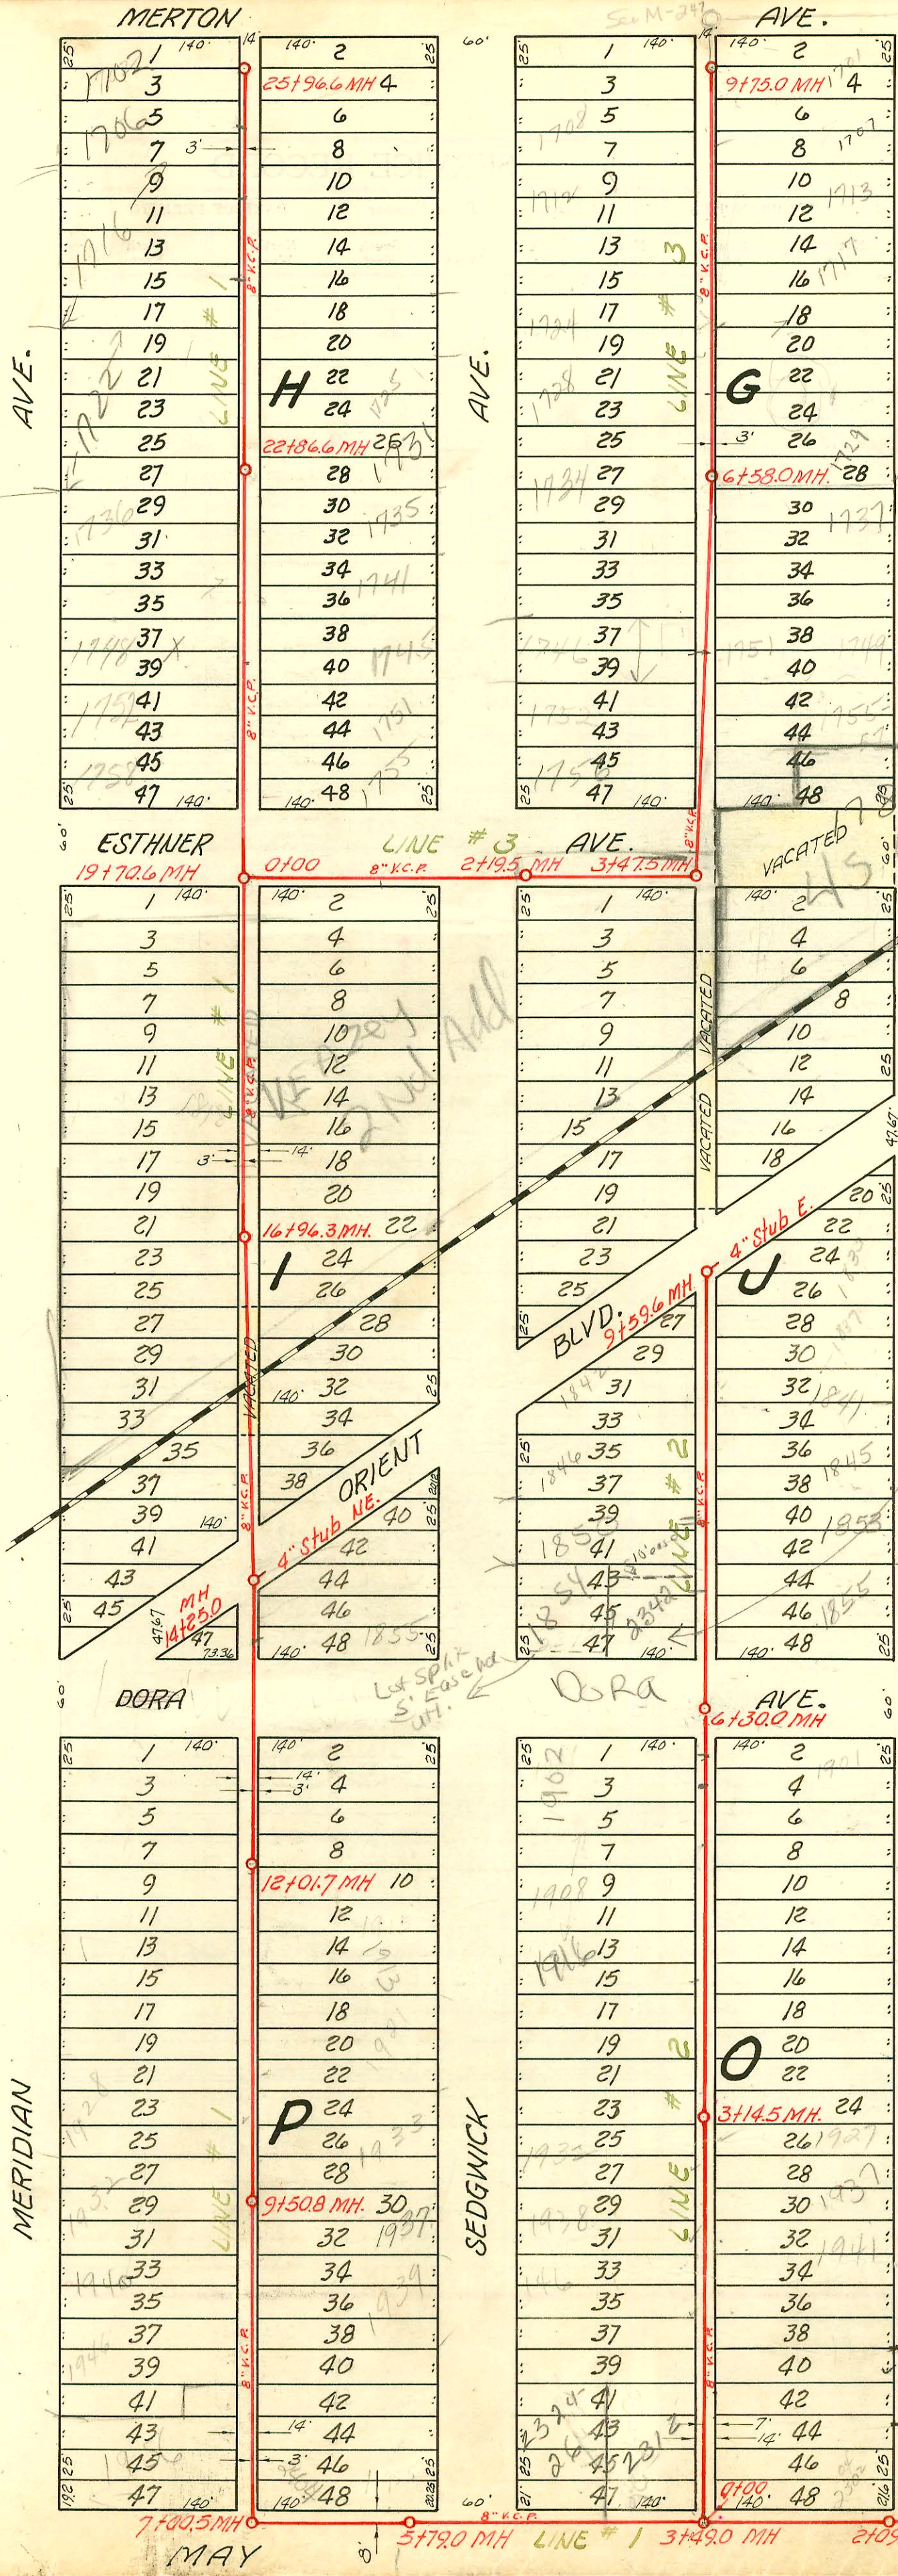

ST. CLAIR AVE.

Lot Split  
 SUB 2002-00028  
 10' UTIC ease along NPL  
 of 2342 Dora given to  
 1854 S. Sedgwick for utilities

**LAT. 12, SUB. 3, S. S. 22**  
 W. B. CARTER CO. INC., DEC. 22, 1955  
 BK. NO. K-35, PROJ. NO. C25-43

See Below 2000-00024  
 8421 Top 1937 S. Sedgwick (81678line 1)  
 8503 - 6" on 8" wye - 1855 S. St. Clair - 10-27-58  
 8504 - 6" on 8" wye - 1855 S. St. Clair - 10-27-58  
 9619 - top 1758 S. Meridian - 3-26-59  
 12173 trailer - 1752 S. Meridian - 1-27-60  
 82332 - 1725 S. Sedgwick - 11-16-64

**NOTE:**  
 Construction Record for this project  
 recorded on pages 104 & 105.

2000-00024-1937 S. SEDGWICK - A GOOD PLUMBER - 1/66  
 Replaced all but lower 3' wye approx. 83' S  
 4" SCH 40 (81678)  
 2002-00509 - 1716 S Meridian - 2/25/02  
 Nelson Piley - 2 Fernco, 4" SCH 40, Replaced  
 5' of pipe @ house, ITWINCO

ST. CLAIR

LINE # 1

AVE.

CONSTRUCTION RECORD

SERVICE RECORD

| STATION | ELEVATION |                    | Depth     | MANHOLE        | 4-INCH "Y" BRANCHES |            | No. of Permit |            | House Number |            | DATE OF PERMITS |            |
|---------|-----------|--------------------|-----------|----------------|---------------------|------------|---------------|------------|--------------|------------|-----------------|------------|
|         | Ground    | Grade              |           |                | North West          | South East | North West    | South East | North West   | South East | North West      | South East |
| 0+0     | 103.1     | 97.21              | 5.9       | 0+00 Existg MH |                     |            |               |            |              |            |                 |            |
| 1+0     | 103.4     | 97.39              | 6.0       |                |                     |            |               |            |              |            |                 |            |
| 2+0     | 103.3     | 97.57              | 5.7       |                |                     |            |               |            |              |            |                 |            |
| 3+0     | 103.5     | 97.59              | 5.9       | 2+09.4         |                     |            |               |            |              |            |                 |            |
| 4+0     | 103.4     | 97.75              | 5.7       |                |                     |            |               |            |              |            |                 |            |
| 5+0     | 103.5     | 97.84              | 5.7       | 3+49.0         |                     |            |               |            |              |            |                 |            |
| 6+0     | 103.7     | 97.97              | 5.7       |                | 4+42                |            | 674646        |            | 2324-26 May  |            | 10-4-79         |            |
| 7+0     | 103.5     | 98.11              | 5.4       |                |                     |            |               |            |              |            |                 |            |
| 8+0     | 103.8     | 98.25              | 5.5       | 5+79.0         |                     |            |               |            |              |            |                 |            |
| 9+0     | 104.0     | 98.29              | 5.7       |                |                     |            |               |            |              |            |                 |            |
| 10+0    | 103.9     | 98.47 out 98.57 in | 5.4 (5.3) | 7+00.5         |                     |            |               |            |              |            |                 |            |
| 11+0    |           |                    |           |                | 7+17.3              |            |               |            |              |            |                 |            |
| 12+0    |           |                    |           |                | 7+54.8              |            |               |            |              |            |                 |            |
| 13+0    | 105.2     | 98.75              | 6.5       |                | 7+63.4              |            |               |            |              |            |                 |            |
| 14+0    |           |                    |           |                | 7+65.4              |            |               |            |              |            |                 |            |
| 15+0    |           |                    |           |                | 8+04.0              |            |               |            |              |            |                 |            |
| 16+0    |           |                    |           |                | 8+35.3              |            |               |            |              |            |                 |            |
| 17+0    |           |                    |           |                | 8+79.5              |            |               |            |              |            |                 |            |
| 18+0    | 105.2     | 98.93              | 6.3       |                | 9+22.4              |            |               |            |              |            |                 |            |
| 19+0    |           |                    |           |                | 9+60.0              |            |               |            |              |            |                 |            |
| 20+0    | 105.5     | 99.02              | 6.50      | 9+50.8         |                     |            |               |            |              |            |                 |            |
| 21+0    | 105.5     | 99.11              | 6.4       |                | 10+03.0             |            |               |            |              |            |                 |            |
| 22+0    |           |                    |           |                | 10+46.0             |            |               |            |              |            |                 |            |
| 23+0    |           |                    |           |                | 10+98.0             |            |               |            |              |            |                 |            |
| 24+0    | 105.7     | 99.29              | 6.4       |                | 10+05.0             |            |               |            |              |            |                 |            |
| 25+0    |           |                    |           |                | 10+44.0             |            |               |            |              |            |                 |            |
| 26+0    |           |                    |           |                | 10+96.0             |            |               |            |              |            |                 |            |
| 27+0    |           |                    |           |                | 11+42.0             |            |               |            |              |            |                 |            |
| 28+0    |           |                    |           |                | 11+15.7             |            |               |            |              |            |                 |            |
| 29+0    |           |                    |           |                | 11+92.8             |            |               |            |              |            |                 |            |
| 30+0    | 105.8     | 99.47              | 6.3       |                | 12+32.0             |            |               |            |              |            |                 |            |
| 31+0    |           |                    |           |                | 12+76.0             |            |               |            |              |            |                 |            |
| 32+0    | 105.8     | 99.47              | 6.3       | 12+01.7        |                     |            |               |            |              |            |                 |            |
| 33+0    |           |                    |           |                | 13+82.0             |            |               |            |              |            |                 |            |
| 34+0    | 105.9     | 99.65              | 6.3       |                | 14+17.0             |            |               |            |              |            |                 |            |
| 35+0    |           |                    |           |                | 4" stub NE          |            |               |            |              |            |                 |            |
| 36+0    | 106.6     | 99.83              | 6.8       |                | 16+54.4             |            |               |            |              |            |                 |            |
| 37+0    |           |                    |           |                | 17+21.4             |            |               |            |              |            |                 |            |
| 38+0    |           |                    |           |                | 17+76.0             |            |               |            |              |            |                 |            |
| 39+0    | 105.7     | 99.88              | 5.8       | 14+25.0        |                     |            |               |            |              |            |                 |            |
| 40+0    | 106.8     | 100.01             | 6.8       |                | 18+37.0             |            |               |            |              |            |                 |            |
| 41+0    | 108.6     | 100.19             | 8.4       |                | 18+94.9             |            |               |            |              |            |                 |            |
| 42+0    |           |                    |           |                | 18+92.9             |            |               |            |              |            |                 |            |
| 43+0    | 106.1     | 100.36             | 5.7       | 16+96.3        |                     |            |               |            |              |            |                 |            |
| 44+0    |           |                    |           |                | 20+37.0             |            |               |            |              |            |                 |            |
| 45+0    |           |                    |           |                | 20+91.5             |            |               |            |              |            |                 |            |
| 46+0    | 105.3     | 100.55             | 4.7       |                | 21+37.7             |            |               |            |              |            |                 |            |
| 47+0    |           |                    |           |                | 21+84.6             |            |               |            |              |            |                 |            |
| 48+0    | 105.2     | 100.73             | 4.5       |                | 22+37.8             |            |               |            |              |            |                 |            |
| 49+0    | 105.0     | 100.85             | 4.2       | 19+70.6        |                     |            |               |            |              |            |                 |            |
| 50+0    | 105.1     | 100.91             | 4.2       |                | 22+95.0             |            |               |            |              |            |                 |            |
| 51+0    |           |                    |           |                | 23+32.4             |            |               |            |              |            |                 |            |
| 52+0    |           |                    |           |                | 23+91.5             |            |               |            |              |            |                 |            |
| 53+0    | 105.4     | 101.09             | 4.3       |                | 24+34.7             |            |               |            |              |            |                 |            |
| 54+0    |           |                    |           |                | 24+93.8             |            |               |            |              |            |                 |            |
| 55+0    | 105.1     | 101.27             | 3.8       |                | 25+52.9             |            |               |            |              |            |                 |            |
| 56+0    |           |                    |           |                | 25+89.9             |            |               |            |              |            |                 |            |
| 57+0    | 105.7     | 101.42             | 4.3       | 22+86.6        |                     |            |               |            |              |            |                 |            |
| 58+0    | 105.7     | 101.45             | 4.3       |                | 25+96.6             |            |               |            |              |            |                 |            |
| 59+0    |           |                    |           |                |                     |            |               |            |              |            |                 |            |
| 60+0    | 105.4     | 101.63             | 3.8       |                |                     |            |               |            |              |            |                 |            |
| 61+0    |           |                    |           |                |                     |            |               |            |              |            |                 |            |
| 62+0    | 105.5     | 101.81             | 3.7       |                |                     |            |               |            |              |            |                 |            |
| 63+0    |           |                    |           |                |                     |            |               |            |              |            |                 |            |
| 64+0    |           |                    |           |                |                     |            |               |            |              |            |                 |            |
| 65+0    |           |                    |           |                |                     |            |               |            |              |            |                 |            |

LINE # 1

751-7 trailers come 1939 & Sedgwick at turning 5-11-56 at 60th & way  
 820-1932 Meridian Top Tower 5-17-56  
 445 trailers come 1939 & Sedgwick at turning 5-11-56 at 60th & way  
 5052 Trailer - Brown 1901 L Sedgwick 7-31-57  
 #6311 Top 1930 Sedgwick at turning 2-25-58  
 #15374 Top 1930 Sedgwick at turning 9-5-62 (11+74.7)