
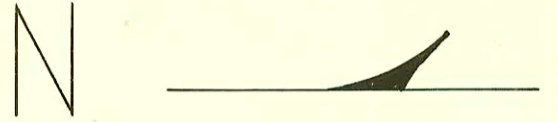


ST. CLAIR

H-123A

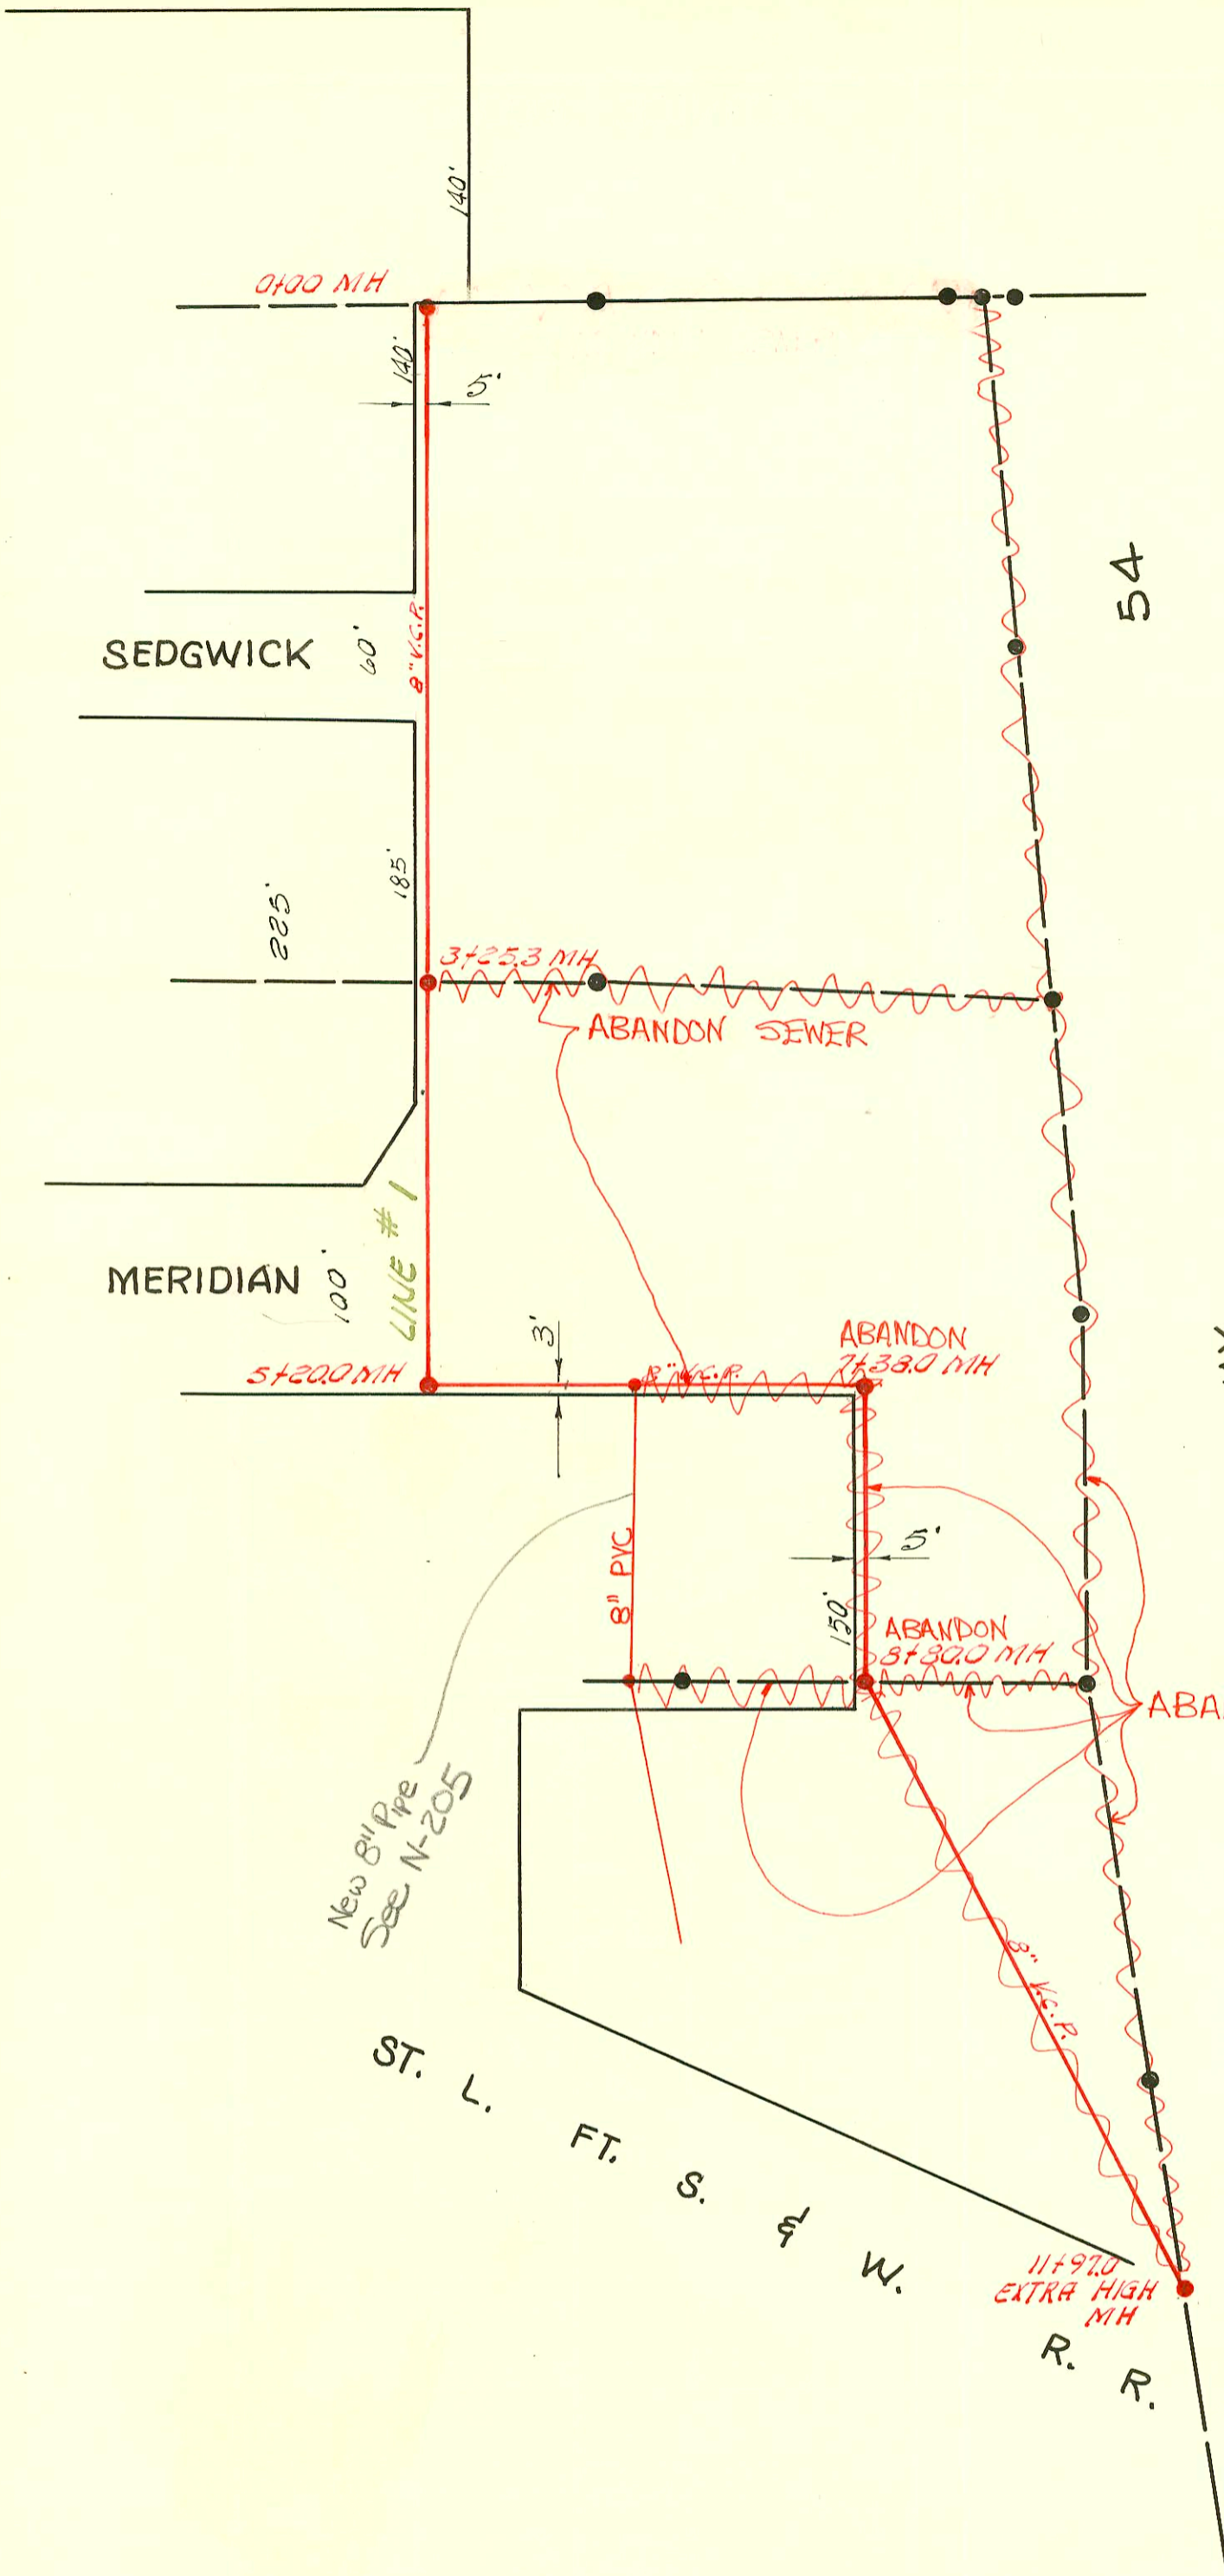

1" = 80'

NOTE:

This project booked on pages 123 and 124.

HIGHWAY

KELLOGG - K-42 TO SYCAMORE
 (SANITARY SEWER CHANGES)
 PROJ. NO. 700500
 BUILT BY WILDCAT CONST. CO.
 BOOKED 2-9-96 AS PER PLAN

New 8" Pipe
 See N-205

ST. L. FT. S. & W.
 R. R.

