


LAT. 2, SUB 9, S.S. #22
DEVELOPMENT INC. CONST. CO. JUNE 28 1956
BK NO. K-22, PROJ. NO. C25-92



NOTE:
"Y" information starts from page 146.

Underground Utilities:
Water Co Control Cables

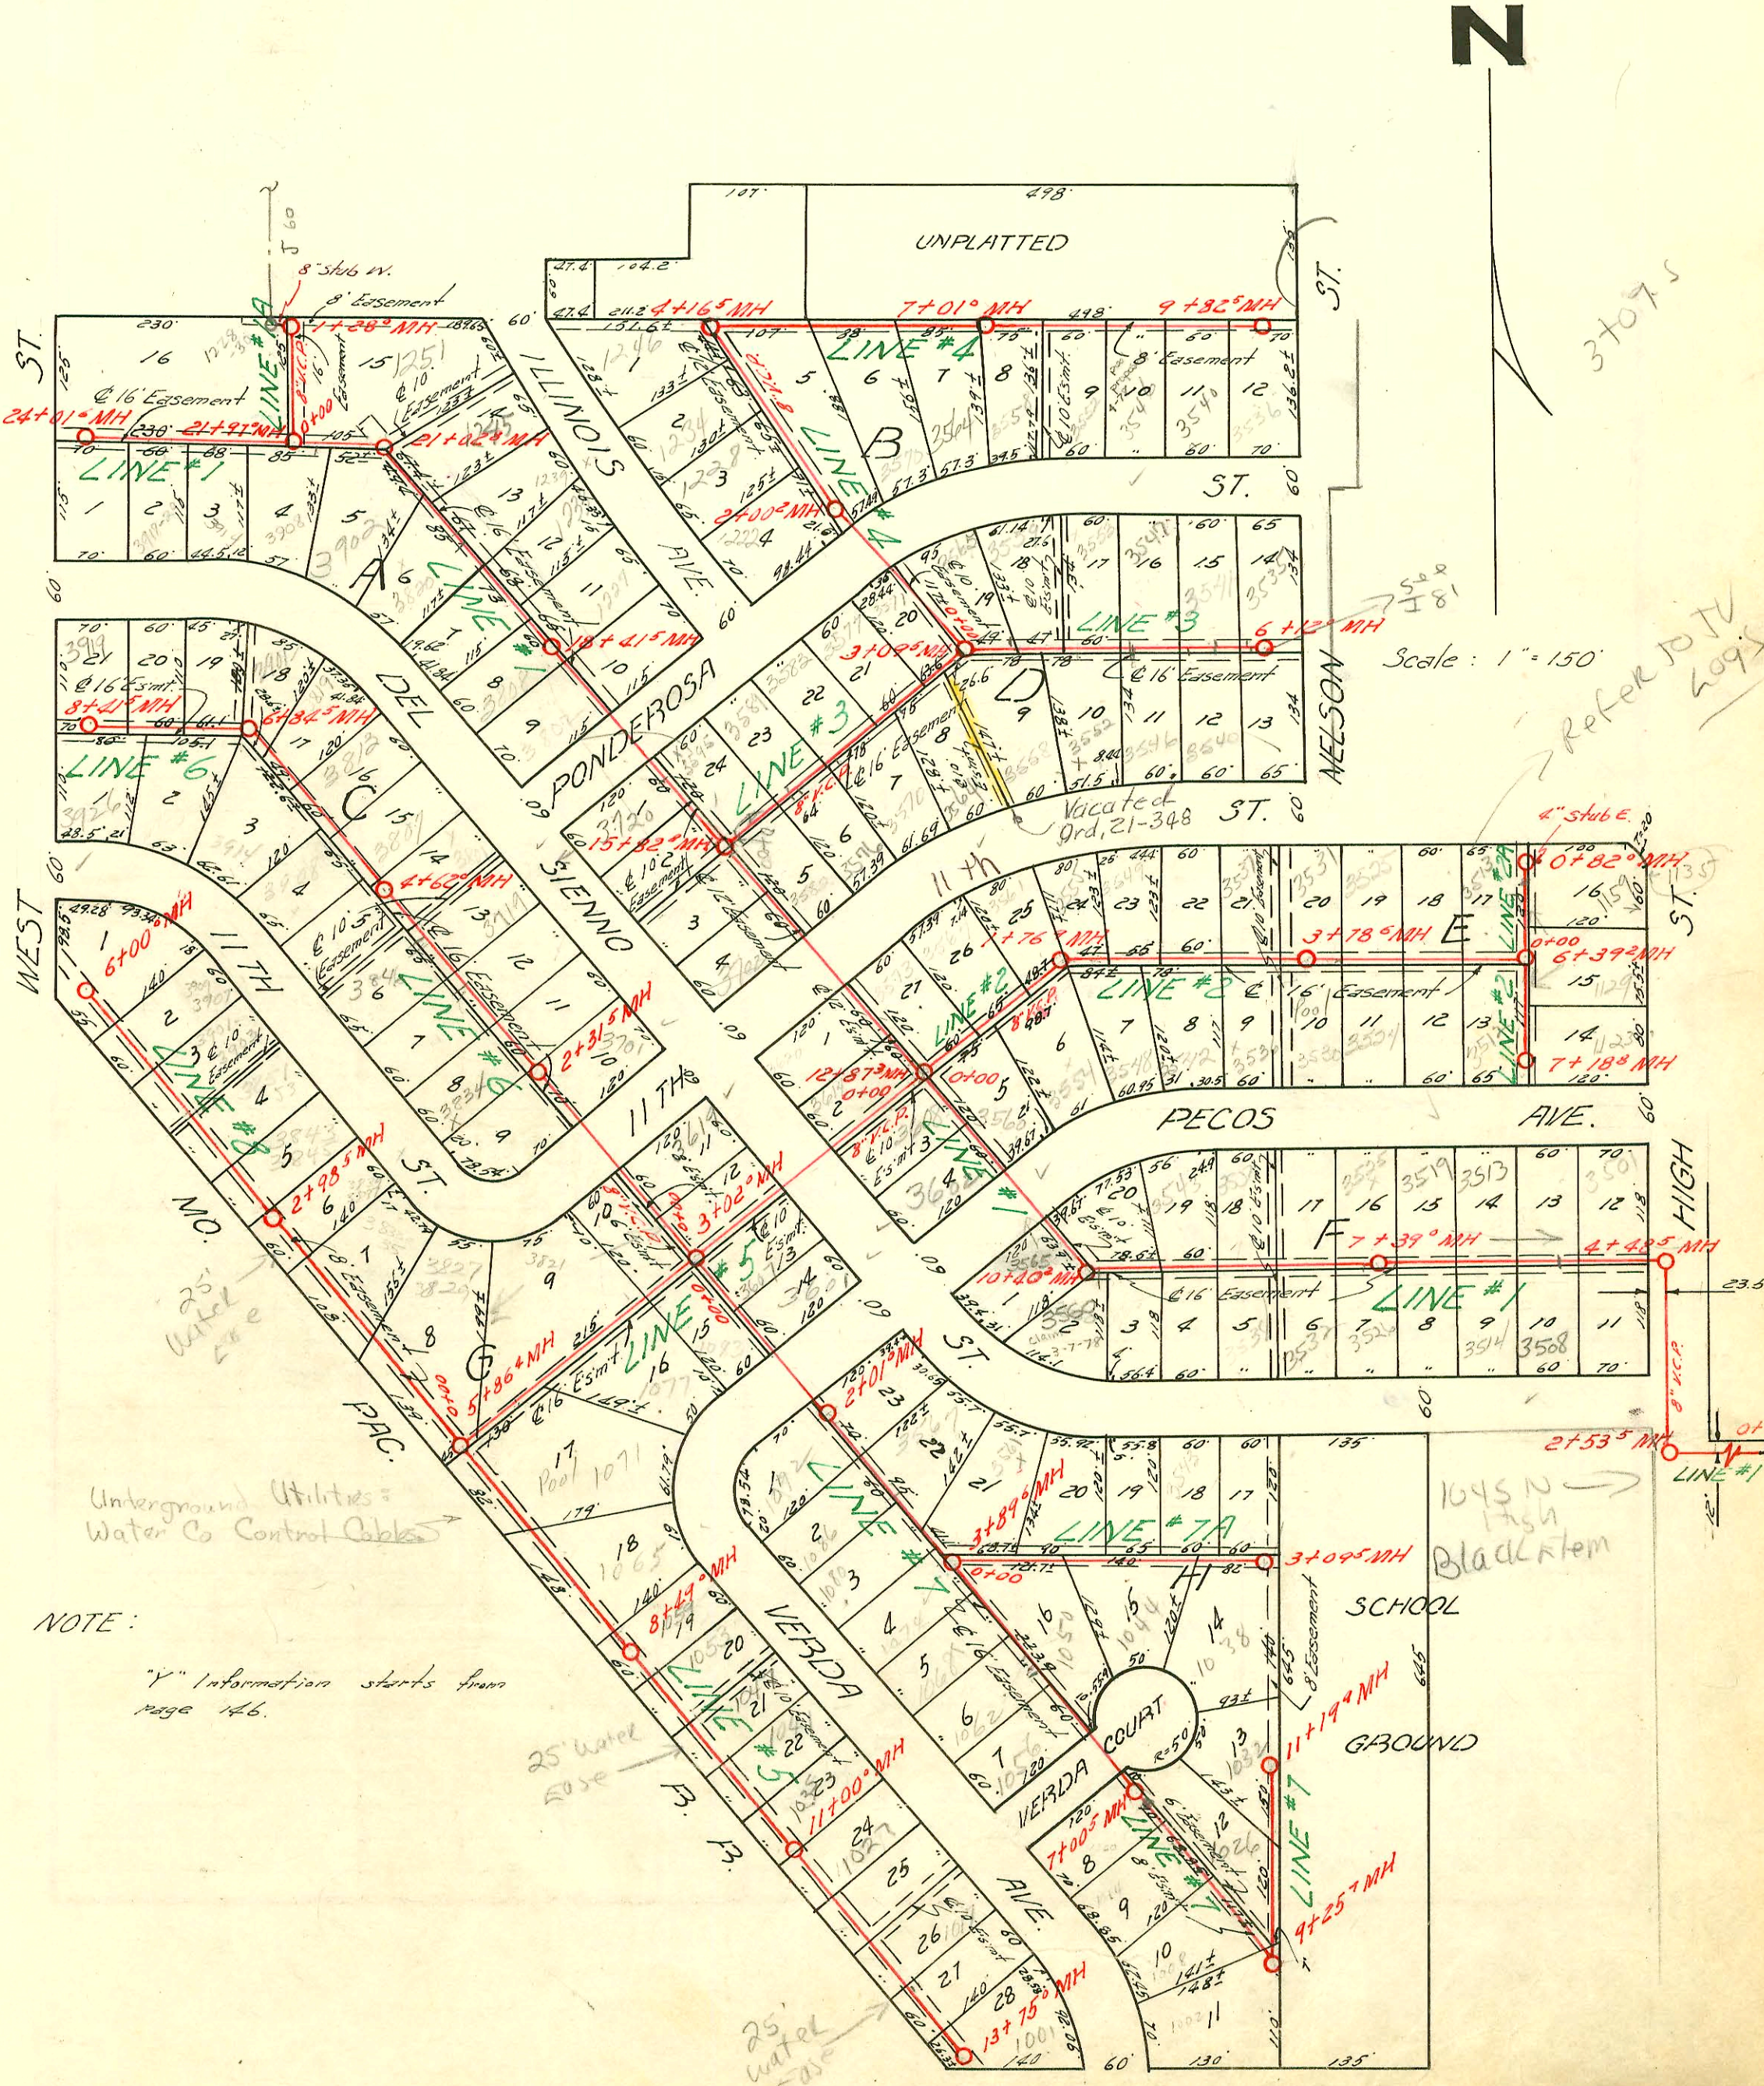

Scale: 1" = 150'

Refer to TV Logs

1045 N
Blackstem
SCHOOL
GROUND

