


LAT. 2, SUB 9, S.S. #22
DEVELOPMENT INC. CONST. CO. JUNE 28 1956
BK NO. K-22, PROJ. NO. C25-92



Underground Utilities:
Water Co Control Cables

NOTE:
"Y" information starts from
page 146.

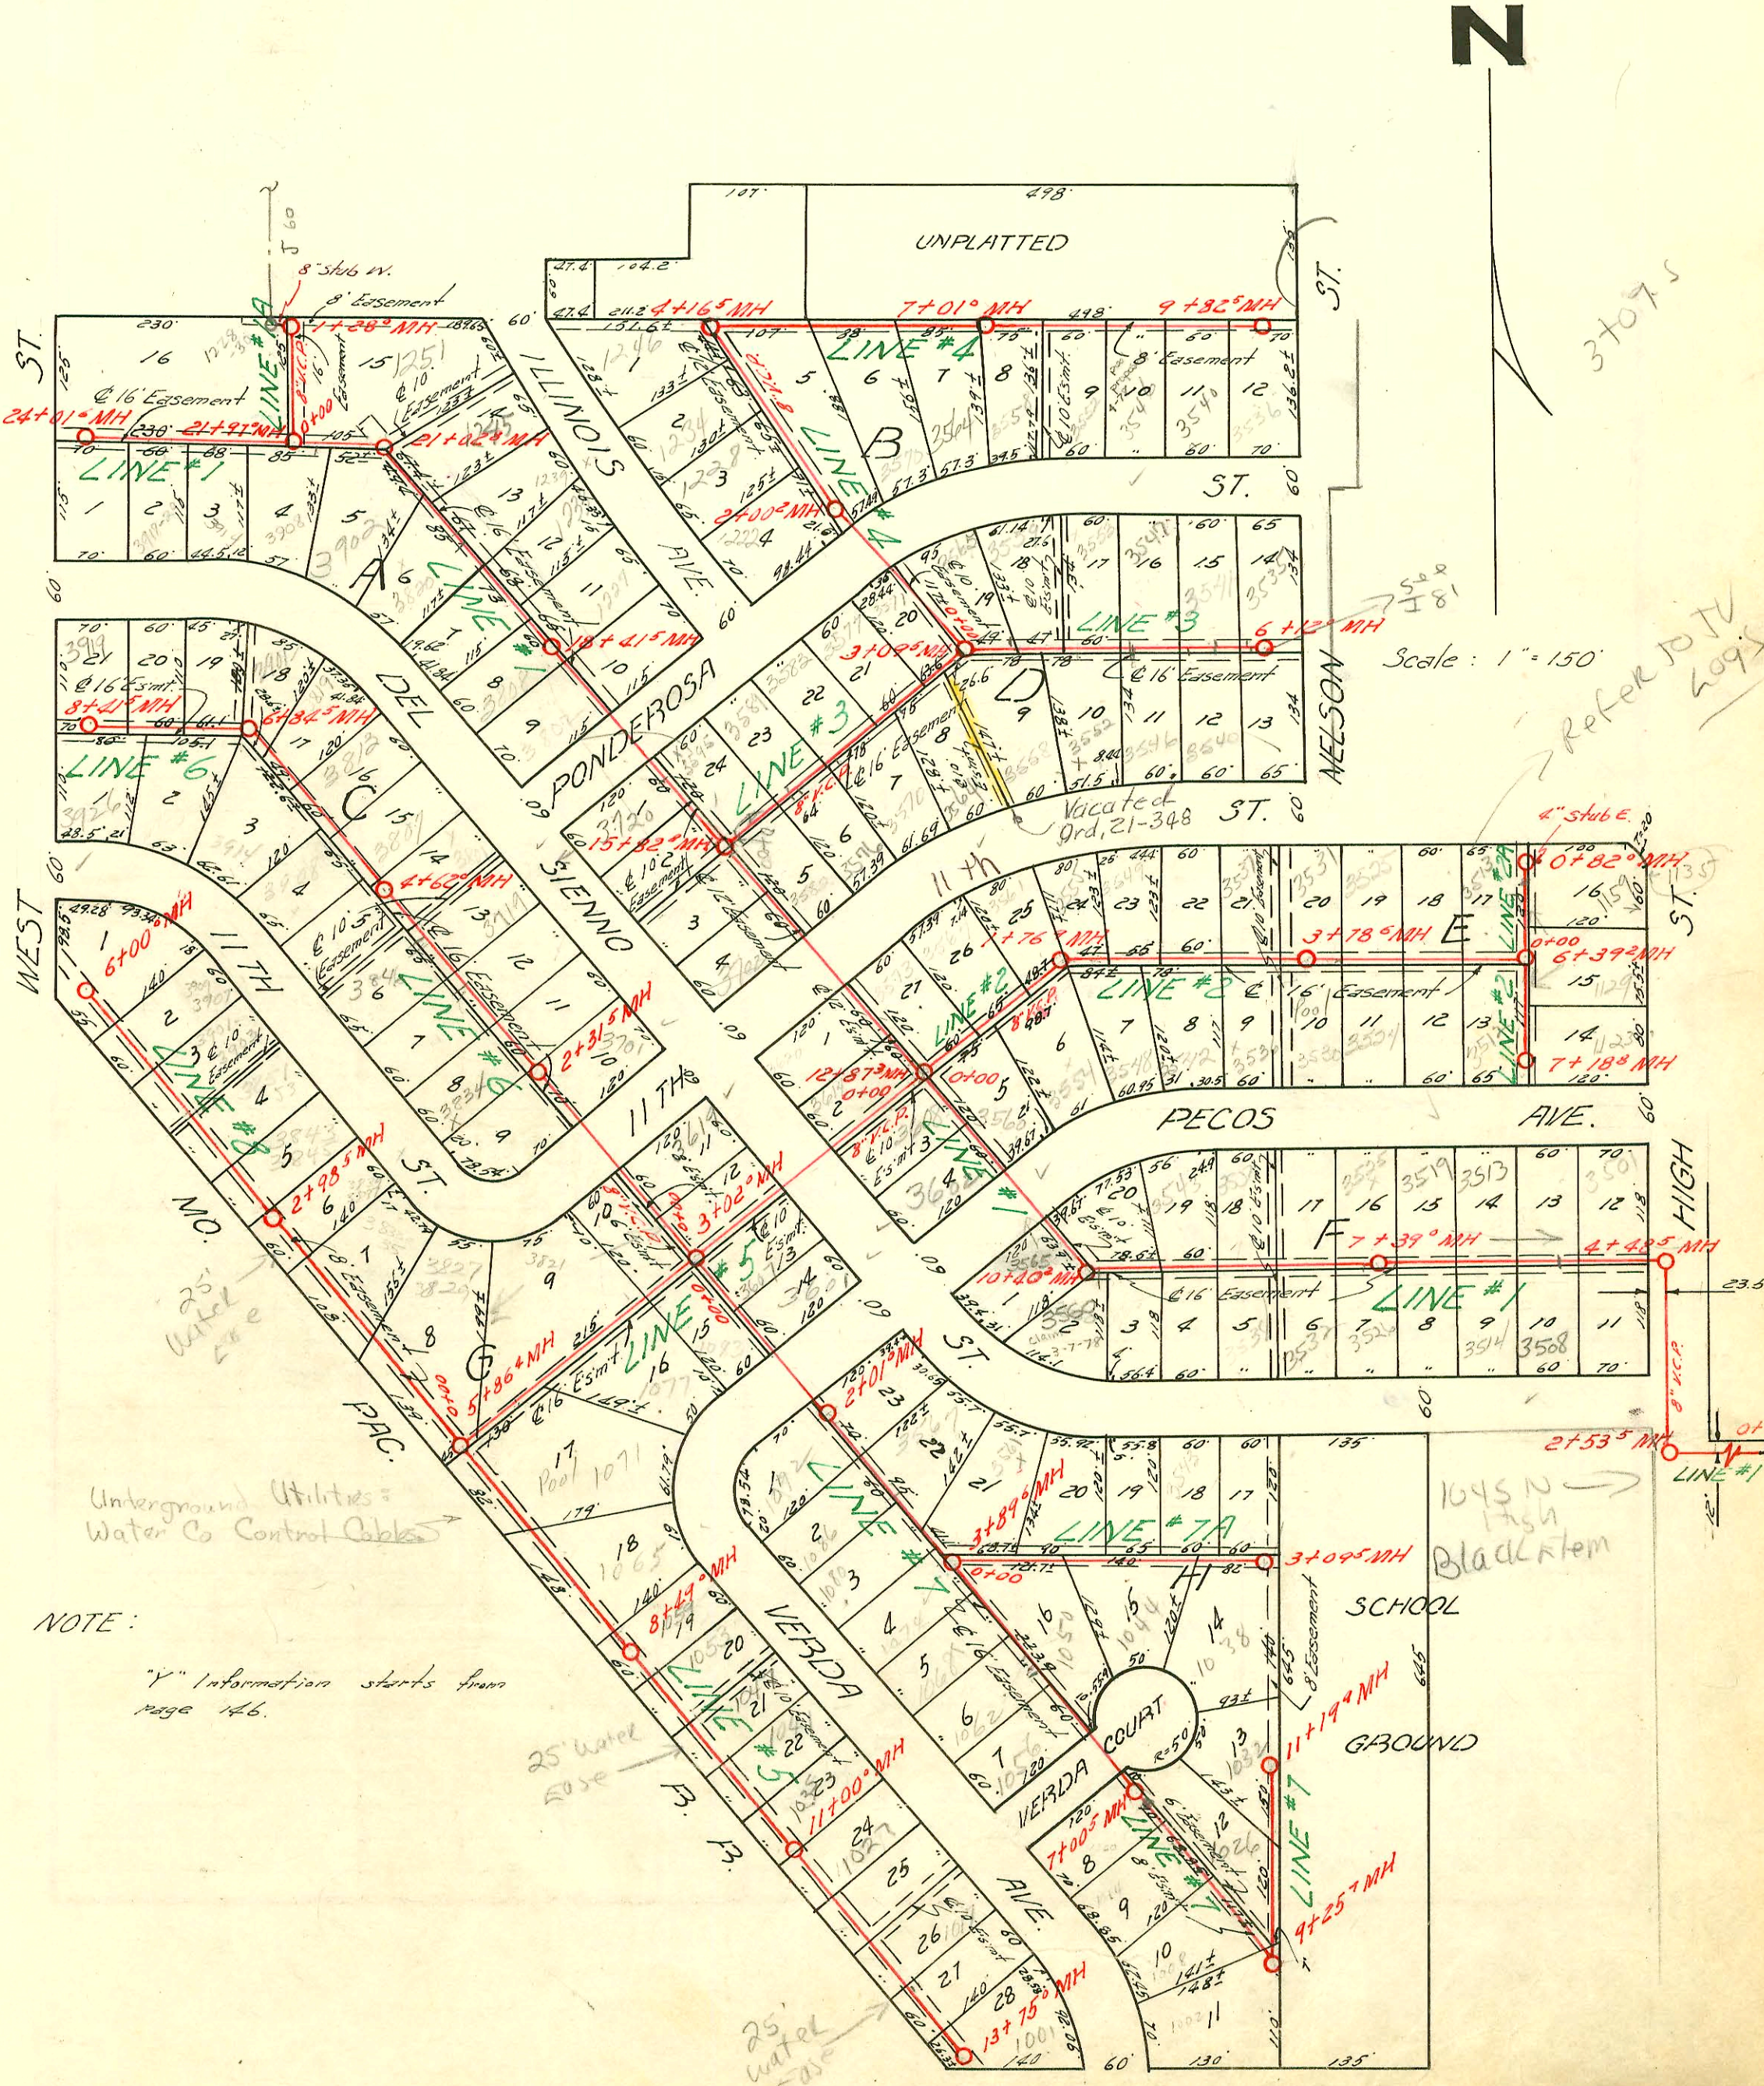

Scale: 1" = 150'

Refer to TV logs

1045 N
Blackstem

SCHOOL
GROUND

COURT

25' Water
EASE

5022006-0043-3914 Del Sienna - d/o (1)twingo, (2)ferno, shawls, d'sch 40 PVC - Redd. Ind. H-00