


LAT. 2, SUB 9, S.S. #22
DEVELOPMENT INC. CONST. CO. JUNE 28 1956
BK NO. K-22, PROJ. NO. C25-92

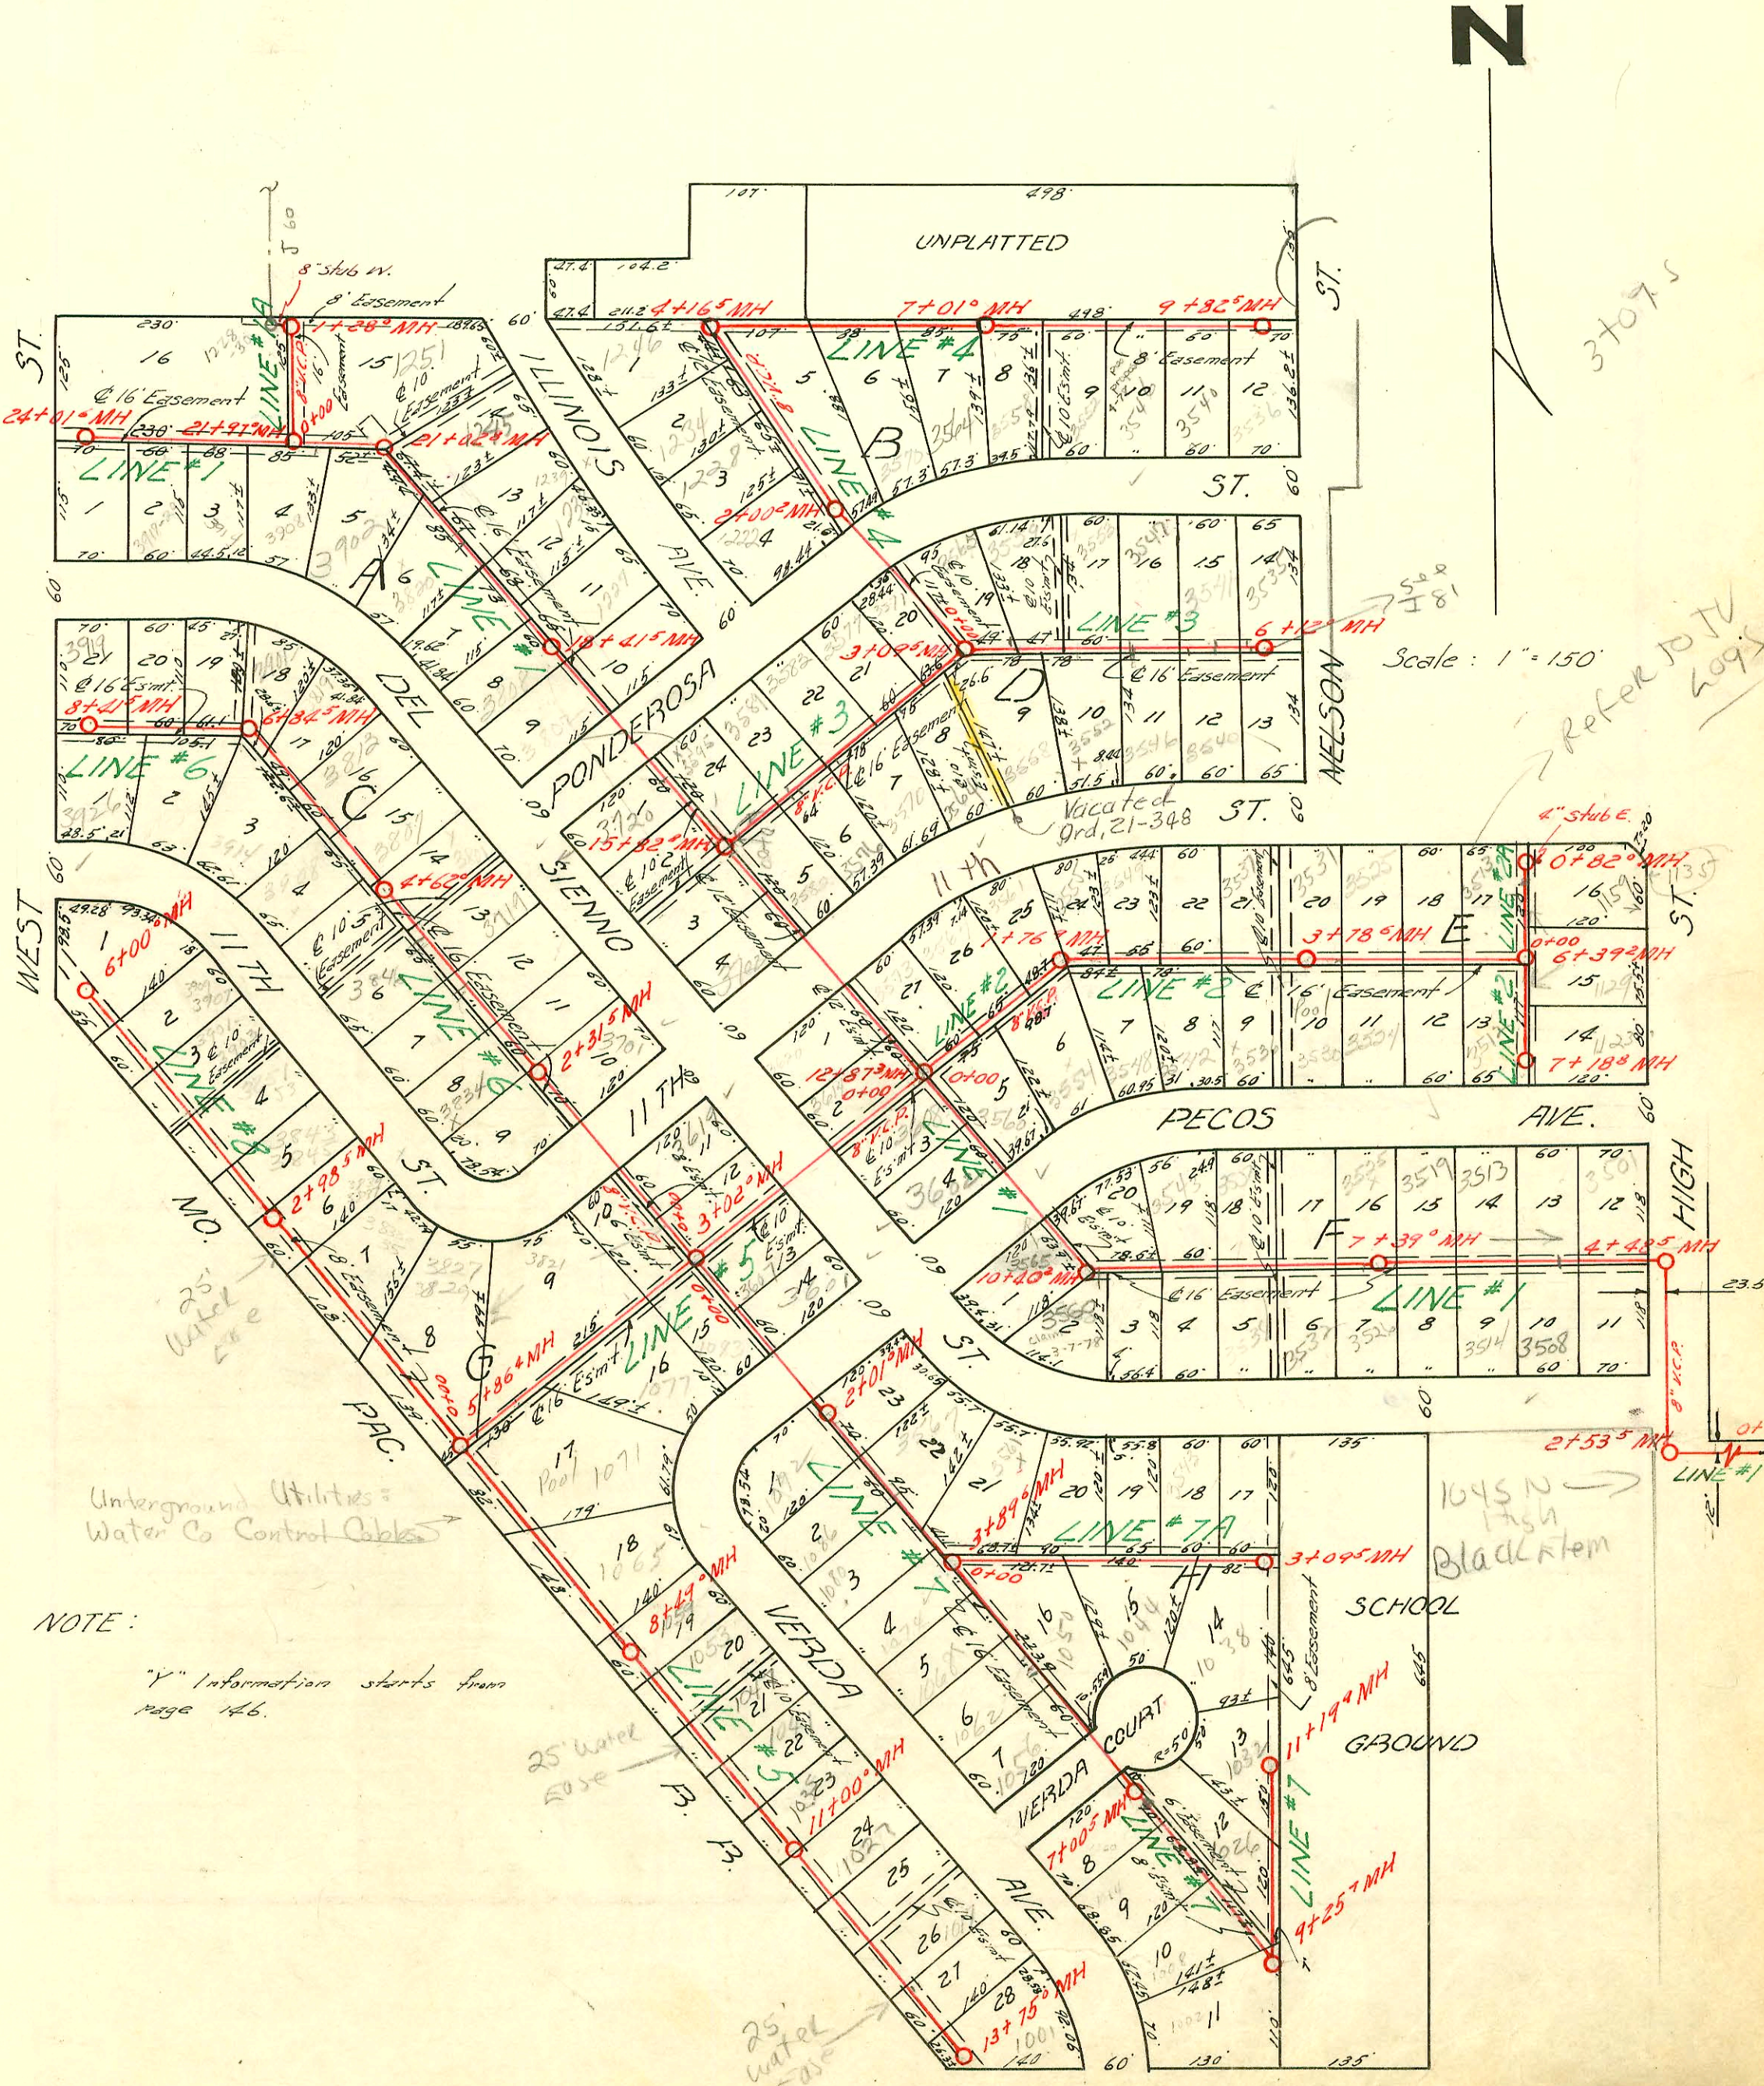

Scale: 1" = 150'

Refer to TV logs

Underground Utilities:
Water Co Control Cables

NOTE:
"Y" information starts from page 146.

1045 N
Blackstem

SCHOOL
GROUND

25' Water
EASE

Rep 2001-00065-410/91-3558 W 11th St N - Padgett Exc - 4" SCH 40 - Donut Tied back to claytile
ITWIN CO, 1V22, 1V45