




Scale 1" = 100'

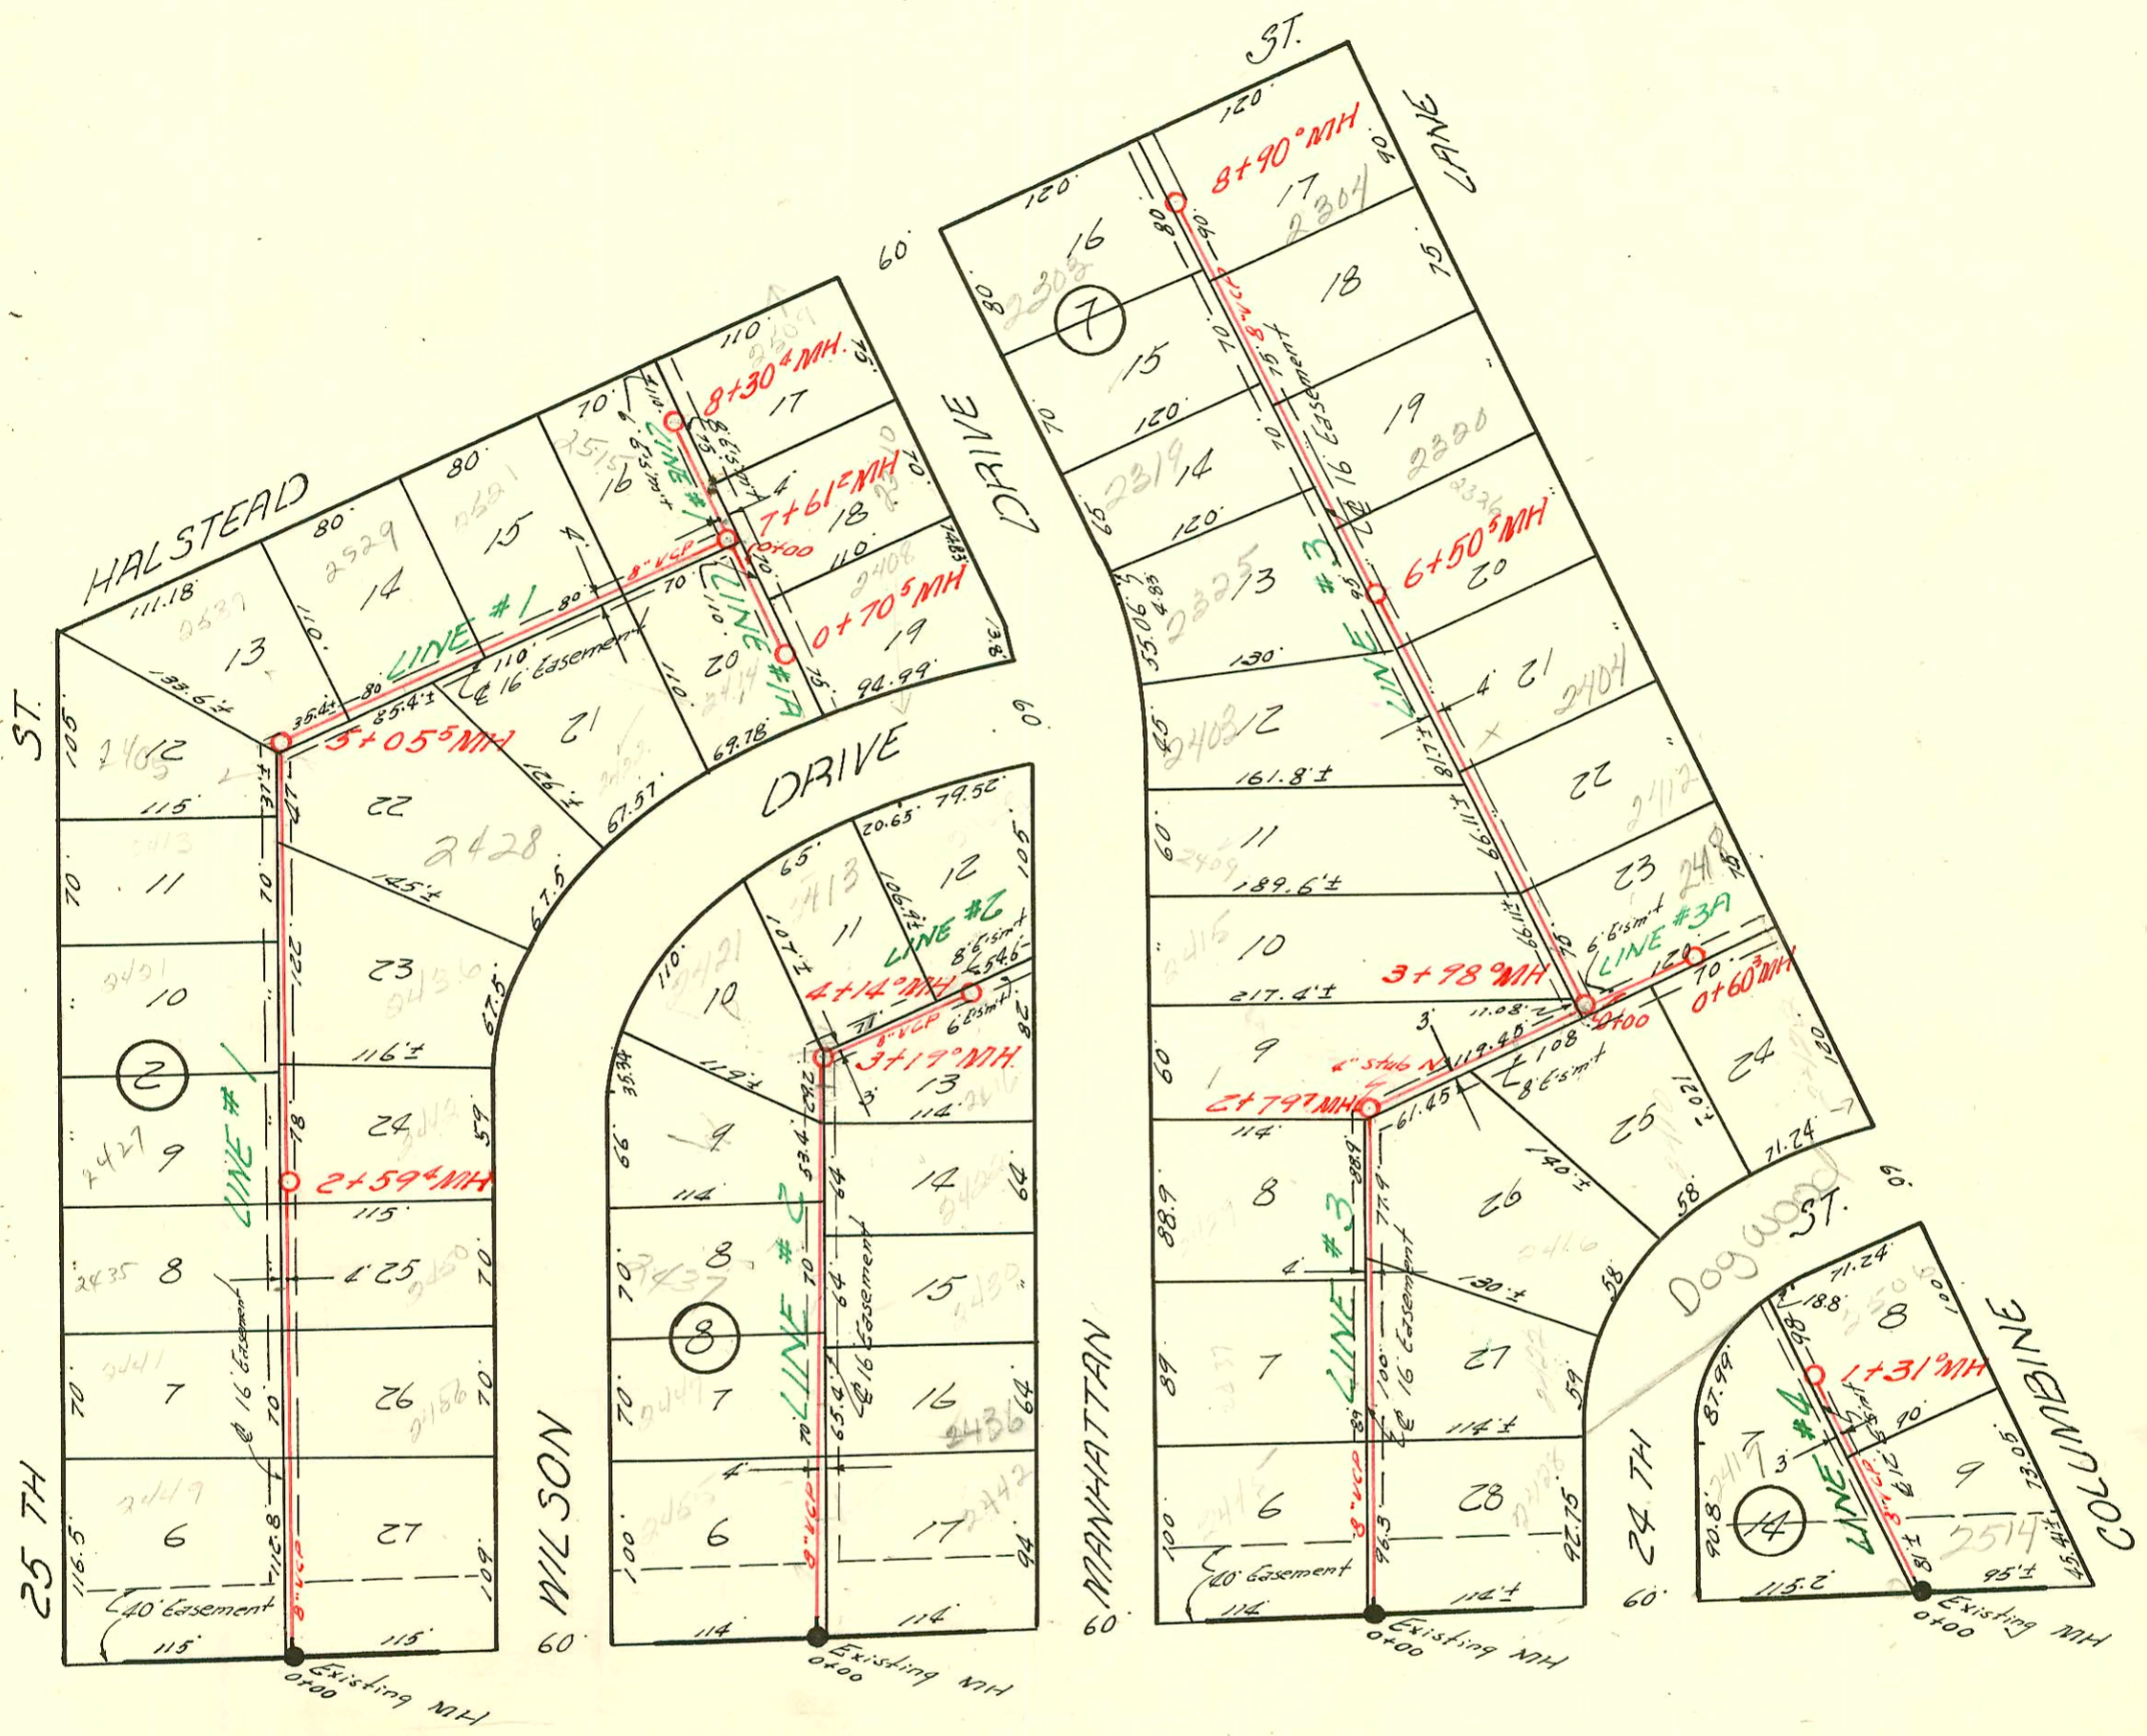

LAT. 26 S.S. #22
 UTILITY CONTRACTOR INC. JULY 19, 56
 BK NO. K-35 PROJ. # C25-103

4742 - Jay - 2442 Manhattan - Ordie - 8-7-57
 11344 Tap 2310 Manhattan Huber Mungenes 9-10-59 7+68.2
 B2550 - tap 2521 Halstead Gray Bros. 12-23-64

CONSTRUCTION RECORD

SERVICE RECORD

STATION	ELEVATION		Depth	MANHOLE	4-INCH "Y" BRANCHES		No. of Permit		House Number		DATE OF PERMITS		
	Ground	Grade			North West	South East	North West	South East	North West	South East	North West	South East	
Line #1 0+00	127.46	117.16	10.30	0+00 Existing MH	+49°	+51°		1705	2462			7-31-56	
1+00	128.5	117.36	11.14		+137°	+39°							
2+00	128.3	117.56	10.74		2+02°		B3958	2435	2450		8-12-65		
	128.2	117.66	10.54	2+59°	2+35°		#1832					8-2-56	
3+00	128.0	117.76	10.24		+73°	+75°							
					+60°		9847	2427 W. 25th St.	2436		2-17-59	8-2-56	
4+00	127.3	117.96	9.34		+09°								
					+74°	+76°	11255	2405 W. 25th St.			8-25-59		
5+00	127.1	118.27 IN 8.83 118.17 OUT 8.93		5+05°	Y WEST	Y EAST		#2042	2428	2429		8-20-56	
					+57°	+55°	8658	5994 Wilson Dr.	2429		11-14-58	1-8-58	
6+00	127.0	118.46	8.54		6+48°	+46°		#2041	2430			8-20-56	
7+00	127.0	118.66	8.34		7+19.2 to 12.1 moly	+19°	15684	2515	2431		5-28-62		
	127.4	118.86 IN 8.54 118.78 OUT 8.62		7+61°	Y SOUTH			20052001	2409 A			8-15-01 8-27-56	
8+00	126.9	118.96	7.94		+68°			#2040					
	126.7	119.02	7.68	8+30°	+98°								
Line #1A 0+00	127.25	118.90	8.35			+175°							
						+42°		#2175	2408			8-30-56	
	127.3	119.02	7.28	0+70°									
Line #2 0+00	127.6	116.70	10.90	0+00 Existing MH	Y NORTH	+615°	+635°	96116417	2450 R	2456	7-14-96	6-10-57	
						+313°	+333°	#1833	#1848	2447	2430	8-2-56	8-2-56
1+00	128.0	117.06	10.94			+91°		6706	#1847	2437	2432	8-2-56	8-2-56
									Wilson Dr.	Wilson Dr.	Manhattan	4-21-58	
2+00	128.1	117.42	10.68			+54°	+56°						
3+00	128.0	117.78	10.22			+10°	+07°	#2052	2434	2421	2416	8-20-56	11-20-57
	128.0	117.94 IN 10.06 117.84 OUT 10.16		3+19°									
4+00	127.4	118.24	9.16			+005°							
	127.4	118.28	9.12	4+14°									
Line #3 0+00	127.6	116.26	11.34	0+00		+445°	+465°	4542	1814	2445	2410	R see below	8-3-56
1+00	128.6	116.46	12.14			+34°	+36°	#1601	#1815	2421	2432	7-26-56	8-3-56
2+00	129.1	116.66	12.44			+174°	+194°	2261	#2063	2409 R	2416	9-10-56	9-10-56
	128.3	116.92 IN 11.38 116.82 OUT 11.48		2+79°	4" stub N.								
3+00	128.5	116.96	11.54			+87° NW							
	128.2	117.25 IN 10.95 117.15 OUT 11.05		3+98°									
4+00	127.8	117.26	10.54		Y NORTH	+255°	+275°	#1606	4062	2412	2418	8-3-56	3-18-57
						+99°							
5+00	127.0	117.46	9.54			+01° K		#4295		2412		4-8-57	
						+84°	+86°	#2272		2404		9-11-56	
6+00	126.9	117.66	9.24										
	126.6	117.76	8.84	6+50°				7336/1704		2326		1-10-83 7-31-56	
						+613		3978		2325		3-11-59	

#1814 - Top - 2410 N York - 8-3-56 - Phillips 4" NW MH 0+00
 #2076 - Top - 2403 Manhattan - 9-11-56 - Phillips
 #1850 - Top - 2401 W. 25th St. - Phillips - 8-3-56
 #1821 - Top - 2419 W. 25th St. - Phillips - 8-3-56
 #1820 - Top - 2413 W. 25th St. - Phillips - 8-3-56
 #1822 - Top - 2411 W. 25th St. - Phillips
 #2499 Top - 2406 Mad Ave Justice 9-21-56
 #2498 Top - 2407 Wilson Justice 9-21-56
 #2488 Top - 2409 Manhattan Justice 10-8-56
 #3386 Top - 2421 Manhattan Justice 12-19-56
 #2065 - Top - 2422 W. 24th St. - Phillips - 8-21-56
 #1719 - Top - 2412 Columbia 7-31-56
 #48216 - Top - 2412 Columbia 2-5-57
 #1815 - Top - 2422 W. 24th St. - Phillips - 2/24/57
 #48323 - Top - 2422 Columbia - Phillips - 2/24/57
 3977 - Top - 2428 W. 24th St. N. - Justice - 3-14-57
 4617 - Top - 2456 Wilson - Reynolds - 9-11-57
 20562 - Top - 2414 Wilson - Henning - 11-15-57 - ()