




Scale 1" = 100'

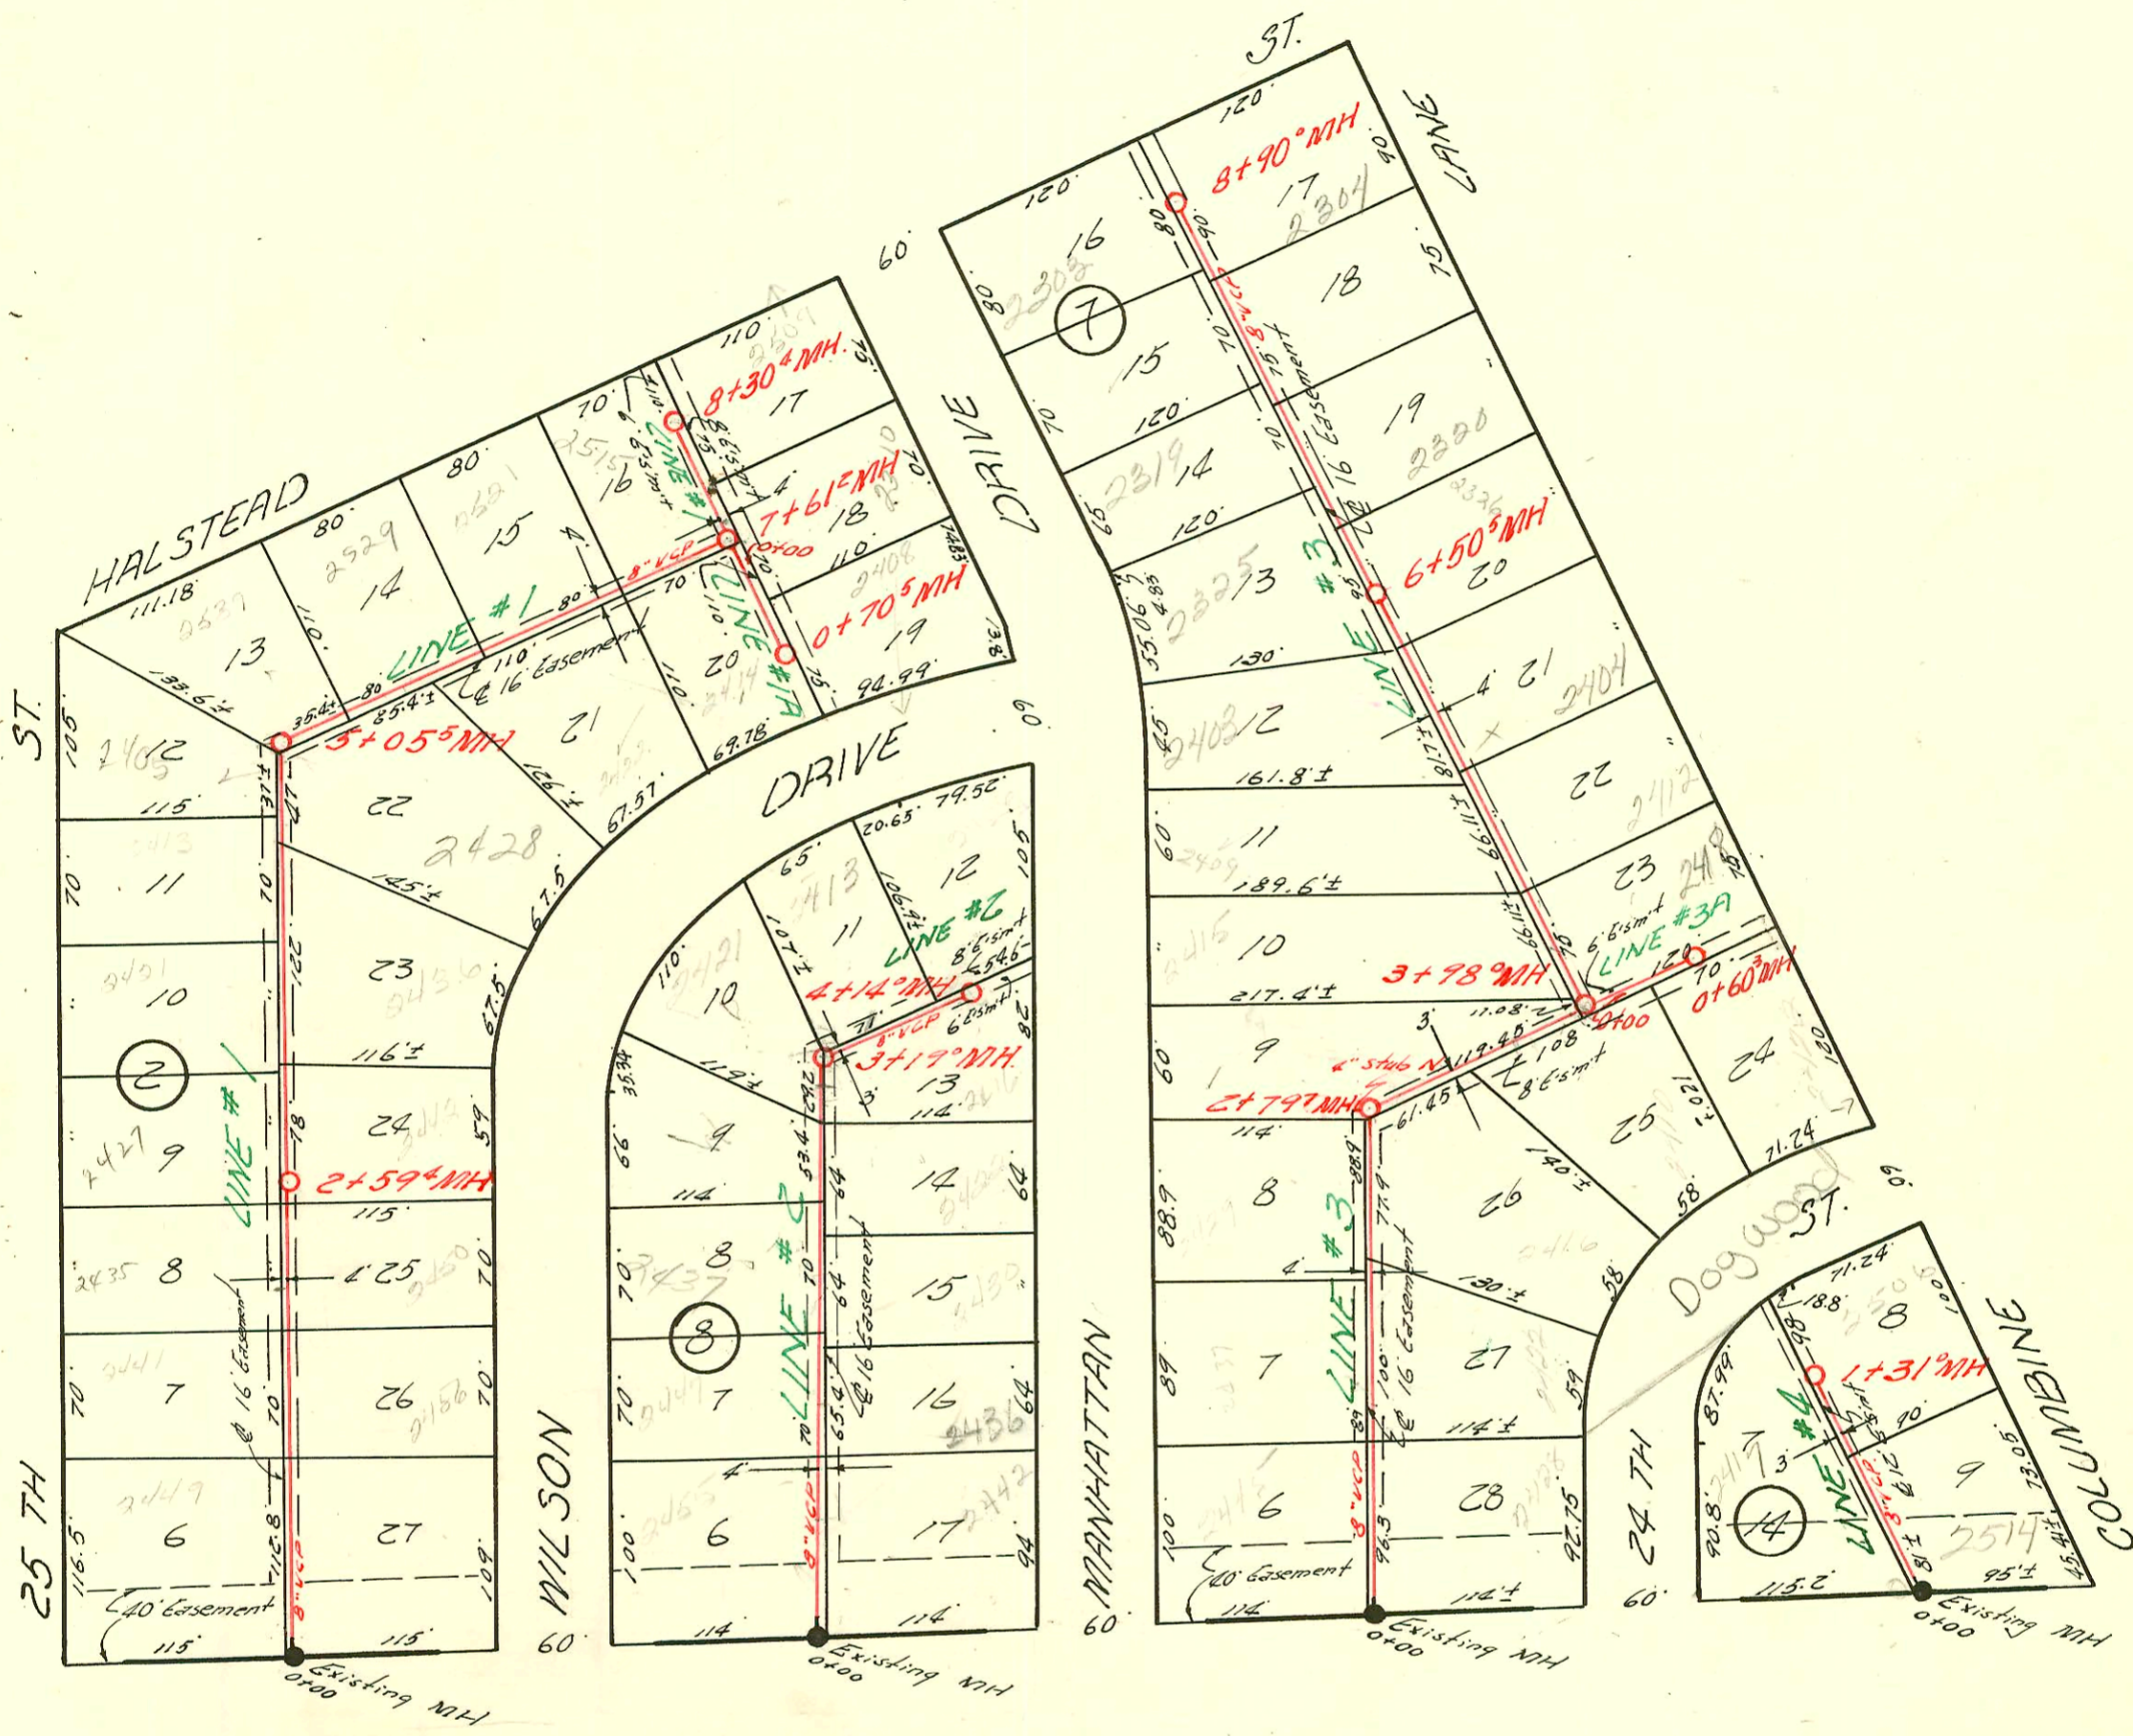

LAT. 26 S.S. #22
 UTILITY CONTRACTOR INC. JULY 19, 56
 BK NO. K-35 PROJ. # C25-103

4742 - Jay - 2442 Manhattan - Ordie - 8-7-57
 11344 Tap 2310 Manhattan Huber Mungenes 9-10-59 7+68.2
 B2550 - tap 2521 Halstead Gray Bros. 12-23-64

CONSTRUCTION RECORD

SERVICE RECORD

STATION	ELEVATION		Depth	MANHOLE	4-INCH "Y" BRANCHES		No. of Permit		House Number		DATE OF PERMITS		
	Ground	Grade			North West	South East	North West	South East	North West	South East	North West	South East	
Line #3 cont. 7+00	126.9	117.86	9.04			+21°		#2272		2820 Columbian		9-11-56	
						+43°		#2276		0519 Manhattan		9-11-56	
8+00	127.3	118.06	9.24			+29°		#3386		Manhattan		12-19-56	
						+78°	+76°	#2277	#2277	2203 Manhattan	2887 Columbian	9-11-56	9-11-56
	126.9	118.24	8.66	8+90°									
Line #3A 0+00	128.45	120.00	8.45	EXISTING MH.		+51° Y.W.		#1813		5400 Columbian		8-3-56	
	127.9	120.24	7.66	0+60°									
Line #4 0+00	129.60	118.80	10.80	Existing MH		+37°		#1254		2514 Columbian		2-25-59	
						+55° (N)		#1852		0506 Columbian		8-3-56	
1+00	128.5	119.30	9.18	+31°		+190							

Tap 2690 2312 Columbian 10-8-56 Just

