


LAT. 24 S.S. # 22
 DEVELOPMENT INC. JULY 18, 1956
 BK. NO. 34-32 PROJ. NO. C25-101
 CK-34

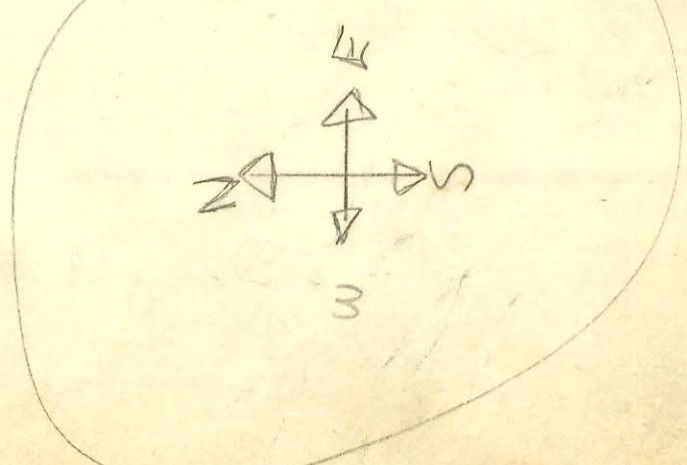

CONSTRUCTION RECORD

SERVICE RECORD

Line # 1

Line # 1A

Line # 2

STATION	ELEVATION		Depth	MANHOLE	4-INCH "Y" BRANCHES		No. of Permit		House Number		DATE OF PERMITS	
	Ground	Grade			North West	South East	North West	South East	North West	South East	North West	South East
0+00	127.5	117.16	10.34	8" stub 2" 0+00 MH								
1+00	127.6	117.46	10.14		0+30°	+45°	B3914		2503 W 25 TA			8-4-65
2+00	127.5	117.76	9.74		+10°	+12°		#1796	2510 Wilson			8-3-56
					+95°	+97°	#1786	7915	2517 W 25th	2518 Wilson		8-3-56
2+00	127.5	117.76	9.74		+81°	+83°	#1787	#1685	2525 W 25th	2526 Wilson		8-3-56
	127.7	118.06	9.64	2+99 ⁵								7-26-56
3+00					+54°	+56°	041484	#1791	2552 Richmond	2534 Wilson		10-2-73
4+00	127.9	118.36	9.54		+89°	+91°				2604 Wilson		5-10-59
5+00	127.9	118.66	9.24		+69°	+71°		6931		2610 Wilson		5-12-58
	128.5	118.96	9.54	5+99 ⁴								
6+00					+37°	+39°	#1789	#1792	2617 W 25th	2616 R Wilson		8-3-56
7+00	128.5	119.26	9.24		+02°	+04°	#1792	#1799	2622 W 25th	2604 Wilson		10-22-56
					+66°	+68°	#1785	6932	2623 W 25th	2630 Wilson		10-28-56
8+00	127.9	119.56	8.34		+33 ⁵	+35 ⁵	#1790		2627 W 25th			8-3-56
	128.4	119.86	8.54	8+99 ⁵	+90°	+92°	#1791	#1821	2703 W 25th	2644 Wilson		8-3-56
9+00	128.4	119.86	8.54									8-3-56
					+62°					2650 R Wilson		12-4-01
10+00	128.5	120.16	8.34		10+27°				2707 W 25th			10-23-56
					+97°	+66°		6933		2650 Wilson		5-12-58
11+00	128.3	120.46	7.84		+55°		#1821		2723 W 25th			8-3-56
	128.6	120.75 in 120.65 out	7.85	11+63 ⁵			#1830		2727 W 25th			8-3-56
12+00	128.6	120.76	7.84		+25 ⁵			5085		2572 Bullinger		7-26-57
	128.5	120.88	7.62	12+40°								
Line # 1A 0+00	128.6	120.77	7.83		Y. WEST							
					+10°			5485		2586 Bullinger		10-22-57
					+53°			586		2578 Bullinger		12-13-57
					+94°		#1839		2607 Wilson			8-3-56
	128.8	121.14	7.66	1+29°								
Line # 2 0+00	128.3	116.70	11.60	8" stub 2" 0+00	Y. NORTH							
					+20°							
					+40 ⁵		#1849		2504 Manhattan			8-3-56
1+00	128.2	117.00	11.20		+26°		#1825		2509 Wilson			8-3-56
					+80°	+78°	#1826	1763	2517 A Wilson	2518 Manhattan		8-3-56
2+00	128.4	117.30	11.10		+70°	+72°	7156	#1851	2525 Wilson	2526 Manhattan		6/9/58
	128.5	117.45	11.05	2+50°	+40	+42°		#1164		2514 Wilson		8-2-57
3+00	128.8	117.60	11.20									
4+00	128.2	117.90	10.30									
5+00	128.2	118.20	10.00	5+00'	+27°	+46°	#1848	12632	2521 B Wilson	2515 Manhattan		10/28/91
					+51°					2610 Manhattan		2-25-59
6+00	128.0	118.50	9.50		+06			10628		2616 Manhattan		6-15-59
					+15°			4619		2617 Wilson		5-10-57
					+87°	+65°	#1849		2623 Wilson	2622 Manhattan		9-7-56
7+00	128.4	118.80	9.6		+25 ²		#1850			2628 Manhattan		9-7-56
					+44°		#1848		2627 Wilson			9-7-56
	128.3	118.95	9.35	7+50 ⁵	+86°			9842		2634 Manhattan		3-31-59
8+00	128.4	119.10	9.30		+10°			6366		2637 Wilson		3-20-58
					+79°	+81°	10494		2643 Wilson	see below		6-10-59

#1860 - no use shown. Tap - 2512 Manhattan - 8-3-56 - Phupp
 #1792 - tap 2504 Wilson - Phupp - 8-3-56
 #1785 - tap 2609 Wilson - Phupp - 8-3-56
 2838 Tap - 2717 W 25th - Mitchell/Warley 10-23-56
 5426 - 2539 Richmond - Mitchell/Warley - 10-23-57
 5564 Tap - 2626 Wilson - 11-5-59 - Henning
 5978 Tap - 2520 Richmond - 8-3-58 - Phupp
 7019 Tap - 2640 Manhattan - R. K. Ray 5-26-58 - Tap 291 EPMH
 10494 - tap 2643 Wilson - Joe McDonald 6-10-59 (8+73.5)
 11871 Tap 2503 Wilson - 8-24-59 0+59

#B3915 - 2509 W 25th - 8-4-65 - Tap (1+26.4)