


Plat 8-72

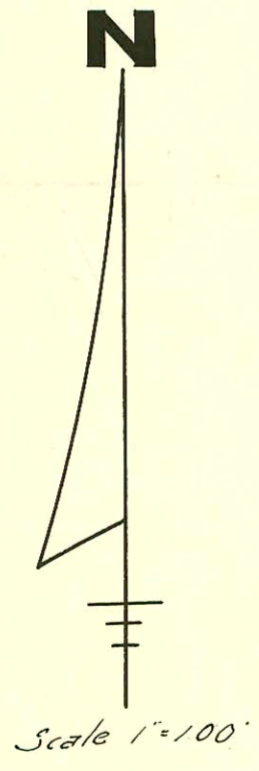

LAT. 4 SUB. 4 S.S. #22  
 DEVELOPMENT INC., JULY 31 '56  
 BK. NO. K-41 PROJ. #C25-44

### CONSTRUCTION RECORD

### SERVICE RECORD

STATION	ELEVATION		Depth	MANHOLE	4-INCH "Y" BRANCHES		No. of Permit		House Number		DATE OF PERMITS	
	Ground	Grade			North West	South East	North West	South East	North West	South East	North West	South East
<i>cont. of line #4</i>												
9+00	191.8	183.84	8.0		+18° +97'	+16° +95'	8261	5928	6417 Magill	6418 Beachy	10-13-58	11-13-57
10+00	193.4 194.8	184.64 185.04	8.8 9.8	10+47°	+71°	+69°	4067		6419 Beachy	6417 Beachy		3-14-57
11+00	194.6	185.79	8.8		+44°	+42°	5355	2654	6405 Magill	6406 Beachy	7-24-57	2-5-57
12+00	196.3	187.29	9.0		+73°	+71°	4066		6402 Beachy			3-14-57
12+37°	197.0	187.89	9.1									
<i>Line #4A</i>												
0+00	190.6	181.65	9.0	Existing MH. 0+00	+74°	+72°						
	190.5	182.50	8.0	0+84°								
<hr/>												
<i>Line #1</i>												
LAT. 4 SUB. 4 S.S. 22												
0+00	99.08	89.60	9.5	Existing MH 0+00								
1+00	100.3	89.80	10.5									
2+00	100.1	90.00	10.1		Tap 2+06.3		C36373		808 W 29th St			12-18-72
3+00	98.6	90.20	8.4		Y WEST Y EAST							
	98.6	90.34 90.21	8.26 8.39	3+05°	+46°	+44°	11724		2954			2-1-56
4+00	98.8	90.87	7.9		4" SORBS 4+08°	4+06°	192-28637 1976		2948 K 2946 Walnut			8-14-52 8-15-56
					+81°	+79°	1916		Walnut			8-10-52
5+00	99.3	91.47	7.8		5+43°	5+41°	1917		2936 Walnut			8-10-52
6+00	99.3	92.07	7.2	5+99°	6+17°	+10°	192-28637 1918		2928 P Walnut			6-9-52 8-10-52
					+90°	+88°	1916		Walnut			8-9-56
7+00	99.5	92.67	6.8		7+60°	+58°	2004 1999		2914 Walnut	Repair City		4-25-54 8-9-52
8+00	99.7	93.27	6.4		8+34°	8+32°	1977	C2662	2902 Walnut	825 Carbarn		8-15-56 8-19-77
	99.7	93.80	5.9	8+88°								
9+00	98.91	93.87	5.0		9+69°	+67°	6227	9643	2888 Walnut	824 Barbara		2-7-51 11-14-83
	99.90	94.08	5.8	9+31°	10+49°	+47°	14013		2852			8-29-61
10+00	100.2	94.47	5.7		11+27°	+25°	1926		2830 Walnut			8-9-52
11+00	99.9	95.07	4.8		12+05°	+03°	1916		2830 Walnut			8-9-52
12+00	100.4	95.67	4.7		+67°	+65°	1919		2829 Walnut			8-10-52
	100.3	96.13	4.2	12+71°								
<i>Line #2</i>												
0+00	100.74	93.95	6.8	Existing MH 0+00	+33°		C6560		2824 S. Sanchez			3-29-78
1+00	100.30	94.15	6.2		+44°	+42°	C67308		(Now 2820 S. Sanchez)			7-12-78
					+02°	+00°	C71713					5-11-79
2+00	99.8	94.35	5.4	2+00°	+67°	+65°	2003 1956		1917 Walnut	2828 Seneca	10-203	8-9-56 1-20-67 (Tap - Rec 9788 14-67)
					+27°	+25°						
					+66°	+64°						
3+00	98.7	94.55	4.1		+28°	+26°	12103		2837 Walnut			12-21-59
	98.9	94.69	4.2	3+72°			1917	62316	1024-26 Barbara	2857 Walnut		8-5-97 12-16-64

#3404 - Tap - 6401 Magill - 513 Beachy - 12-26-56  
 96137871 5048 - 6513 Reynolds 8-5-57  
 93-10522 5436 Tap 6413 Magill - Reynolds 10-10-57  
 10+600 5944 Tap 6409 Magill Reynolds 10-23-57  
 41110 14613 - Tap 28522 Walnut - Frederick Kelly - 8-30-61 11+56.2  
 9615065 - (2805 S. Sanchez) 12-15-78 - Henning - (0+33)  
 #1980 - 1025 W 27th St - Spalding Sons - 2/21/67  
 #1981 - 1027 W 27th St - Spalding Sons - (0+28.8)  
 #C10348 - Seal off - 1025 W 27th St, 2nd - Henning - 9-5-62 (0+28.8)  
 #C19359 - 927 W 27th St 5-18-87 Leon Shallop (Line 2) - TAP 0+08.0