




Woodlawn Village 1st 172.

H 172 A

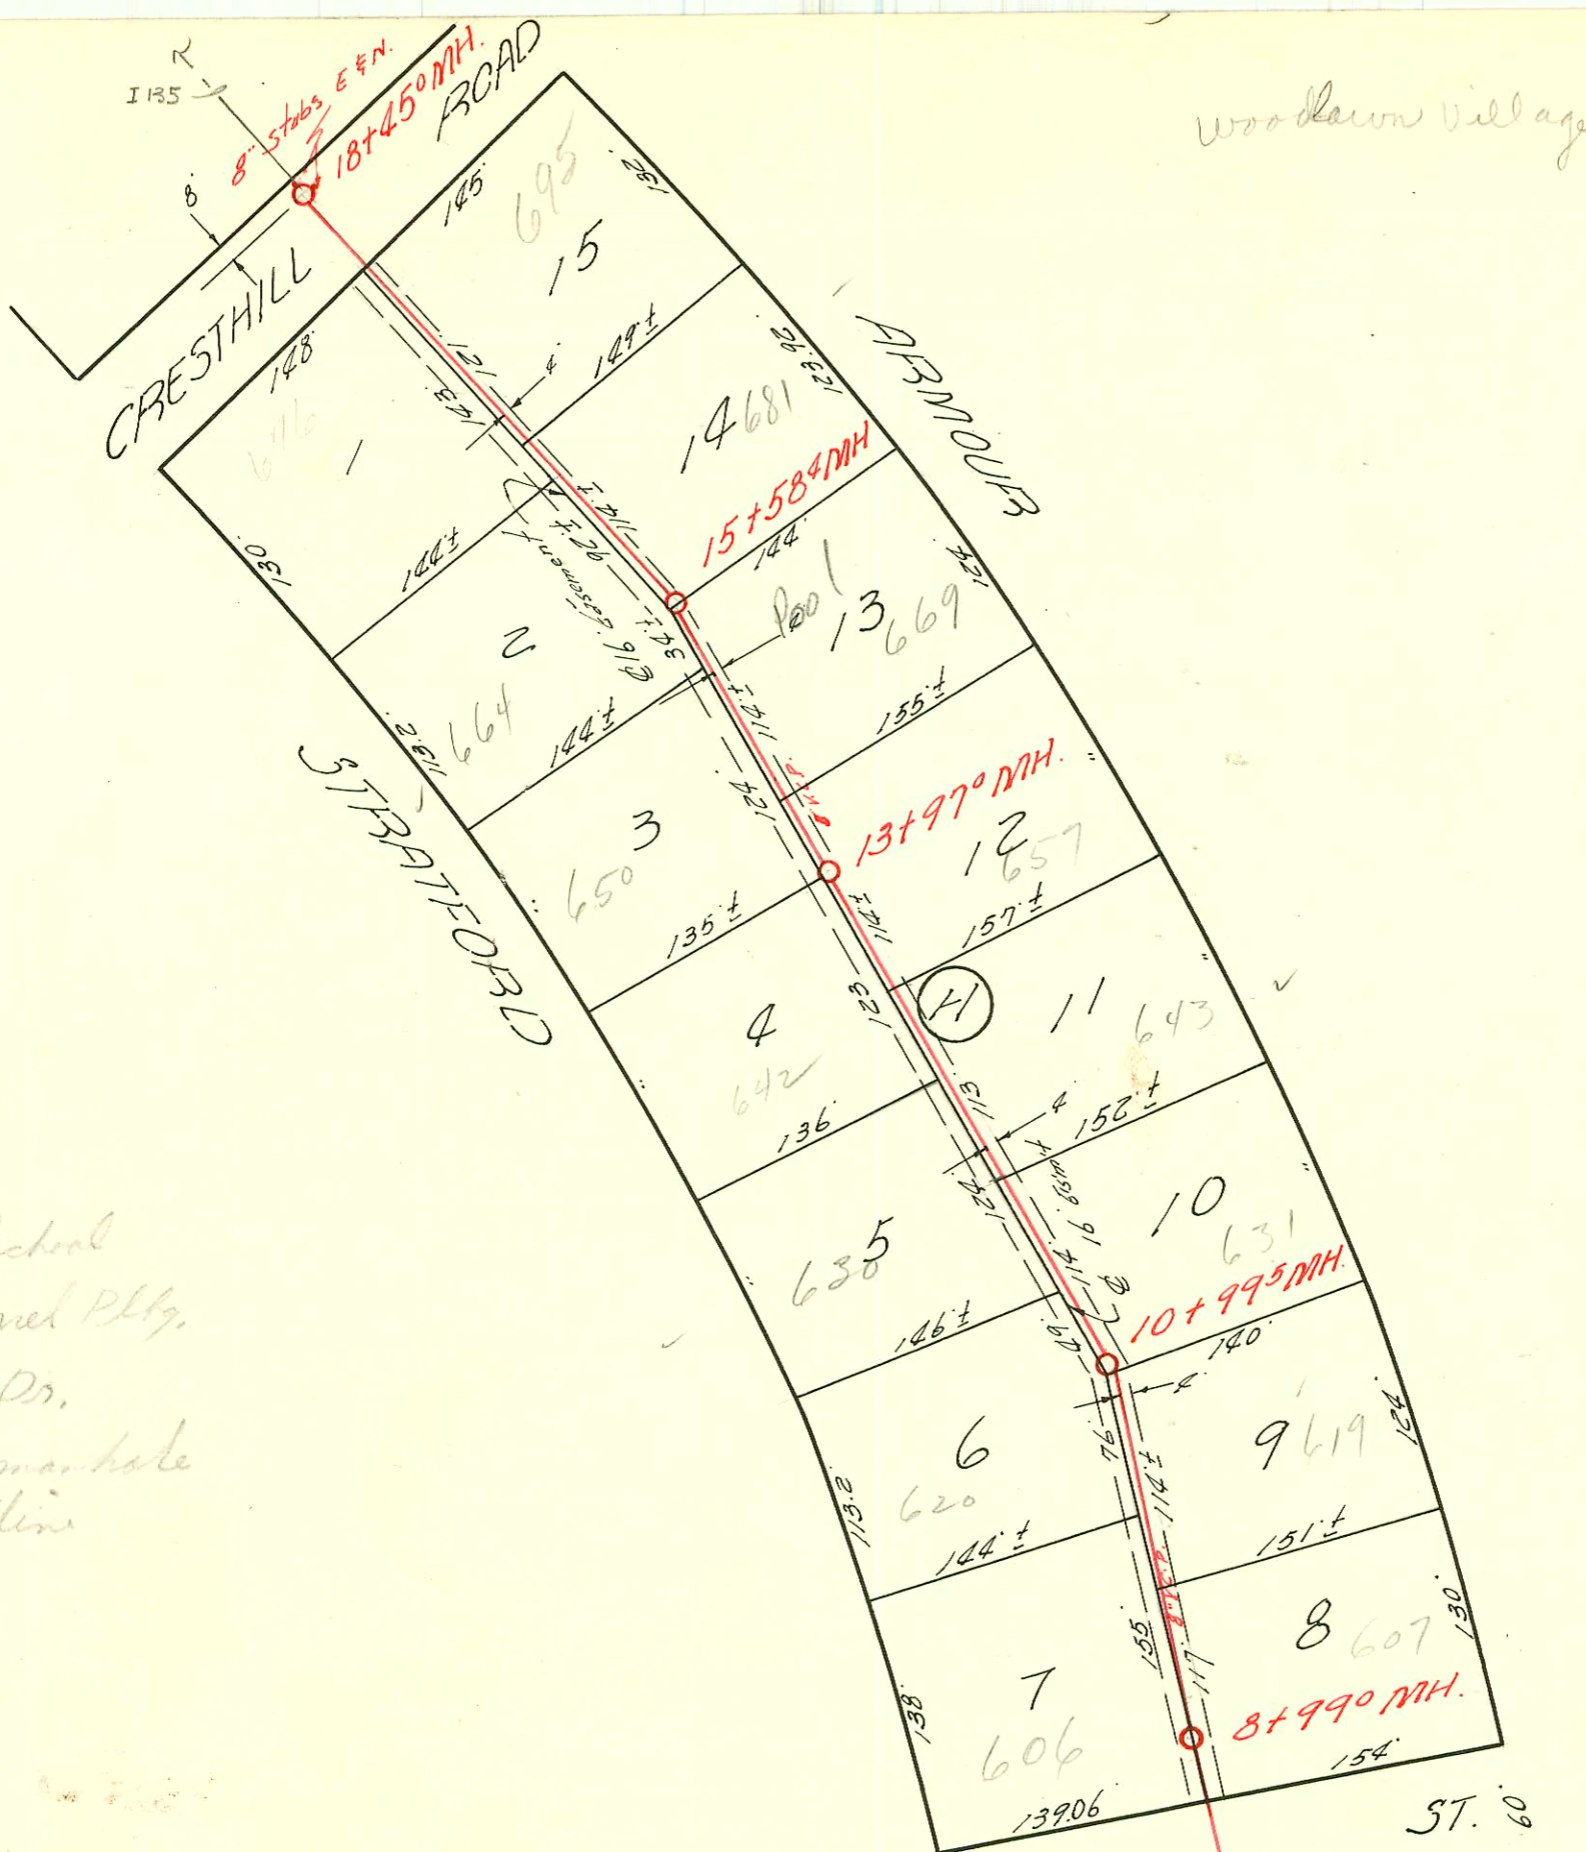

# Miss Harris School  
 # 1933 - Parcel P117,  
 706 Armons Dr.  
 6" stub in manhole  
 8" private line  
 8-13-56

LAT. 4, SUB. 5A W.I.S.  
 UTILITY CONTRACTORS INC. AUG 25 56  
 BK NO. K27, PROJ. #C25-76

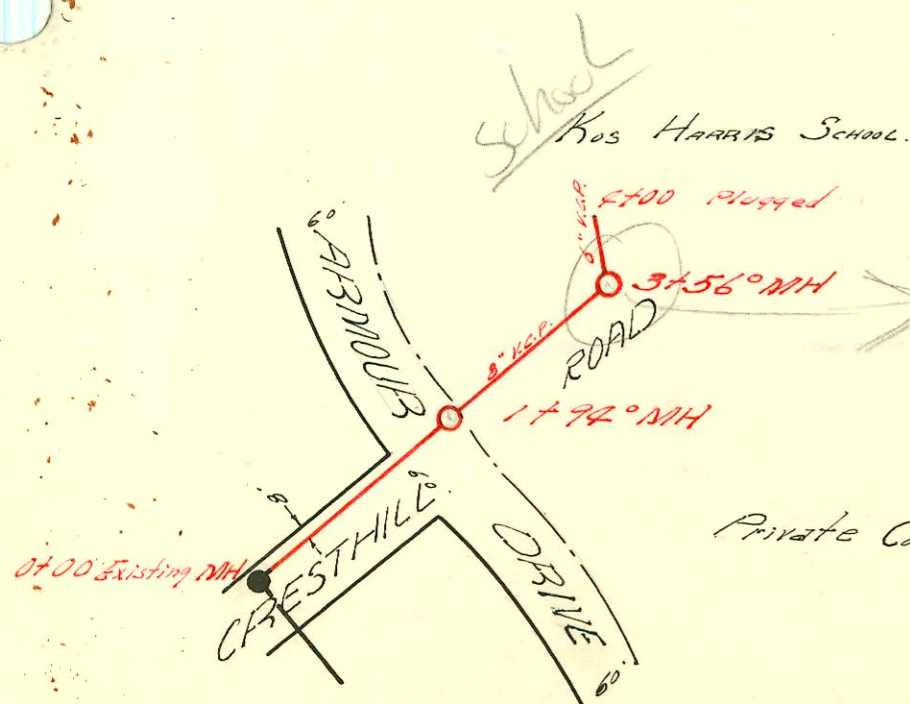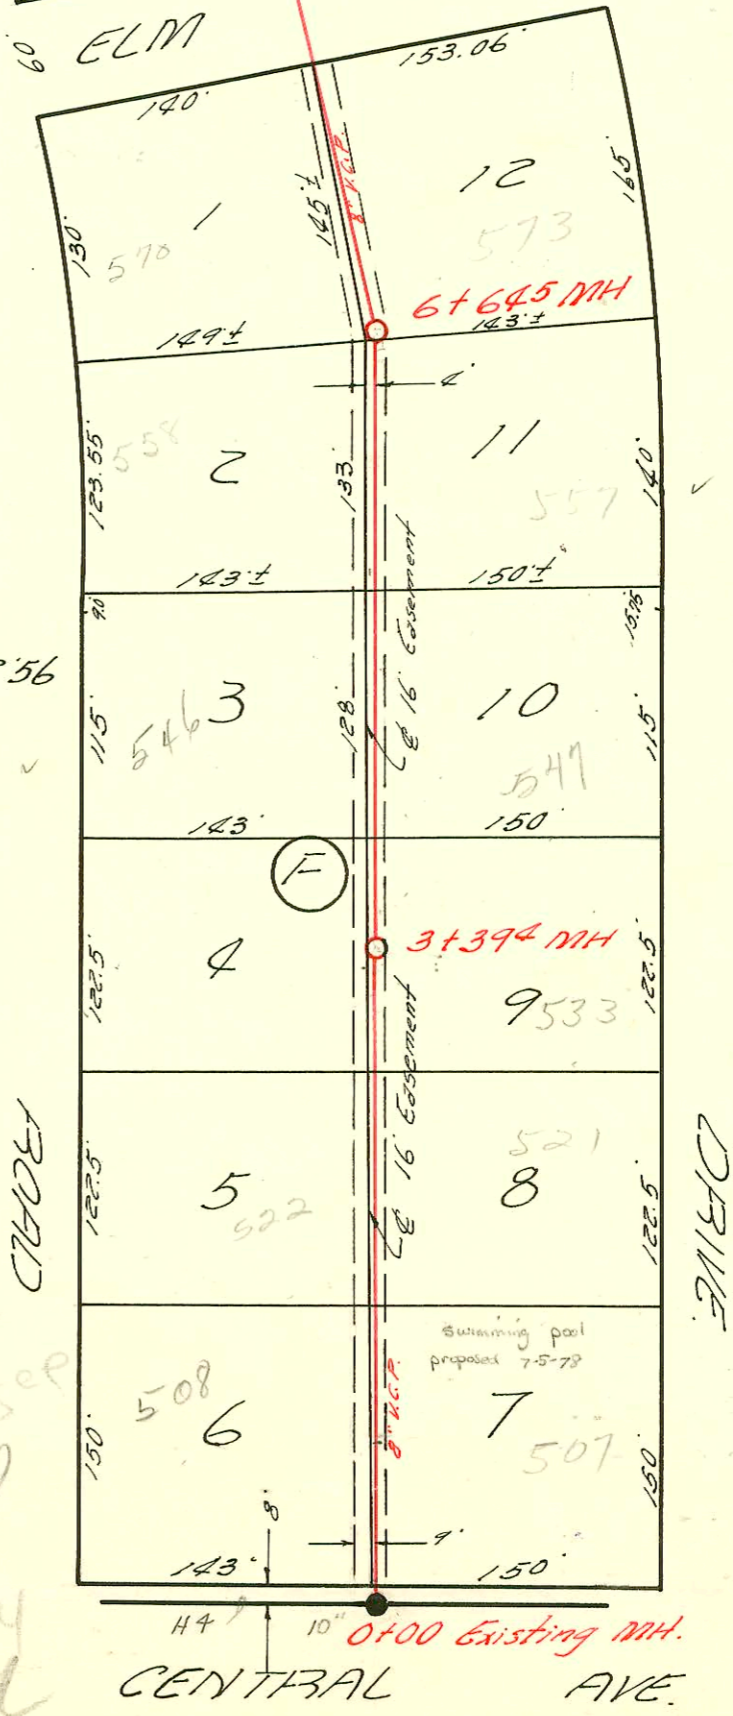

check with  
 Calvin to see  
 if MH tap  
 allowed  
 1/6/54  
 BK

Private Contr. - Utilities

