
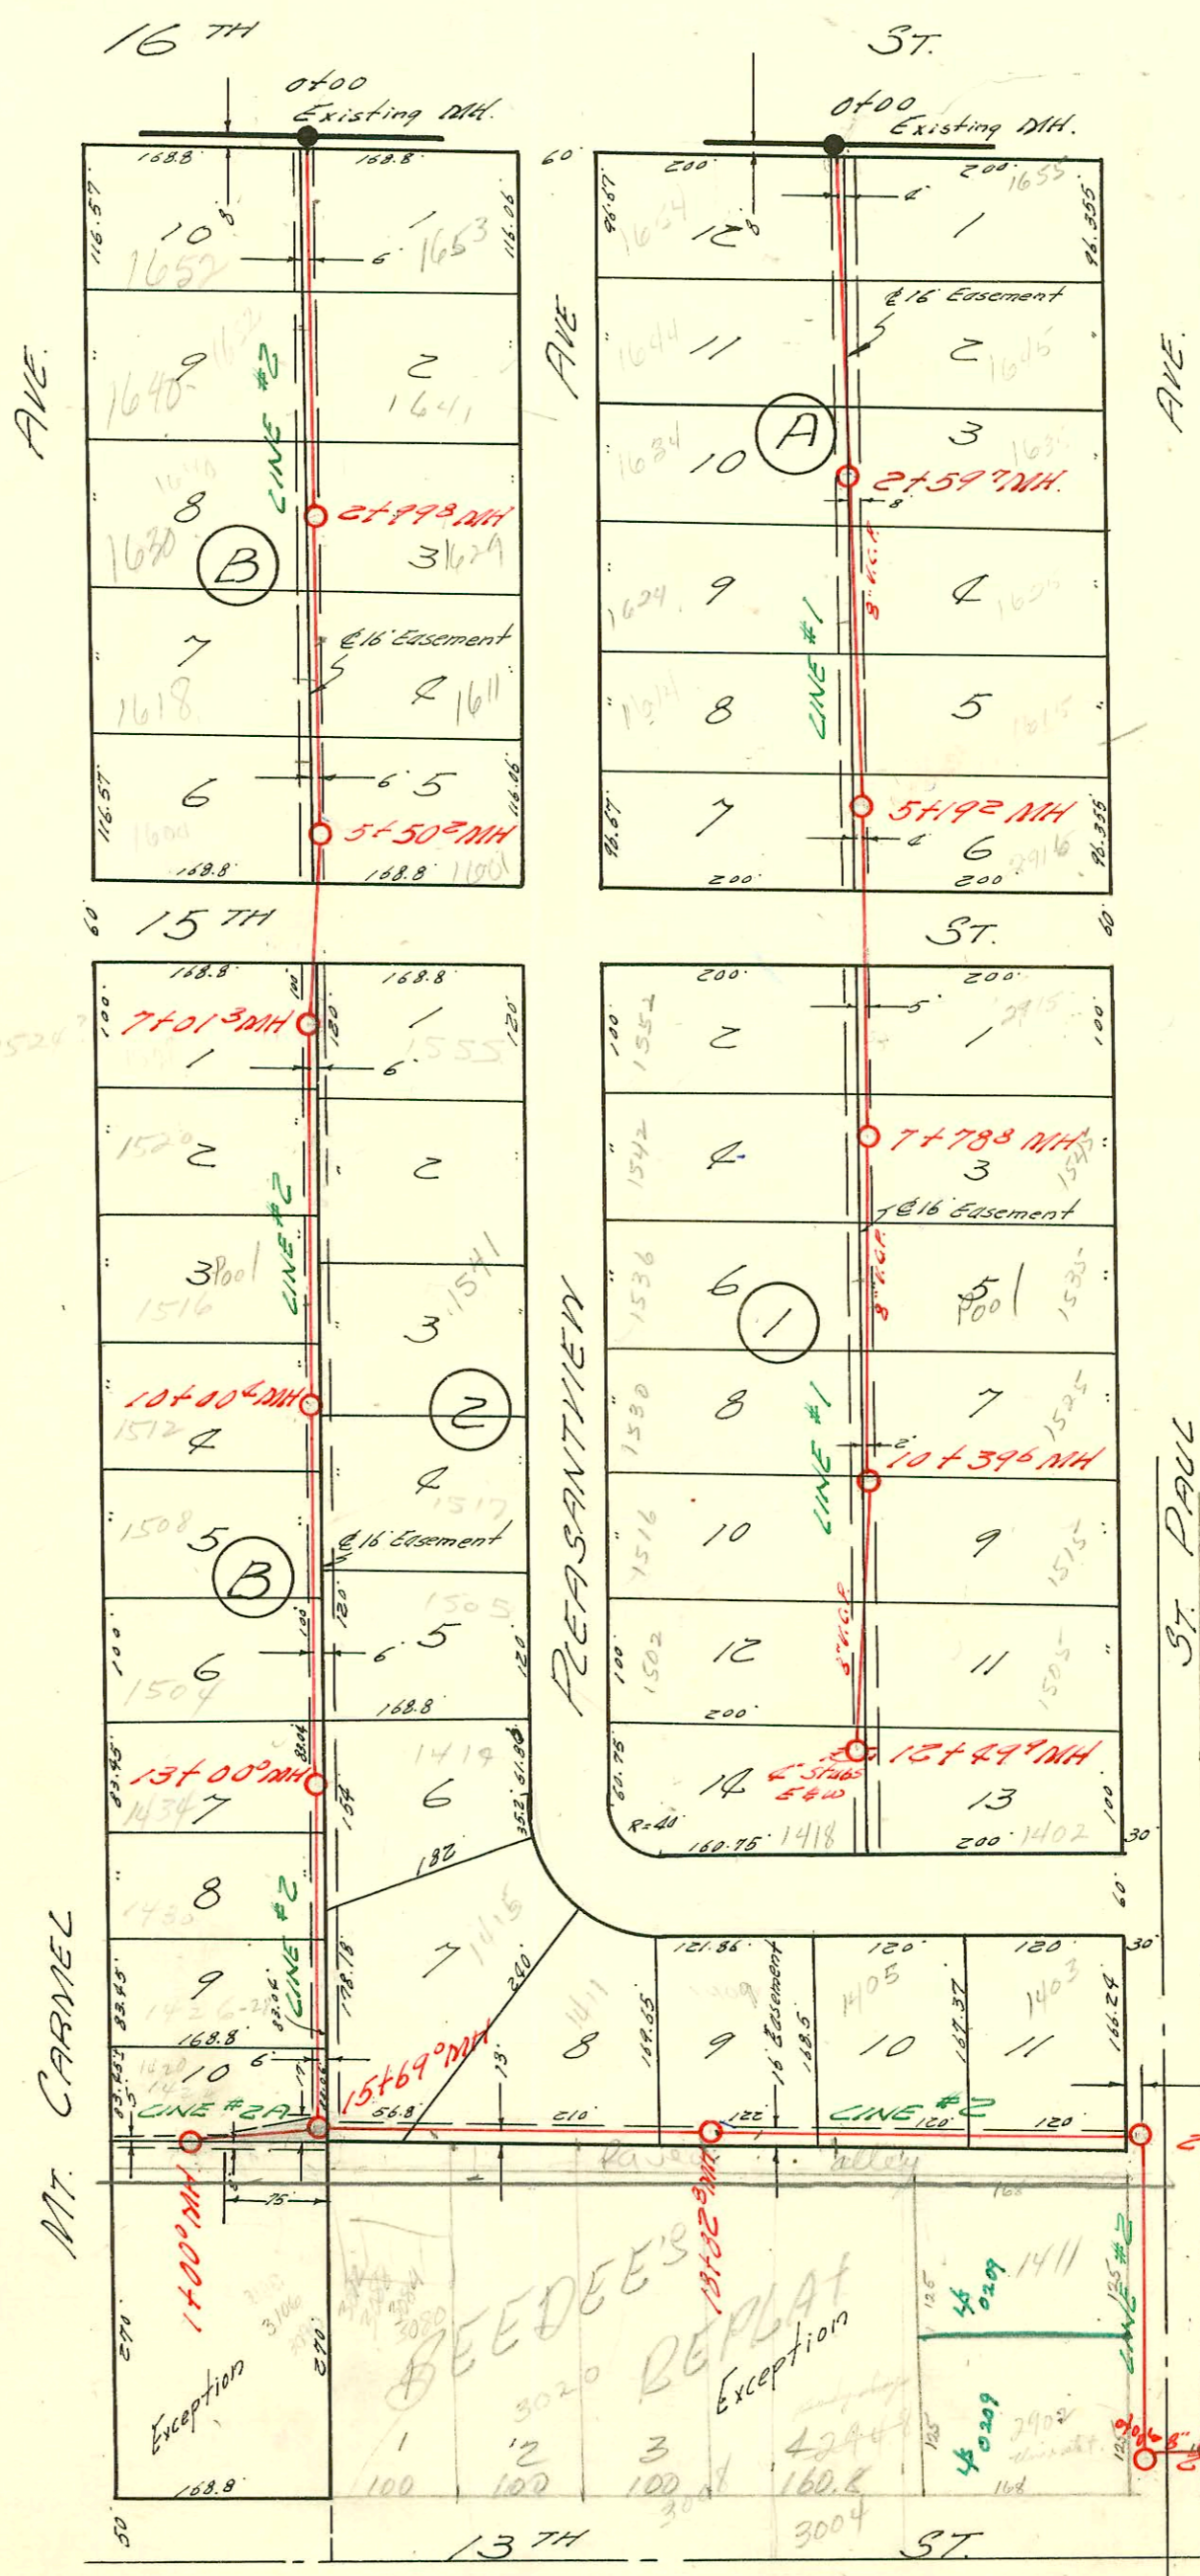


1=150

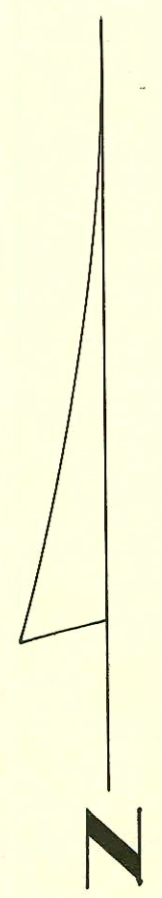

STA.	GRD.	GRADE	DEPTH
0+00	122.1	118.20	3.9
0+20	121.8	118.28	3.0
0+40	120.9	118.36	2.5

BY UTILITY CONTR.
 JUNE 10, 1958
 NO BOOK.

Y.N. 0+38 # 8598
 fire station

LAT. 7 SUB. 10 S.S. #22
 W. B. CARTER CONSTR. CO. SEPT. 13 '56
 BK NO. K-71 PROJ. NO. C 26-56

CONSTRUCTION RECORD

SERVICE RECORD

Line #1

STATION	ELEVATION		Depth	MANHOLE	4-INCH "Y" BRANCHES		No. of Permit		House Number		DATE OF PERMITS	
	Ground	Grade			North West	South East	North West	South East	North West	South East	North West	South East
0+00	124.1	112.6	11.5	Existing MH.								
					+849	+677	#2488	#295	1664 Pleasantview	1035 St Paul	9-20-56	7-26-57
1+00	124.0	113.0	11.0									
					+532	+473	#2483	#2483	1624 Mc Pleasantview	1645 Pleasantview	3-6-01	9-20-56
2+00	123.4	113.4	10.0									
					+500	+480	#2485	#2485	1634 Pleasantview	1635 Pleasantview	9-20-56	9-20-56
3+00	123.4	113.7	9.7	2+597								
					+434	+416	#2821	#242	1624 Mc Pleasantview	1625 Pleasantview	2-26-01	2-21-01
4+00	122.8	114.2	8.6									
					+527	+363	#2480	#2480	1614 Pleasantview	1615 Pleasantview	9-20-56	9-20-56
5+00	122.7	114.6	8.1									
					+050	+030	16259	#2479	1600 Pleasantview	1616 Pleasantview	10-17-62	9-20-56
6+00	122.7	114.7	8.0	5+190								
7+00	122.7	115.0	7.7									
8+00	122.7	115.0	7.7									
