

GLENN AVE.

1	100	60
2	127.85' NH	59
3	10	58
4	5	57
5		56
6		55
7		54
8		53
9		52
10		51
11		50
12		49
13		48
14		47
15		46
16	101.0' NH	45
17		44
18		43
19		42
20		41
21		40
22		39
23		38
24		37
25		36
26		35
27		34
28	77.518' NH	33
29		32
30	100	31



ORIENTA BLVD.


1	100	60
2		59
3		58
4		57
5		56
6		55
7		54
8	57.0' NH	53
9		52
10		51
11		50
12		49
13		48
14		47
15		46
16		45
17		44
18		43
19		42
20	27.49' NH	41
21		40
22		39
23		38
24		37
25		36
26		35
27		34
28		33
29		32
30	100	31

BENNETTE AVE.

LAT. 19, SUB. 3, S.S. 22
 DEVELOPMENT, INC. SEPT. 17 '56
 BK NO. K-36 PROJ # C26-53


Sealed

TRAP AREA

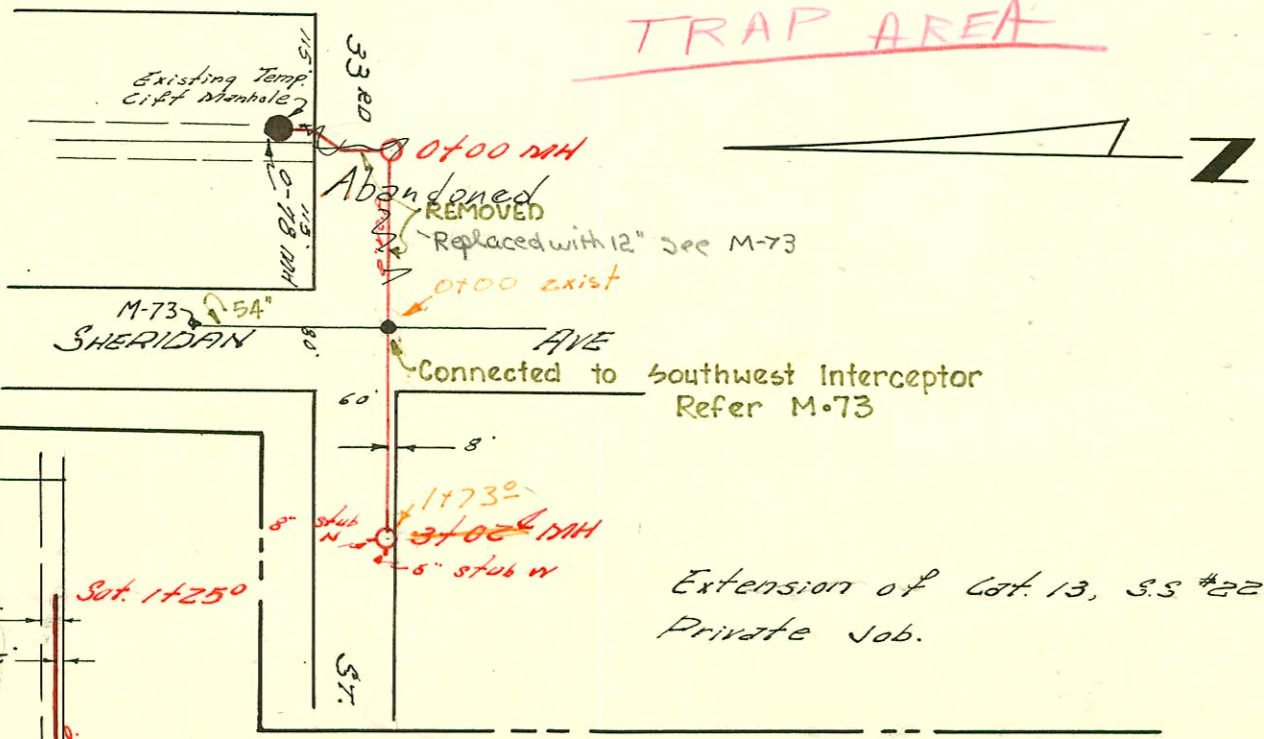

Extension of Lot 13, S.S. #22
 Private Job.

SEE PAGE 108
 LAT. 36, S.S. #22
 Private Contract.

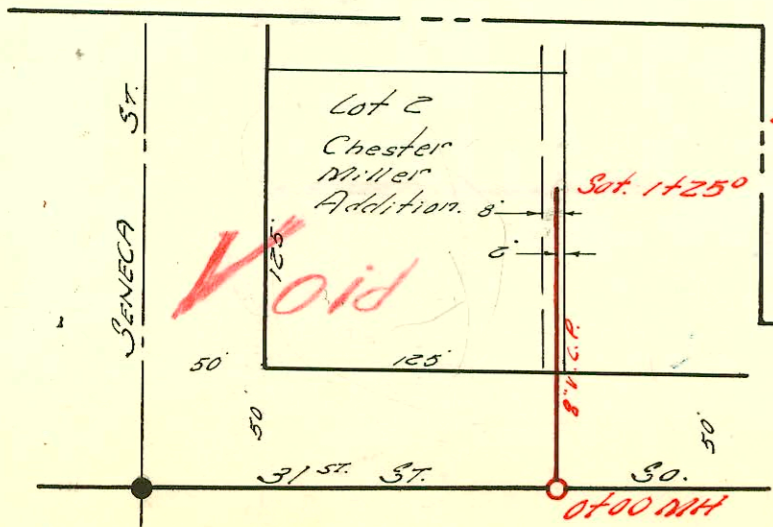

1-198

CONSTRUCTION RECORD						SERVICE RECORD						
STATION	ELEVATION		Depth	MANHOLE	4-INCH "Y" BRANCHES		No. of Permit		House Number		DATE OF PERMITS	
	Ground	Grade			North West	South East	North West	South East	North West	South East	North West	South East
0+00	98.5	92.1	6.4	Existing M.H.	+927	+927						
1+00	99.0	92.3	7.0		+828	+868						
2+00	99.0	92.5	6.5		+823	+843						
	98.6	92.6	6.0	2+496	+199	+219						
3+00	98.8	92.7	6.1		+696	+716						
					+119							
					+359	+379						
					+630							
					+805	+825						
4+00	98.6	92.9	5.7		+058	+078	4996		2078 Anita		8-9-51	
					+368	+388						
					+625	+645						
					+901	+921						
5+00	98.7	93.1	5.6	5+00°	+401	+421						
					+714							
					+976	+996	3072		26458 Anita		11-19-56	
6+00	99.0	93.3	5.7		+377							
7+00	99.0	93.5	5.5		+396	+416						
	98.4	93.6	4.8	7+518	+840	+860						
8+00	98.7	93.7	5.0		+230	+256						
					+596	+616						
					+820	+840						
9+00	98.5	93.9	4.6		+314	+334						
					+679	+699						
					+905	+925						
10+00	98.3	94.1	4.2		+393	+413						
				10+012	+840	+860						
11+00	99.3	94.3	5.0		+220	+240						
					+520	+540						
						+917						
12+00	99.6	94.5	5.1		+430	+450	42913		3301		10-26-56	
					+775	+795						
	99.0	94.7	4.3	12+856								
EXTENSION OF LAT. 13 S.S. #22 "PRIVATE"												
0-78	100.4	85.7	14.7	TEMP. LIFT STATION.								
0-376	98.6	85.8	12.8									
0+00	98.4	86.0	12.4	0+00°								
1+00	99.6	86.3	13.3									
2+00	99.7	86.6	13.1									
3+00	99.5	86.9	12.6									
	99.7	86.9	12.8	3+024	8" stub N 6" stub N to School				11467-3345W 33rd		7-21-61	
LAT. 36 S.S. #22 "Private Contract"												
0+00	94.7	89.5	5.2									
1+00	95.1	89.7	5.4									
1+25	95.2	89.8	5.4									

See PAGE 108

3073 6 on 4 wgs 2011 Anita 11-19-51
 4756 6 on 6 wgs 2039 Dallas 7-2-57
 4986 Tap - 2078 Anita 8-11-57
 15865 Seal off. Chis. lin. 3345W, 33rd St. Gene Bricker 7-10-62
 16007 Tap. 3345W, 33rd St. (School) Darrell Williams 8-10-62 (3+02.4 m.H.)
 254709 3345W, 33rd St. (School) Ted Jones 4-8-76