


Note  
184 N West St  
assigned an add'l  
address of 790 N West  
on 3/3/2000  
BK

LAT. 31 S.S. #22  
UTILITY CONTRACTORS INC., 25 SEPT 36  
BK. NO. K-43 PROJ # C26-6

#15664 tap 711 on bridge on Bluff St 5-22-62  
#4014 tap 760 N. West St. by S. by 8-25-65

SANITARY SEWER ABANDONMENT  
FOR NBW BUILDING ADDITION  
PROJ. NO. N/A  
BUILT BY BRADFORD CO.  
BOOKED 7-17-97 JKB FROM AS BOOK

Scale 1" = 150'

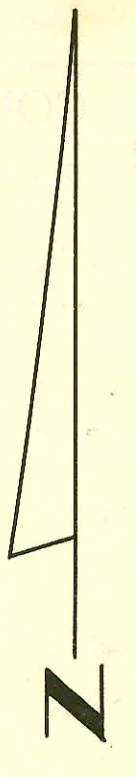

812 S/B  
808  
wants  
Double  
line  
10/2

KESSLER

THEODORE

JOANN

GON

SHERIDAN

AVE.

CONSTRUCTION RECORD

SERVICE RECORD

LINE #5

LINE #6

LINE #6A

LINE #7

STATION	ELEVATION		Depth	MANHOLE	4-INCH "Y" BRANCHES		No. of Permit		House Number		DATE OF PERMITS	
	Ground	Grade			North West	South East	North West	South East	North West	South East	North West	South East
0+00	122.6	114.6	8.0									
1+00	122.9	114.7	8.2									
2+00	122.7	114.9	7.8	1+466								
3+00	123.5	115.0	8.5	3+294								
4+00	122.6	118.1	4.5									
5+00	122.9	118.4	5.5									
6+00	123.4	115.1	8.3	0+00	Y WEST	Y EAST						
7+00	122.2	115.2	7.0	1+228								
8+00	122.4	115.3	7.1									
9+00	121.6	115.5	6.1									
10+00	121.8	115.7 IN	6.1	3+803								
11+00	121.2	115.7	5.5	4+023								
12+00	122.1	115.9	6.2									
13+00	121.9	116.0	5.9									
14+00	121.9	116.2 IN	5.7	6+289								
15+00	122.0	116.2	5.8									
16+00	121.9	116.4	5.0									
17+00	121.0	116.4	4.6	8+468								
18+00	122.0	116.5	5.5									
19+00	121.5	116.6	4.9									
20+00	121.6	116.7	4.9	10+956								
21+00	122.5	116.8	5.7									
22+00	121.8	116.95	4.8									
23+00	122.0	117.0	5.0	13+403								
24+00	121.9	116.1	5.8	0+00								
25+00	122.2	116.3	5.9									
26+00	122.2	116.5	5.7									
27+00	121.4	113.7	7.7									
28+00	121.8	114.1	7.7									
29+00	122.3	114.5	7.8	1+995								
30+00	121.1	114.9	6.2									
31+00	121.7	115.2	6.5	3+900								
32+00												

#2609 - no way shown - 2910 W. Main - 9-27-56, Suederick #4564 - Sep - Nels - 3803 W 9th 5-21-57  
 #2606 - 6 on 8 - 2920 W. 8th - Suederick - 10-4-56  
 2671 6 on 8 3824 W 8th Suederick 10-2-56  
 2001-00113 2672 6 on 8 3802 W 8th R Suederick 10-8-56 - See next pg  
 2783 6 on 8 3730 W 8th Suederick 10-2-56 (Hemming 2-23-93)  
 9572977 2120 - 6 on 8 - 2722 R W. 8th Suederick - 10-18-56  
 22884 70700 - Sep - 3812 W. 8th R Suederick - 10-9-56 (TAP 1543 E of MH 8+468) 4-10-89  
 #27030 - 812 N. Kent St - 9/2/71 (T+32.4)

936571-7 3-30-93 824 N. West - Red's Pkby -  
 North Bldg - 4" PVC 40' - tied into existing 4" ABS 40' line that  
 served "South Bldg" 10' west of EPL and 44' north  
 of SPL. 1/4" pt shallow - All plumbing removed from "South Bldg"

2001-00113-1/17/01- 3802 W 8th St - RD Campbell- 4" SCA40- Replace about 60' of pipe at house- ITWIN CO, 2H22