


300 Blvd.

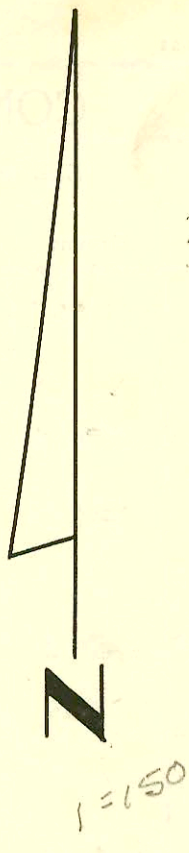

812 S/B
 808
 10 Per
 wants
 Double
 Unclear
 10/2

Note
 184 N West St
 assigned an add'l
 address of 790 N West
 on 3/3/2000
 BK

LAT. 31 S.S. #22
 UTILITY CONTRACTORS INC., 25 SEPT 36
 BK. NO. K-43 PROJ # C26-6

#15664 tap 711 on bridge on Blt Dist 5-22-62
 #4014 tap 760 N. West St. by S. by 8-25-65

SANITARY SEWER ABANDONMENT
 FOR NBW BUILDING ADDITION
 PROJ. NO. N/A
 BUILT BY BRADFORD CO.
 BOOKED 7-17-97 JKB FROM AS BOKE

Scale 1"=150'

AVE.

SHERIDAN

AVE.

CONSTRUCTION RECORD						SERVICE RECORD						
STATION	ELEVATION		Depth	MANHOLE	4-INCH "Y" BRANCHES		No. of Permit		House Number		DATE OF PERMITS	
	Ground	Grade			North West	South East	North West	South East	North West	South East	North West	South East
LATERAL LINE 1 0+00	74.38	62.03	12.4	EXISTING	4" STUB NW	4" STUB SW						
	76.00	62.22	13.8	0+64.2	8" STUB W	8" STUB S						
1+00	74.0	62.43	11.6									
2+00	73.7	62.73	11.0									
3+00	73.7	63.03	10.7									
	76.0	63.15	12.9	3+40.2	8" STUB W							
4+00	73.7	63.33	10.4									
	76.0	63.51	12.5	4+62.4	4" STUB NW							
5+00	74.2	63.63	10.6									
6+00	74.0	63.93	10.1									
7+00	74.2	64.23	10.0									
	76.5	64.31	12.2	7+29.0	4" STUB NW	4" STUB SW						
8+00	74.5	64.53	10.0									
9+00	75.2	64.83	10.4									
	75.5	64.84	10.7	9+04.8	4" STUB NW	4" STUB SW	15299		2242		12-18-85	
		64.94	10.6						Lockwood			
10+00	74.7	65.23	9.5						2238		12-18-85	
									Lockwood			
11+00	74.5	65.53	9.0						2232		12-18-85	
									Lockwood			
12+00	75.4	65.83	9.6						2228		12-18-85	
	77.0	65.97	11.0	12+46.3			15294		Lockwood			
									2216		12-18-85	
13+00	74.6	66.13	8.5						Lockwood			
									2212		12-18-85	
14+00	74.5	66.43	8.1						Lockwood			
									2208		12-18-85	
15+00	74.7	66.73	8.0						Lockwood			
	76.0	67.02	9.0	15+97.4			15289		2204		12-18-85	
									Lockwood			
16+00	74.5	67.03	7.5						2198		12-18-85	
									Lockwood			
17+00	74.8	67.33	7.5						2194		12-18-85	
									Lockwood			
18+00	75.0	67.63	7.4						2188		12-18-85	
									Lockwood			
19+00	75.2	67.93	7.3						2184		12-18-85	
	76.0	68.16	7.8	19+77.8			15286		Lockwood			
									2178		12-18-85	
20+00	75.2	68.23	7.0						Lockwood			
									2174		12-18-85	
21+00	75.0	68.53	6.5						Lockwood			
									2170		12-18-85	
22+00	75.3	68.83	6.5						Lockwood			
									2166		12-18-85	
23+00	78.0	69.13	8.9						Lockwood			
	77.0	69.21	7.8	23+27.6			12379		2162		10-24-84	
									Lockwood			
24+00	77.9	69.43	8.5						2158		5-17-84	
									Lockwood			
25+00	80.2	69.73	10.5						2154		5-17-84	
									Lockwood			
26+00	79.5	70.03	9.5						2150		5-17-84	
									Lockwood			
27+00	79.7	70.33	9.4						2146		3-18-83	
	78.5	70.42	8.1	27+28.8			9099		Lockwood			
									1828		12-6-83	
28+00	79.2	70.63	8.6						Lockwood			
									1824		3-13-84	
29+00	78.0	70.93	7.1						Lockwood			
									1820		12-6-83	
									1816		12-6-83	
									Lockwood			
									1812		3-21-83	
									Lockwood			
									1808		2-21-83	
									Lockwood			
									1804		12-6-83	
									Lockwood			
									1800		12-6-83	
									Lockwood			
									1796		1-20-83	
									Lockwood			

CONT'D NEXT PAGE

H208A