


H217

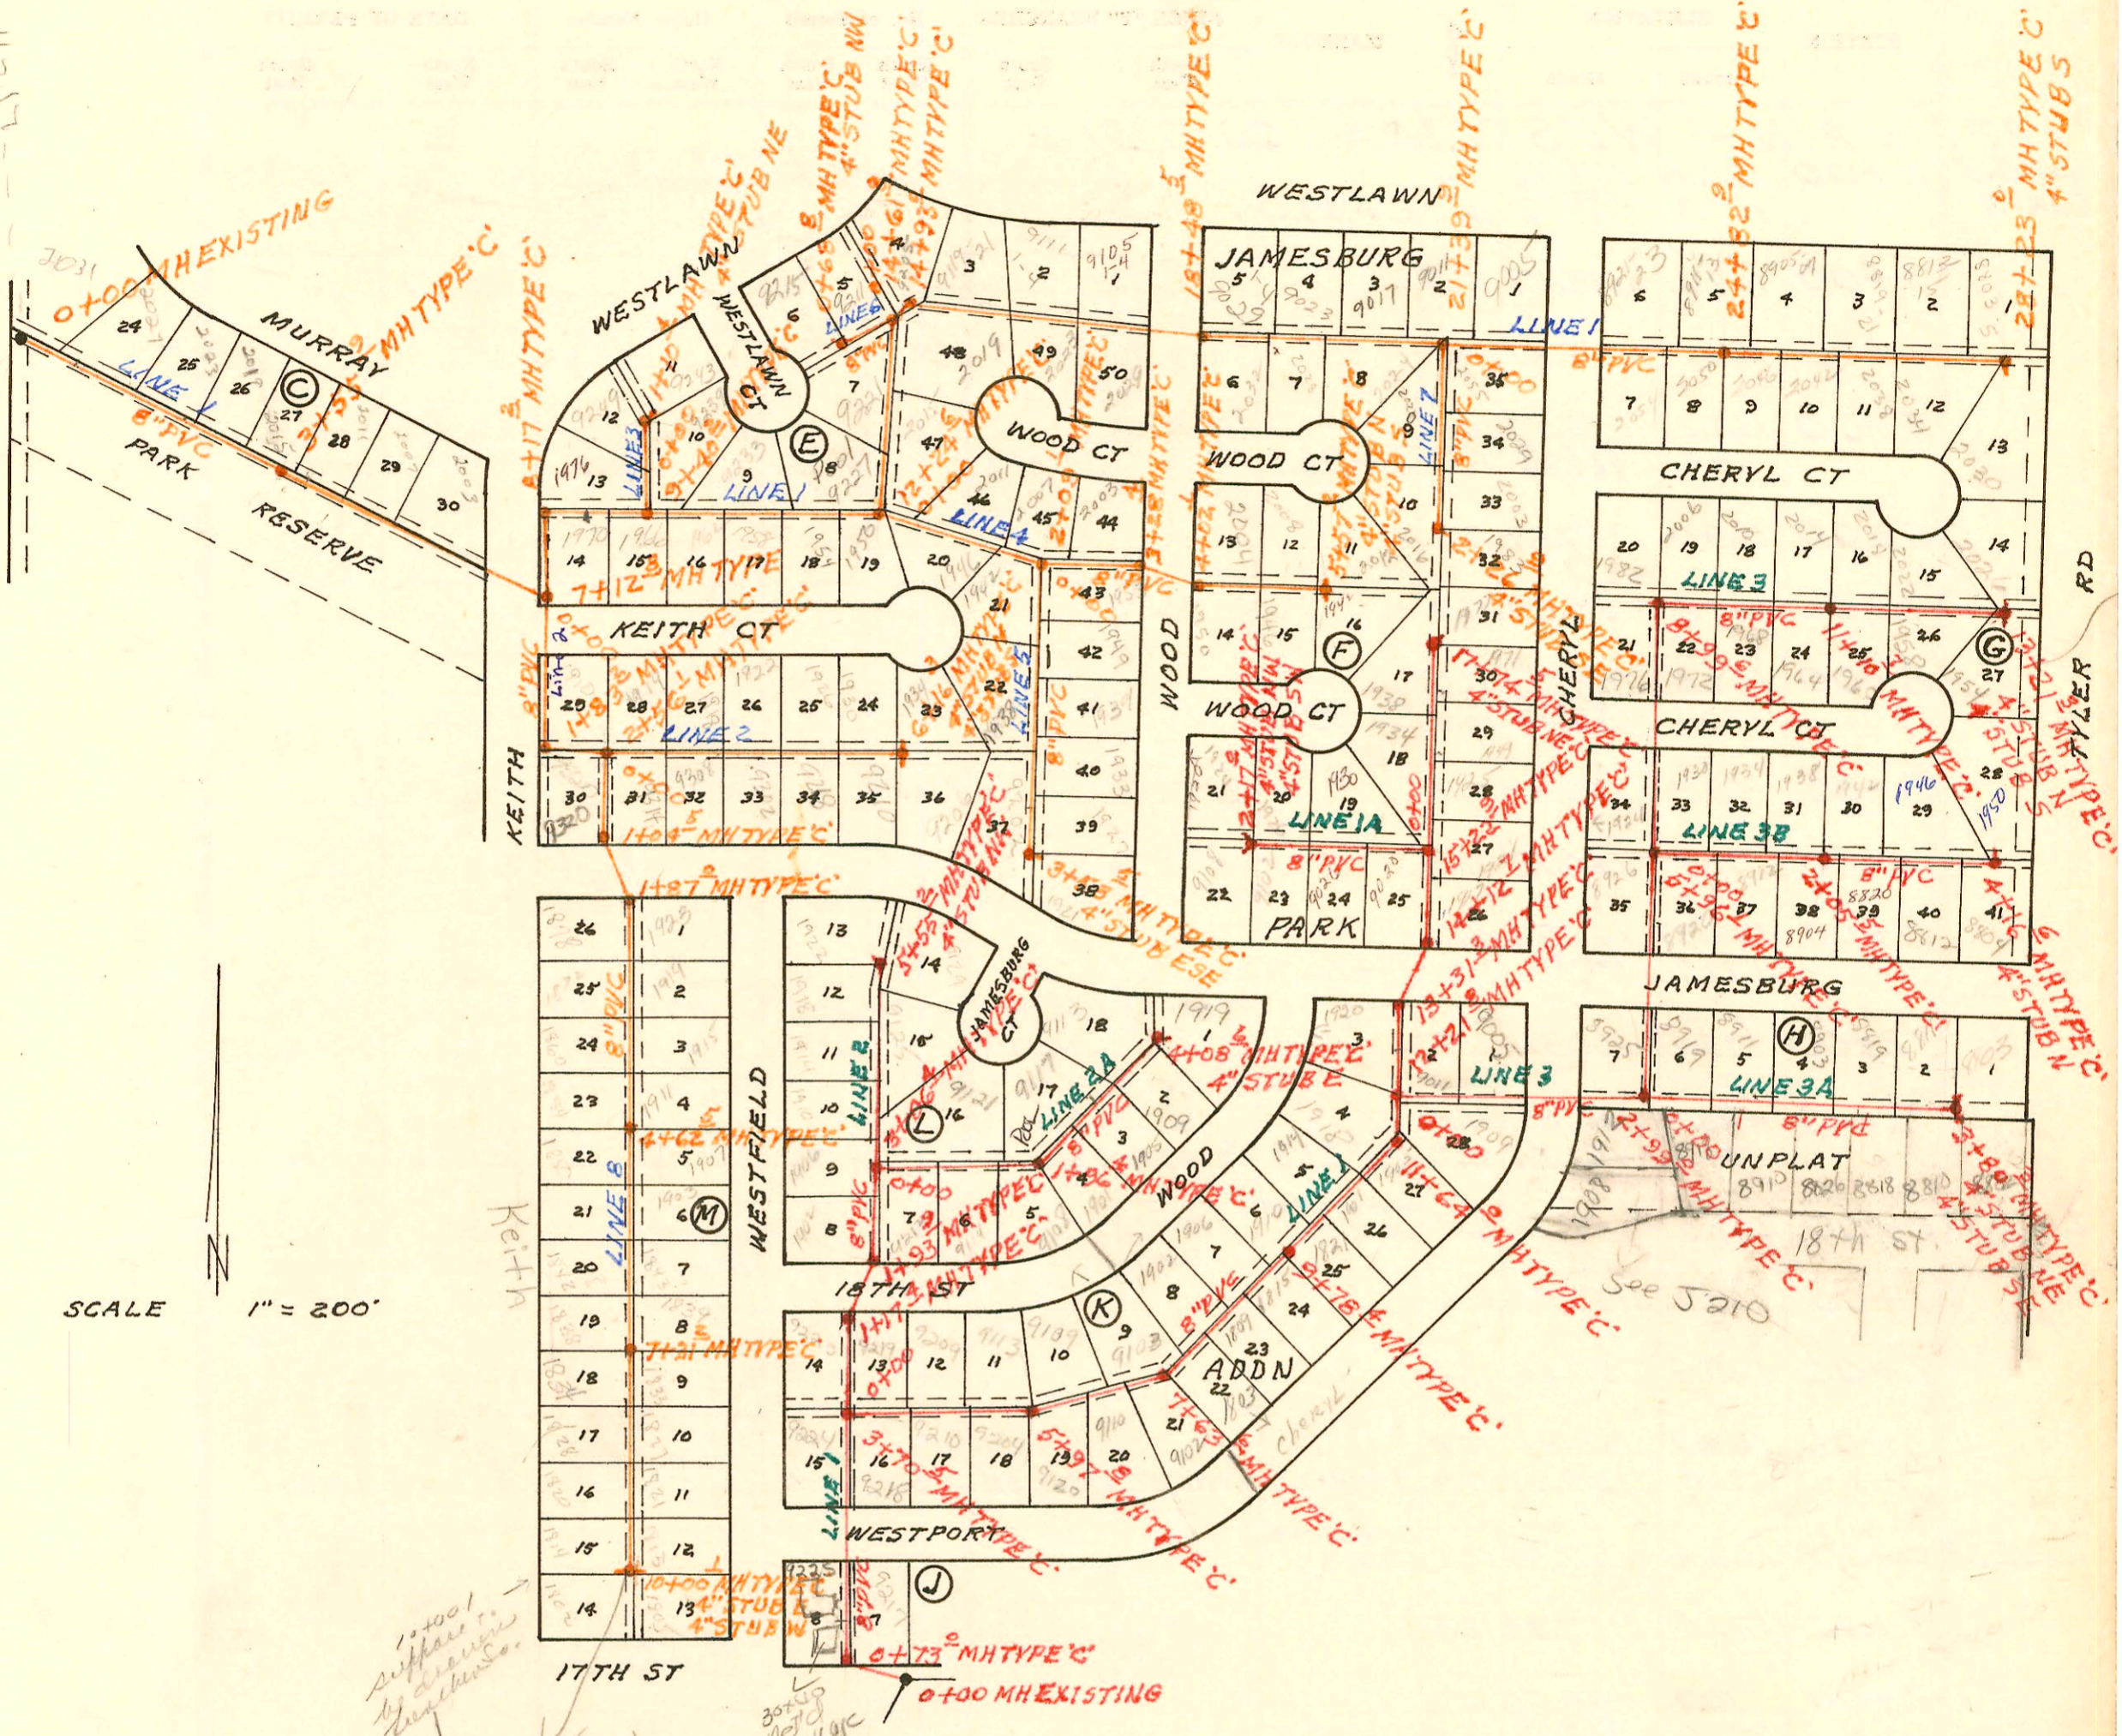

SCALE 1" = 200'

As-Built 8/81
 shows MH D2001
 5' S. of NPL of
 Lot 13 BK M
 of 1-1592

LATERAL I MAIN 4 WESTLINK SEWER
 BUILT BY: CLEARWATER EXCAVATION CO.
 PROJ. No 468-76-245-80981-000-000-001
 BOOKED 8-8-81 FROM LES 31
 PHASE I ●● PHASE II ●●

on map

5-37

CONSTRUCTION RECORD

SERVICE RECORD

STATION	ELEVATION		Depth	MANHOLE	4-INCH "Y" BRANCHES		No. of Permit		House Number		DATE OF PERMITS		
	Ground	Grade			North West	South East	North West	South East	North West	South East	North West	South East	
LATI MAIN 4 WESTLINK (CONT'D)													
LINE I PH II CONT'D	7+00	159.4 160.0	151.22 151.41	8.2 8.6	7+63.6	7+43.6 ^{to} 7+56.6 ^{to} 7+70.6 ^{to}		7973 7975 7976	7960 7970	9103 W 18th 1902 N Wood	9110 Westport 9102 Westport 1803 N Cheryl 1809 N Cheryl 1815 N Cheryl	4-28-83	4-28-83 4-27-83 4-28-83
	8+00	160.0	151.52	8.5		8+28.6 ^{to} 8+86.6 ^{to}		7976	7971	1906 N Wood		4-28-83	4-28-83
	9+00	160.8 161.4	151.82 152.06	9.0 9.3	9+78.4	9+33.4 ^{to} 9+63.0 ^{to}		7977	7972	1910 Wood		4-28-83	4-28-83
	10+00	161.4	152.12	9.3		10+30.4 ^{to} 10+91.4 ^{to}		8041	8045	1910 Wood	1821 Cheryl	5-4-83	5-4-83
	11+00	163.4 163.1	152.42 152.61 152.71	11.0 10.5 10.4	11+64.0	11+47.9 ^{to}		8042	8044 8043	1914 Wood	1901 Cheryl 1908 Cheryl	5-4-83	5-4-83
	12+00	163.5 163.8	152.82 152.89 152.99	10.7 10.9 10.8	12+21.8	11+73.5 ^{to}		6554		1918 Wood		9-15-82	
	13+00	163.7 164.3	153.22 153.31 153.41	10.5 11.0 10.9	13+31.3	12+91.7		7931		1920 N Wood		4-26-83	
	14+00	165.0 165.1	153.62 153.66 153.76	11.4 11.4 11.3	14+12.7				6347		1917 Cheryl		8-16-82
	15+00	164.6 165.0	154.02 154.09 154.19	10.6 10.9 10.8	15+22.9	15+32.9 ^{to} 15+83.7 ^{to}			6346 6348		1921 Cheryl 1925 Cheryl		8-16-82 8-16-82
	16+00	165.6	154.42	11.2		16+21.5 ^{to} 16+43.1 ^{to}		6550		1934 Wood Ct		9-10-82	
	17+00	165.9 165.5	154.72 154.94	11.2 10.6	17+74.5 4" STUB NE	17+24.5 ^{to} 17+21.7 ^{to}		6519	6350 6351	1938 Wood Ct	1949 N Cheryl 1971 Cheryl 1977 Cheryl	7-10-82	8-16-82
LINE IA	0+00	165.0	154.17	10.8	0+00 = 15+22.9 LINE I	0+48.0 ^{to}			6644		2030 Farmburg		9-28-82
	1+00	162.7	154.47	8.2		1+12.0 ^{to} 1+87.0 ^{to}		6709	6643	1930 W Wood Ct 1926 Wood Ct	9026 Farmburg	10-8-82	9-28-82
	2+00	161.6 161.1	154.77 154.82	6.8 6.3	2+17.0 4" STUB NW 4" STUB SW			6931	7071 6932	1924 Wood Ct	9102 Farmburg 9101 Farmburg	11-8-82	11-30-82
LINE 2	0+00	158.3	150.23	8.1	0+00 = 3+70.5 LINE I	0+41.0 ^{to}			7729		9225 W. 18th		3-22-83
	1+00	158.1 158.6	150.53 150.58	7.6 8.0	1+17.4								
		158.8	150.81 150.83	8.0 8.0	1+93.9								
	2+00	157.7	150.85	6.9		2+55.7 ^{to}			7356		1902 W Westfield		1-13-83
	3+00	156.8 159.3	151.15 151.17 151.27	5.7 8.1 8.0	3+06.4	3+13.4 ^{to} 3+83.2 ^{to}		7857	7669	1906 N Westfield 1910 N Westfield		1-13-83	3-14-83
	4+00	156.2	151.55	4.7		4+50.2 ^{to} 5+04.2 ^{to}		7670	7673	1914 Westfield	9125 Farmburg	3-14-83	3-14-83
	5+00	156.3 157.8	151.85 152.02	4.5 5.8	5+55.2 4" STUB NW	5+38.2 ^{to}		7671	7674 7672	1918 Westfield 1922 Westfield	9129 Farmburg	3-14-83	3-14-83
LINE 2A	0+00	159.3	151.26	5.8	0+00 = 3+06.4 LINE 2	0+65.0 ^{to} 0+93.4 ^{to}		7379	7355 7354	7121 Farmburg	9212 W 18th 9214 W 18th	1-13-83	1-13-83
	1+00	157.0 159.0	151.56 151.82 151.95	5.4 7.7 7.1	1+96.4	1+66.4 ^{to}			7350		9188 W. 18th		1-12-83
	2+00	158.2	151.96	6.2		2+02.4 ^{to} 2+93.6 ^{to}		7245	7349	9117 W Farmburg	1901 Wood	12-27-82	1-12-83
	3+00	159.1	152.26	6.8		3+18.6 ^{to} 3+58.6 ^{to}		7538	7539	9113 W Farmburg	1905 Wood 1907 Wood	2-25-83	2-25-83
	4+00	159.5 159.8	152.56 152.59	6.9 7.2	4+08.6 4" STUB E			7242	7241			12-23-82	12-23-82
LINE 3	0+00	163.8	152.97	10.8	0+00 = 12+21.8 LINE I	0+28.4 ^{to} 0+71.0 ^{to}		6698	7126	9011 Farmburg	1909 Cheryl	10-6-82	12-7-82
	1+00	164.5	153.67	10.8		1+15.4 ^{to}		6697		9005 Farmburg		10-6-82	

CONT'D NEXT PAGE