


0+00 EXIST MH
0+09 CLEANOUT RISER
Top ELEV. 152.67
FL ELEV. 139.27
SS. Abandonment lot 5, Blk 4,
Rainbow Lakes West 3rd Addn.
1246 PPS
Built By B&L Excavation
Booked 6-28-02 As Built.

Trap Reg'd w/ 15" Lines
RAINBOW LAKES WEST
replat

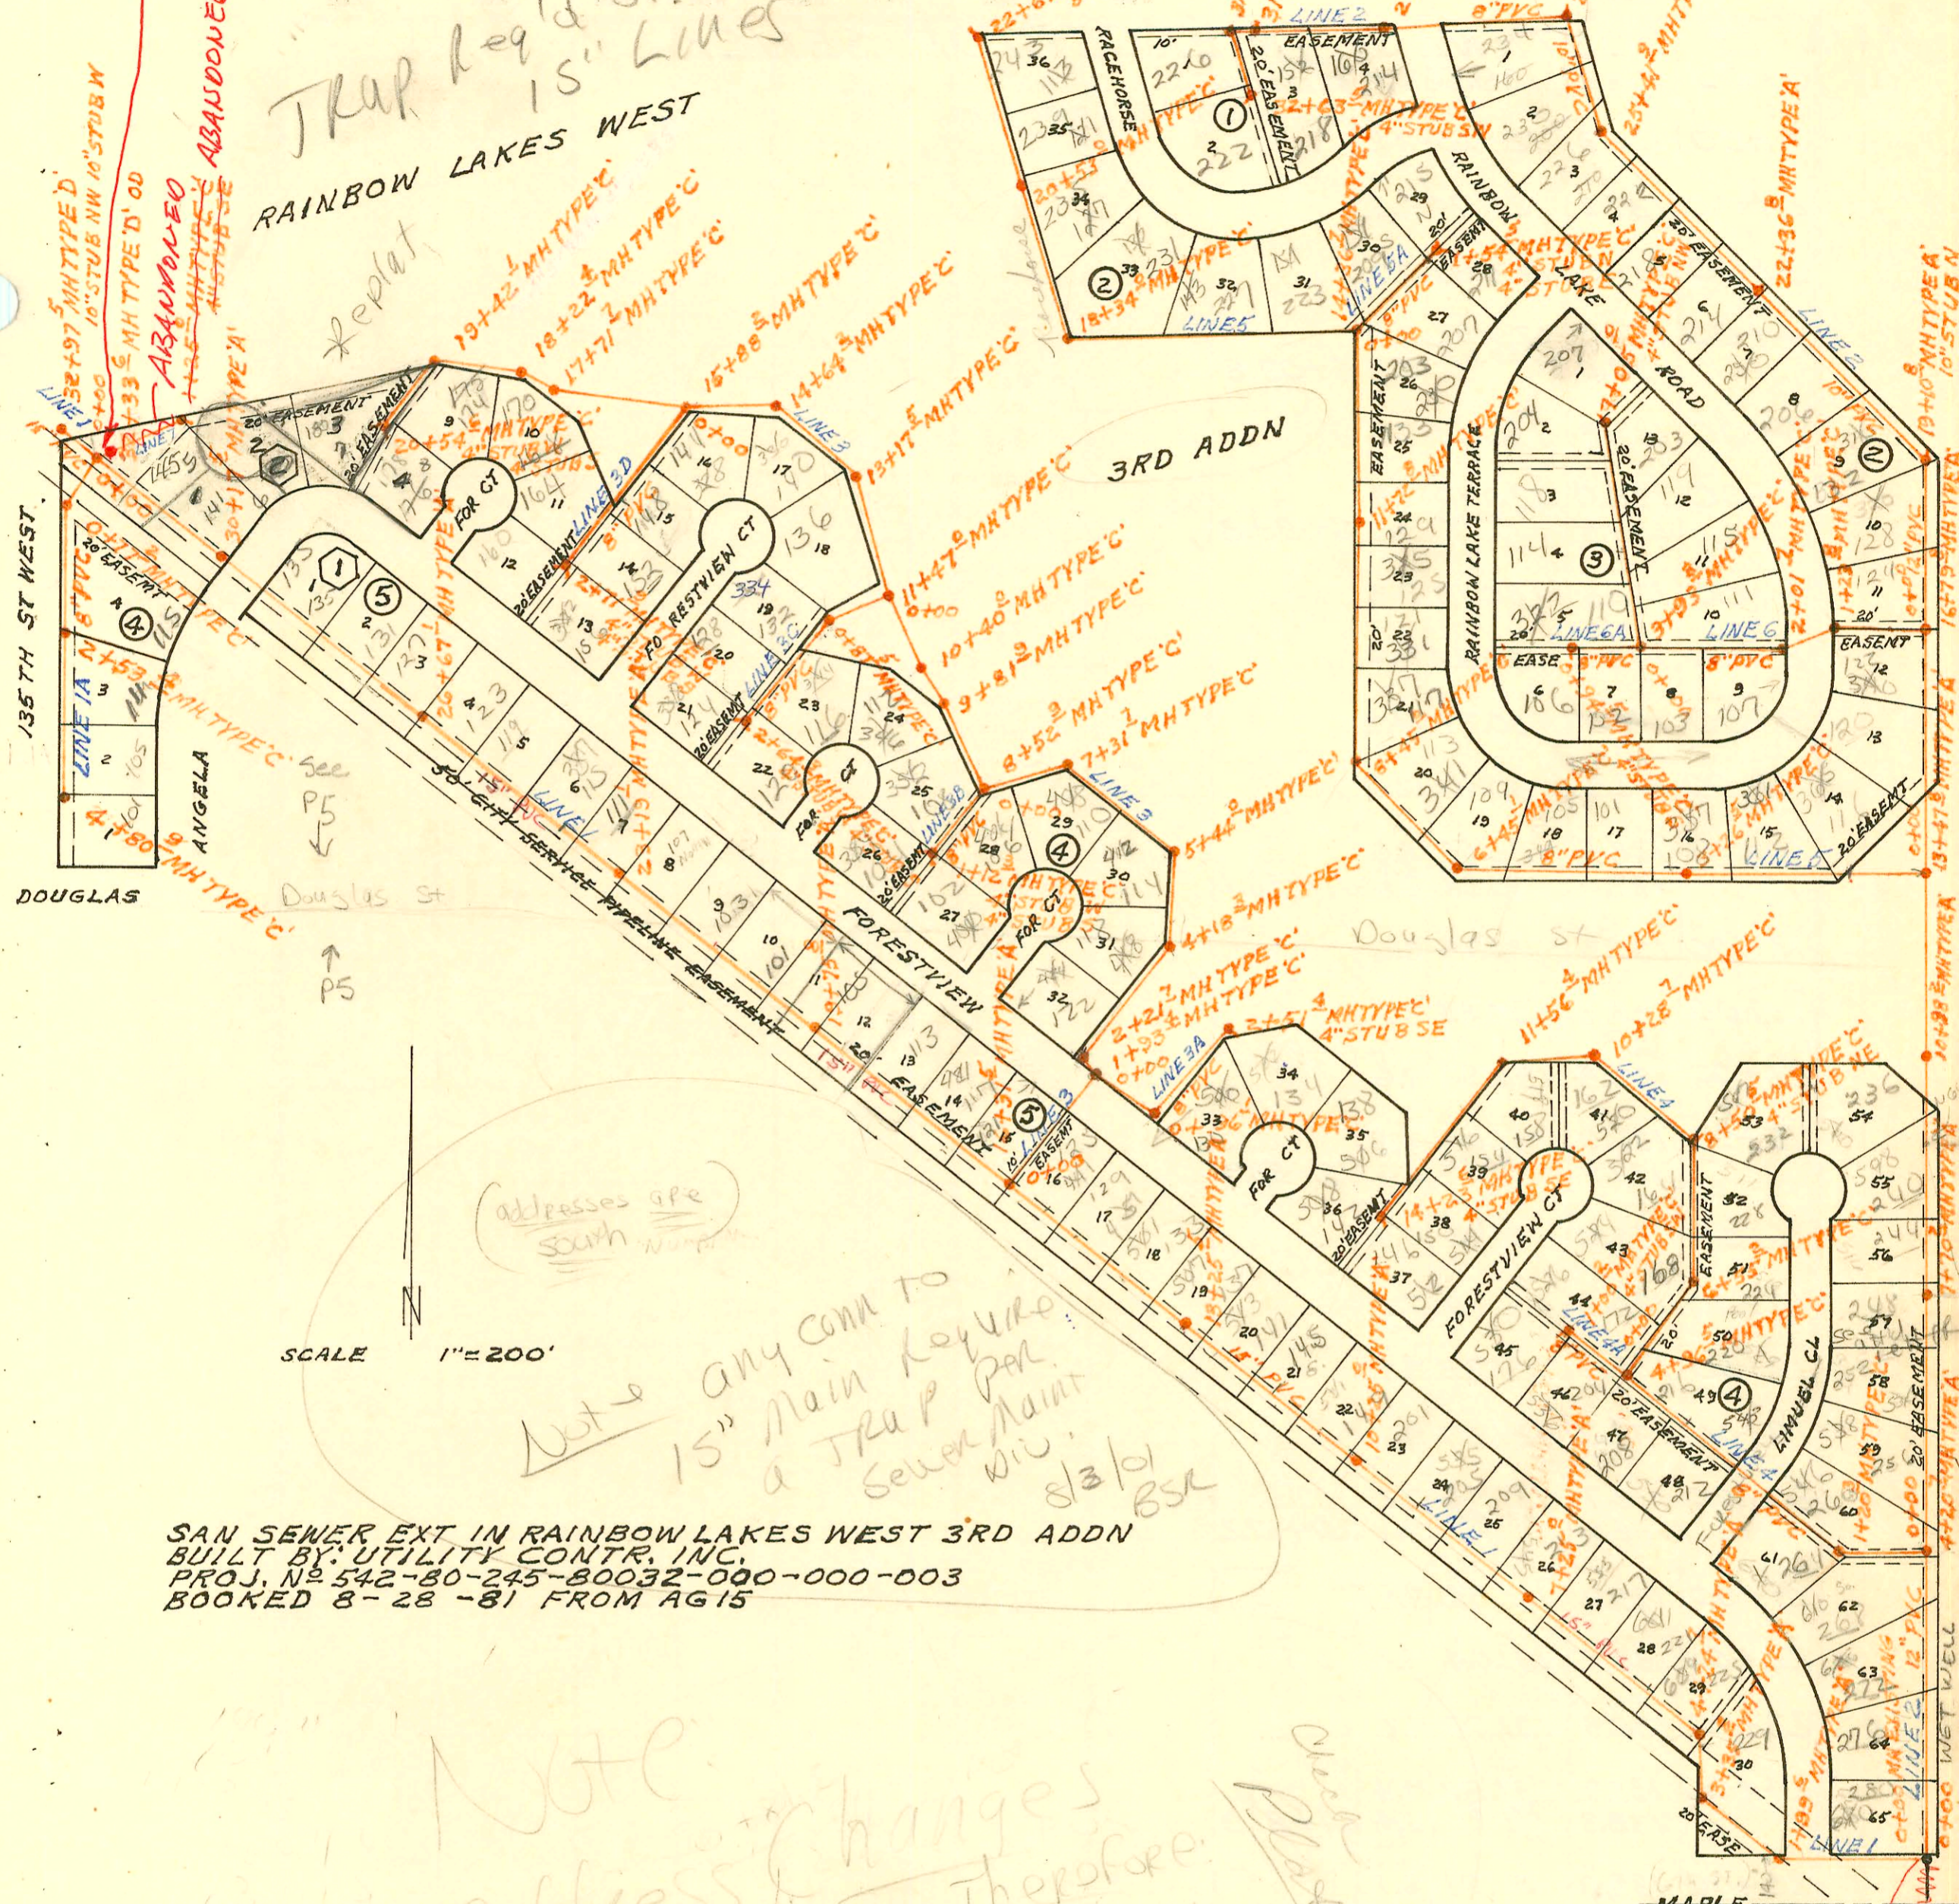

SCALE 1" = 200'

addresses are south
Note any com to 15" Main Keyhole a TRAP PER sewer main w/ 8 1/2" BSC

SAN SEWER EXT IN RAINBOW LAKES WEST 3RD ADDN
BUILT BY: UTILITY CONTR. INC.
PROJ. NO 542-80-245-80032-000-000-003
BOOKED 8-28-81 FROM AG 15

Note: Changes in addresses will appear out of order. See list of Taylor 5-9-95
BSC

NET WELL & FORCE MAIN ABANDONED
NET WELL NOW TYP. 10" MH
SEE N-157

0+05 MH APPROX 20' W/ PL

CONSTRUCTION RECORD

SERVICE RECORD

STATION	ELEVATION		Depth	MANHOLE	4-INCH "Y" BRANCHES		No. of Permit		House Number		DATE OF PERMITS	
	Ground	Grade			North West	South East	North West	South East	North West	South East	North West	South East
SS EXT IN RAINBOW LAKES WEST 3RD ADDN (CONT'D)												
LINE 2 CONT'D 27+00	140.4	130.61	9.8									
	140.3	130.63	9.7									
		130.80	9.5	27+09.2								
28+00	140.6	131.47	9.1									
29+00	141.3	132.21	9.1									
	141.9	132.66	9.2	29+61.4								
30+00	142.1	132.95	9.2		30+16.2 TAP		24365		160 S- Ranchouse		11-28-89	
31+00	143.8	133.68	10.1									
	144.8	133.96	10.8			4" SDR 35 31+05.9		8332547	152 S- Ranchouse		12-20-93	
	144.8	136.15	8.7	31+71.9				896957	226 Ranchouse		5-20-98	
32+00	144.6	136.37	8.2									
	145.1	136.62	8.5	32+63.5	4" stub		97-2781-7		222 Ranchouse		2-14-97	
LINE 3 0+00	141.1	127.53	13.6	0+00=16+31.5 LINE 1	0+41.0 TAP	4" SDR 35 1 to 5.0	17262	838457	121 Forestview	44+125 Forestview	11-7-86	
1+00	140.9	127.93	13.0									
	136.6	128.30	8.3	1+93.4								
		128.40	8.2									
2+00	140.6	128.43	12.2									
	136.6	128.52	8.1	2+21.7								
		128.62	8.0		4" SDR 35 2+69.7 tap		26629-7		44+122 Forestview		7-11-91	
3+00	140.6	128.93	11.7									
4+00	140.6	129.33	11.3									
	140.5	129.40	11.1	4+18.3		4" SDR 35 4+01.6 tap		21198	44+113 Forestview		7/24/88	
		129.50	11.0									
5+00	140.6	129.83	10.8									
	140.8	130.01	10.8	5+44.0								
		130.12	10.7									
6+00	141.2	130.34	10.9		6+11.5 TAP		91-22422-7		44+114 Forestview		5-25-91	
7+00	142.4	130.74	11.7									
	142.6	130.87	11.7	7+31.7		4" SDR 35 7+58.6 tap		92-3225-7	44+110 Forestview		9-28-92	
		130.97	11.6									
8+00	142.2	131.24	11.0									
	141.8	131.25	10.4	8+52.9								
		131.55	10.3									
9+00	142.1	131.74	10.4									
	143.2	132.07	11.1	9+81.9		4" PVC 40 9+67.9 TAP		26878	34+112 Forestview		1-15-91	
		132.27	10.9									
10+00	143.1	132.34	10.8									
	142.8	132.50	10.3	10+40.0								
11+00	142.8	132.74	10.1									
	142.8	132.93	9.9	11+47.0								
12+00	142.8	133.14	9.7									
					4" SDR 35 TAP 91' FOR LINE 01 ATT		96-101607		136 10 Forestview		6-21-96	
13+00	142.8	133.54	9.3									
	142.8	133.61	9.2	13+17.5								
		133.71	9.1									
14+00	142.8	134.04	8.8									
	145.1	134.30	10.8	14+64.2		4" SDR 35 13+97.2 tap		91-36478-7	330 140 Forestview		10-30-91	
15+00	145.7	134.62	11.1									
	146.9	135.40	11.5	15+88.2		4" SDR 35 15+63.6 TAP		92-25970-7	328 144 Forestview		7-29-92	
16+00	146.5	135.51	11.0									
17+00	147.6	136.39	11.2									
	148.6	137.03	11.6	17+71.7								
		137.13	11.5									
18+00	148.8	137.38	11.4									
	149.2	137.58	11.6	18+22.4		4" SCH 40 17+79.7		2555- 00170	170 10 Forestview		1-15-2000	
		137.68	11.5									

CONT'D NEXT PAGE

H226A

1945
1946
1947
2025