


0+00 EXIST MH
0+09 CLEANOUT RISER
Top ELEV. 152.67
FL ELEV. 139.27

SS. Abandonment lot 5, Blk 4,
Rainbow Lakes West 3rd Addn.
1246 PPS
Built By B&L Excavation
Booked 6-28-02 As Built.

Trap Reg'd w/ 15" Lines
RAINBOW LAKES WEST
replat

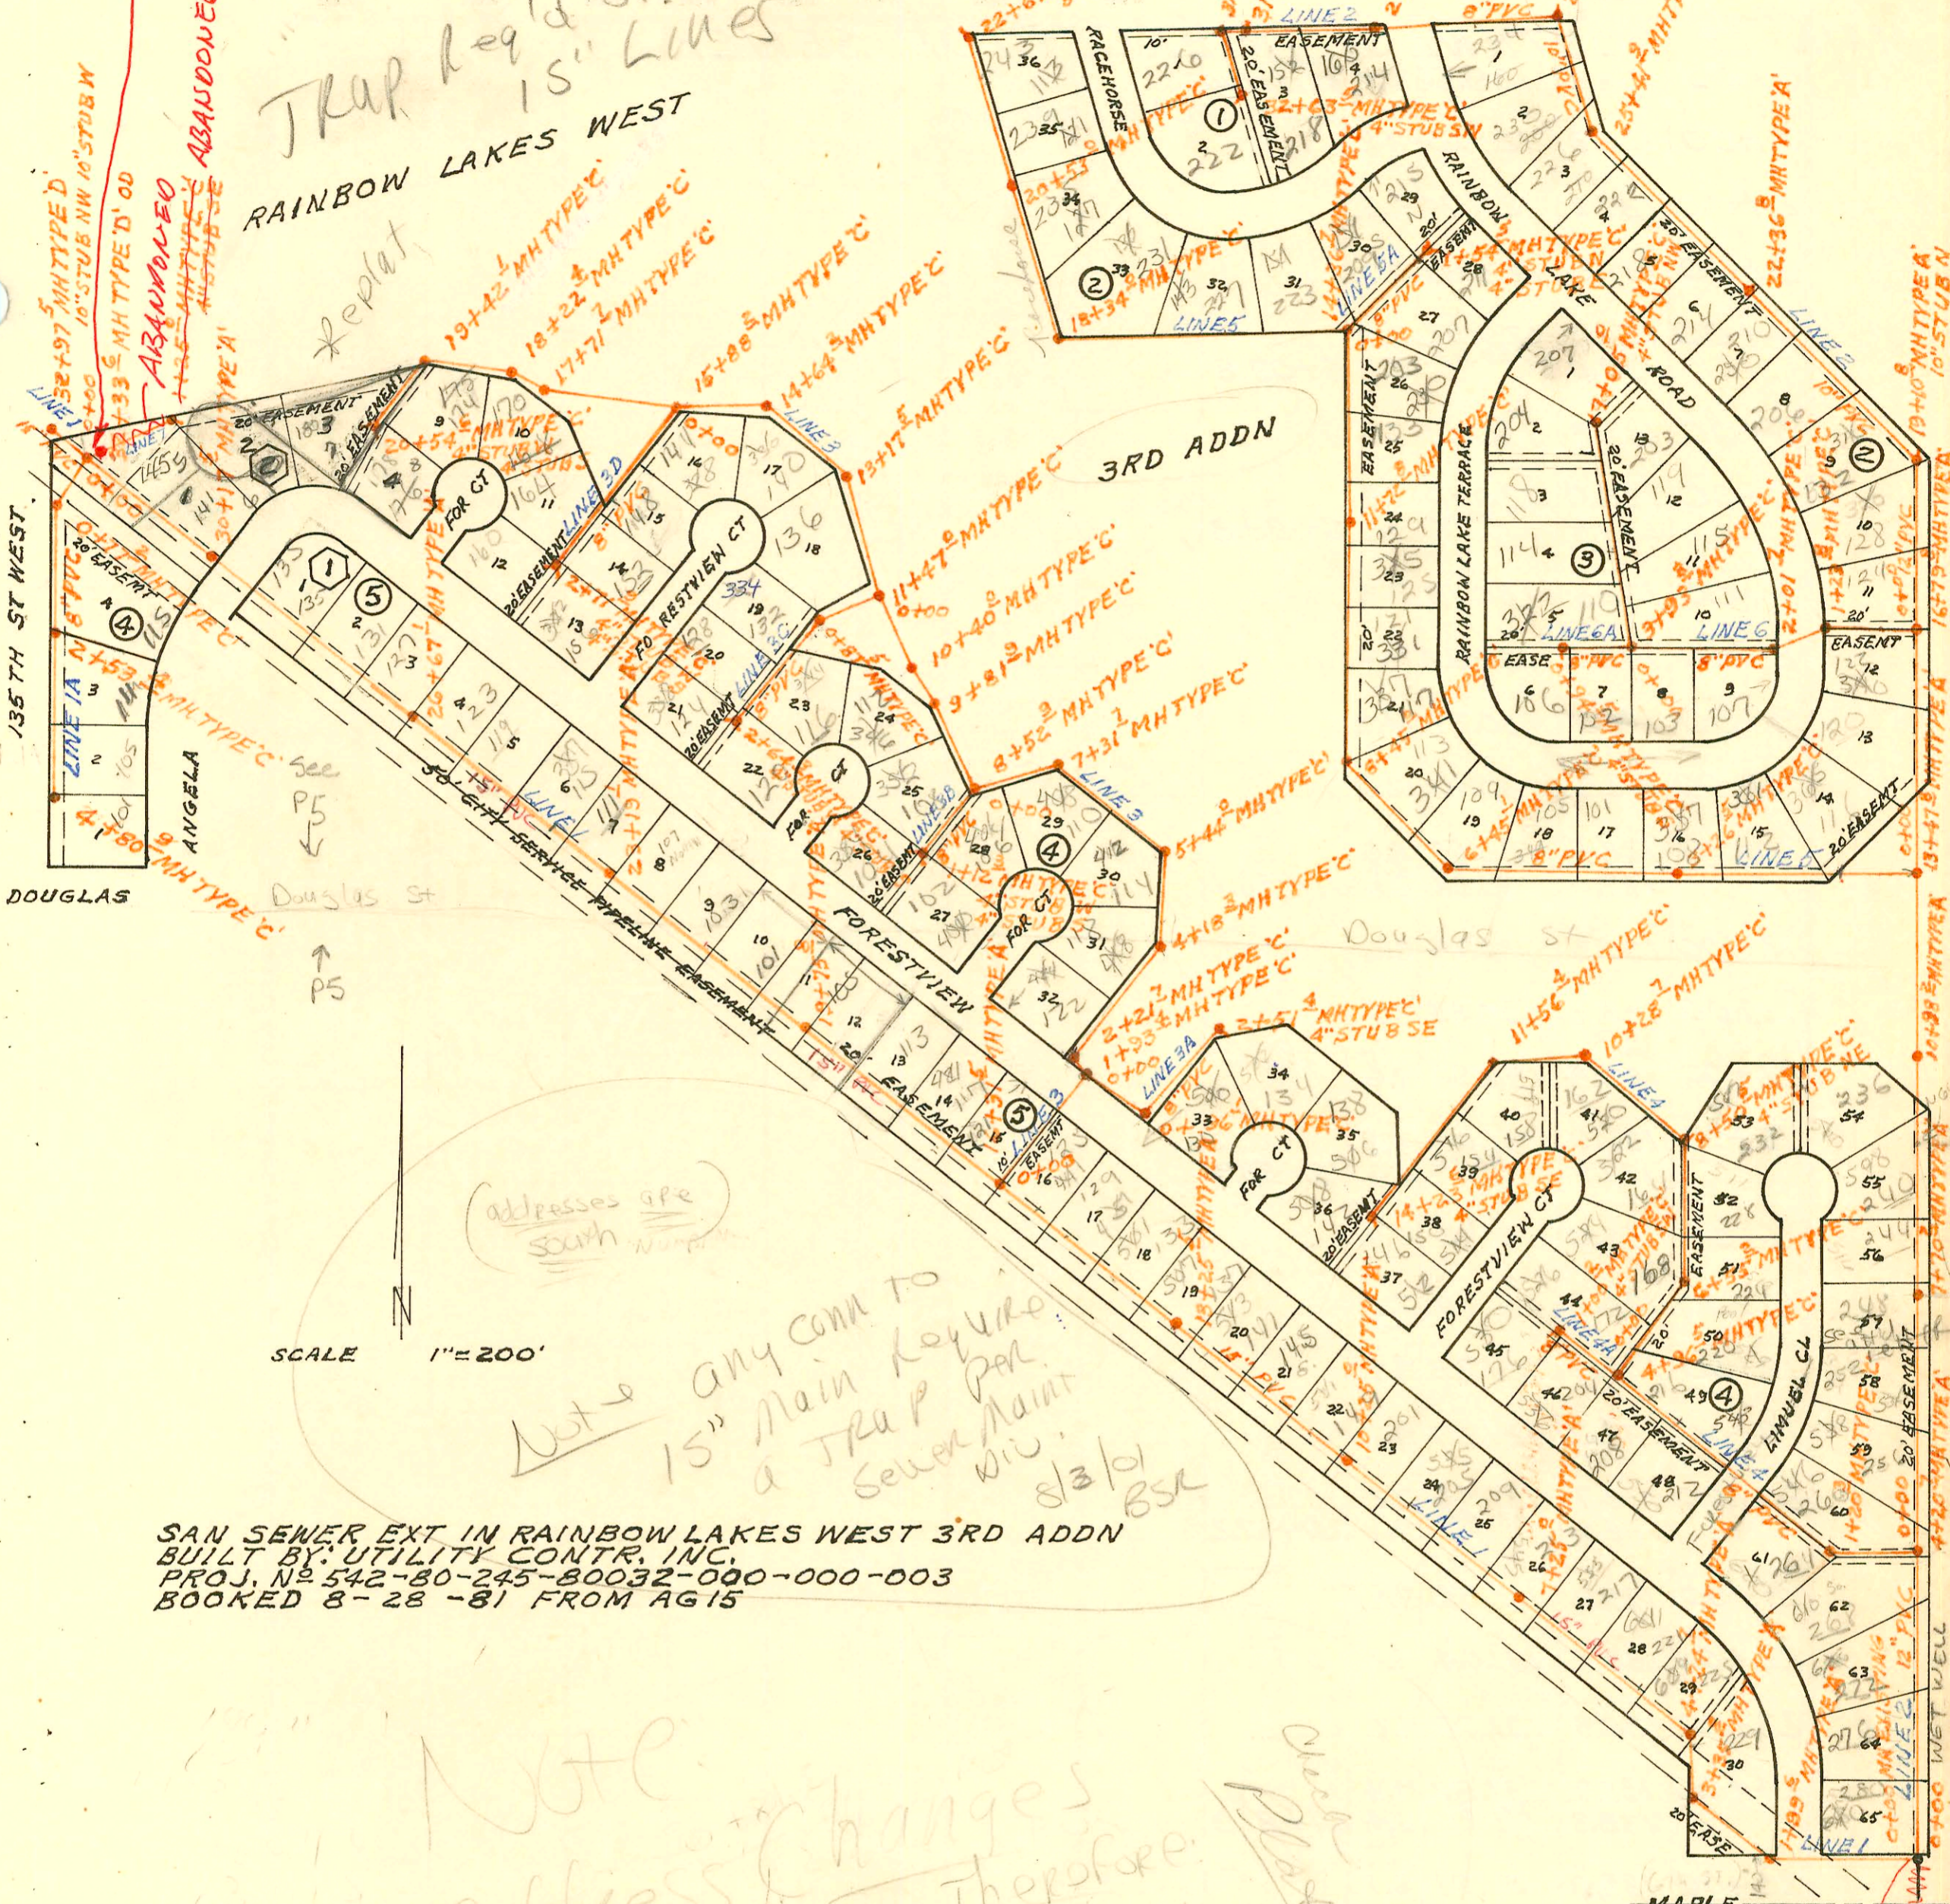

SAN SEWER EXT IN RAINBOW LAKES WEST 3RD ADDN
BUILT BY: UTILITY CONTR. INC.
PROJ. NO 542-80-245-80032-000-000-003
BOOKED 8-28-81 FROM AG 15

SCALE 1" = 200'

Note any conn to
15" Main Keyhole
a TRAP PER
sewer main
w/ 8 1/2" BSC

Note: Changes
address will appear
in works. Therefore
address will appear
out of order. See
list of Taylor
5-9-95
BL

NET WELL
& FORCE MAIN
ABANDONED
NET WELL NOW
TYP. 10" MH
SEE N-157

ABANDONED
ABANDONED
ABANDONED

