



LATERAL 231 MAIN 5 SAN SEWER N<sup>o</sup> 22  
 BUILT BY: COLEMAN EXCAVATING INC.  
 PROJ. N<sup>o</sup> 468-76-245-80929-000-000-001  
 BOOKED 9-15-81 FROM DCD 164

*ON MAP*  
*6-50*

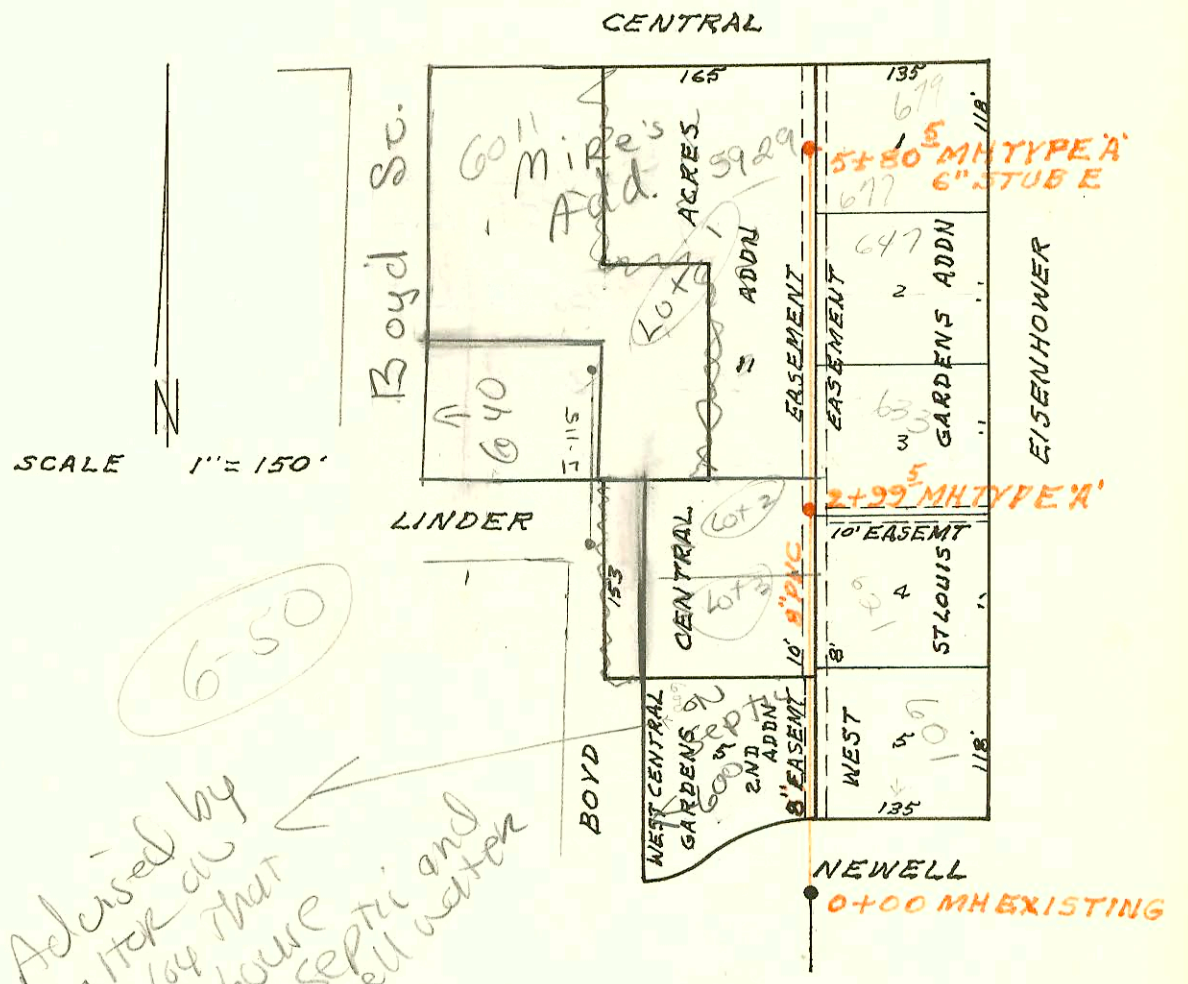

*Advised by Realtor at 4/24/04 that this house has 15 old septic and well water*  
*OK*

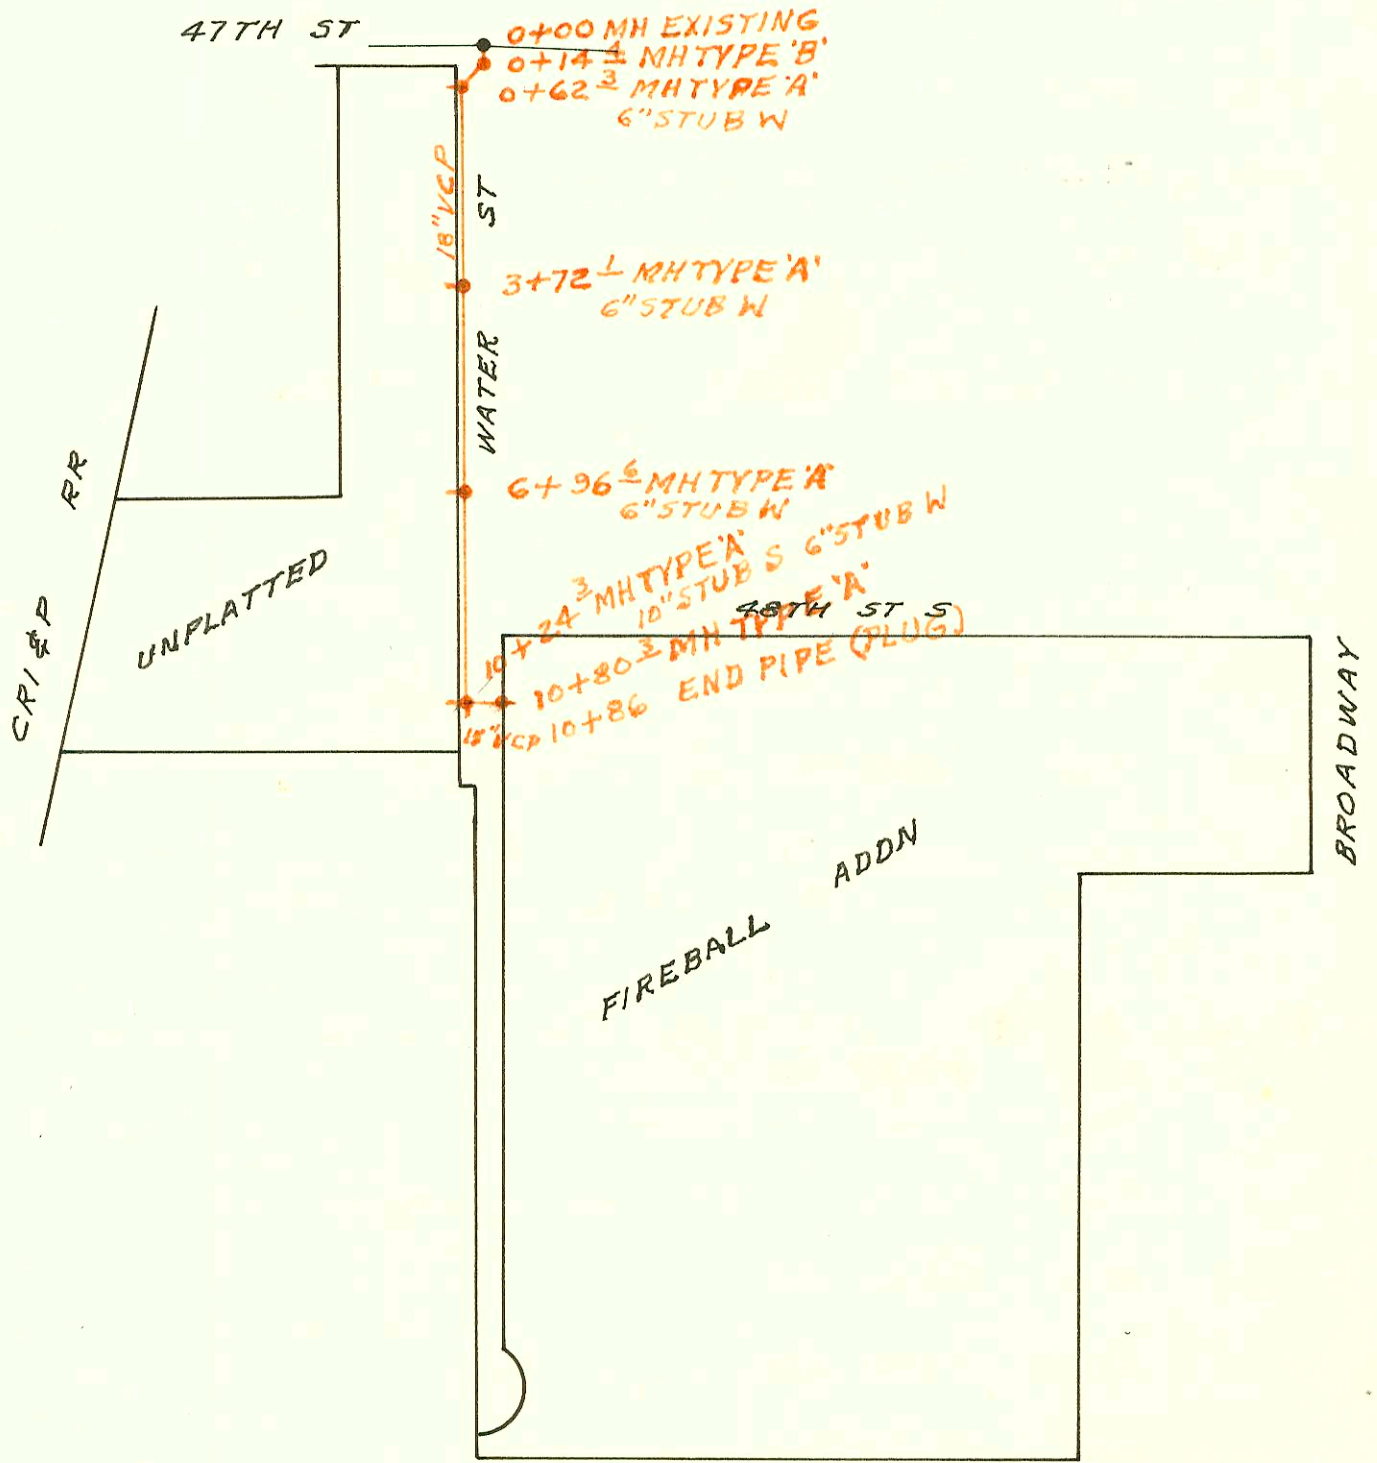

LATERAL 22 MAIN 2 SOUTHWEST INTERCEPTOR SEWER  
 BUILT BY: UTILITY CONTR. INC.  
 PROJ. N<sup>o</sup> 468-76-245-81129-000-000-001  
 BOOKED 9-23-81 FROM DCD 77

CONSTRUCTION RECORD						SERVICE RECORD							
STATION	ELEVATION		Depth	MANHOLE	4-INCH "Y" BRANCHES		No. of Permit		House Number		DATE OF PERMITS		
	Ground	Grade			North West	South East	North West	South East	North West	South East	North West	South East	
LATERAL MAIN 9 SWI (CONT'D)													
LINE 6 CONT'D	6+00	150.9	140.49	10.4		6+10.1		1472				10-9-80	
		151.3	140.65	10.7	6+41.1								
	7+00	151.0	140.89	10.1									
		150.7	141.01	9.7	7+30.6	4" STUB SW	4" STUB SE	1643	2328	236.2	11508	10-20-80	1-9-81
LINE 1A	0+00	150.8	137.71	13.1	0+00=19+53.5	LINE 1							
	1+31.0	149.0	138.24	10.8	END PIPE (PLUG)								
LINE 2A	0+00	147.6	136.00	11.6	0+00=13+73.4	LINE 2							
						4" PVC 40	37.0 top	9136447		11519	Special	10-30-81	
	1+08.5	147.8	136.43	11.4	END PIPE								
LINE 2B	0+00	150.8	142.00	8.8	0+00=17+00.1	LINE 2							
						0+24.5		8193		11521	Builder	5-18-83	
	0+98	150.6	142.39	8.2	END PIPE						11520	Shelton	3-26-85
LINE 4A	0+00	149.5	137.75	11.8	0+00=2+04.3	LINE 4							
						0+55.2		917		211	Shelton	7-31-80	
		148.7	138.00	10.7	0+61.6	4" STUB NE	4" STUB SW						
LINE 4B	0+00	150.1	139.70	10.4	0+00=4+10.3	LINE 4							
						0+08.5		1342		11507	Shelton	9-27-81	
		149.9	140.00	9.9	0+79.3	4" STUB N	4" STUB W	294		306	Shelton	7-25-80	
LINE 6A	0+00	151.0	139.80	11.2	0+00=4+02.1	LINE 6							
	1+35	151.3	140.34	11.0	END PIPE								
LINE 6B	0+00	151.3	140.71	10.6	0+00=6+41.1	LINE 6							
	1+34.8	150.5	141.25	9.3	END PIPE								
LATERAL 231 MAIN 5 SAN SEWER NO 22													
	0+00	121.3	115.26	6.0	0+00	EXISTING							
						0+86.0		6307		601	Shelton	8-6-82	
	1+00	121.6	115.66	5.9									
	2+00	121.7	116.06	5.6									
		122.4	116.46	5.9	2+99.5			3703		621	Shelton	7-20-81	
	3+00	122.0	116.46	5.5									
						3+94.5		7198		633	Shelton	12-16-82	
	4+00	121.6	116.86	4.7		4+05.5		24352		5924	Central	11-27-89	
	5+00	122.0	117.26	4.7									
		122.4	117.58	4.8	5+80.5			4813		6477	Shelton	7-31-81	
						5+00.5				679	Shelton	8-28-83	
						6" STUB E		10187		677	Shelton	2-28-84	
LATERAL 22 MAIN 2 SOUTHWEST INTERCEPTOR													
	0+00	85.63	74.73	10.9	0+00	EXISTING							
		85.8	74.75	11.1	0+14.4								
		86.5	74.80	11.7	0+62.3	6" STUB W							
	1+00	86.2	74.85	11.4									
	2+00	85.4	74.97	10.4									
	3+00	85.7	75.09	10.6									
		87.4	75.18	12.2	3+72.1	6" STUB W							
	4+00	87.2	75.21	12.0									
	5+00	85.6	75.33	10.3									
	6+00	84.3	75.45	8.9									
		88.4	75.57	12.8	6+96.6	6" STUB W							