


LATERAL 61 WAR INDUSTRIES SEWER  
BUILT BY: UTILITY CONTR. INC.  
PROJ. NO 468-76-245-80543-000-000-001  
BOOKED 9-26 -81 SRL 7

ON MAP

SCALE 1" = 150'

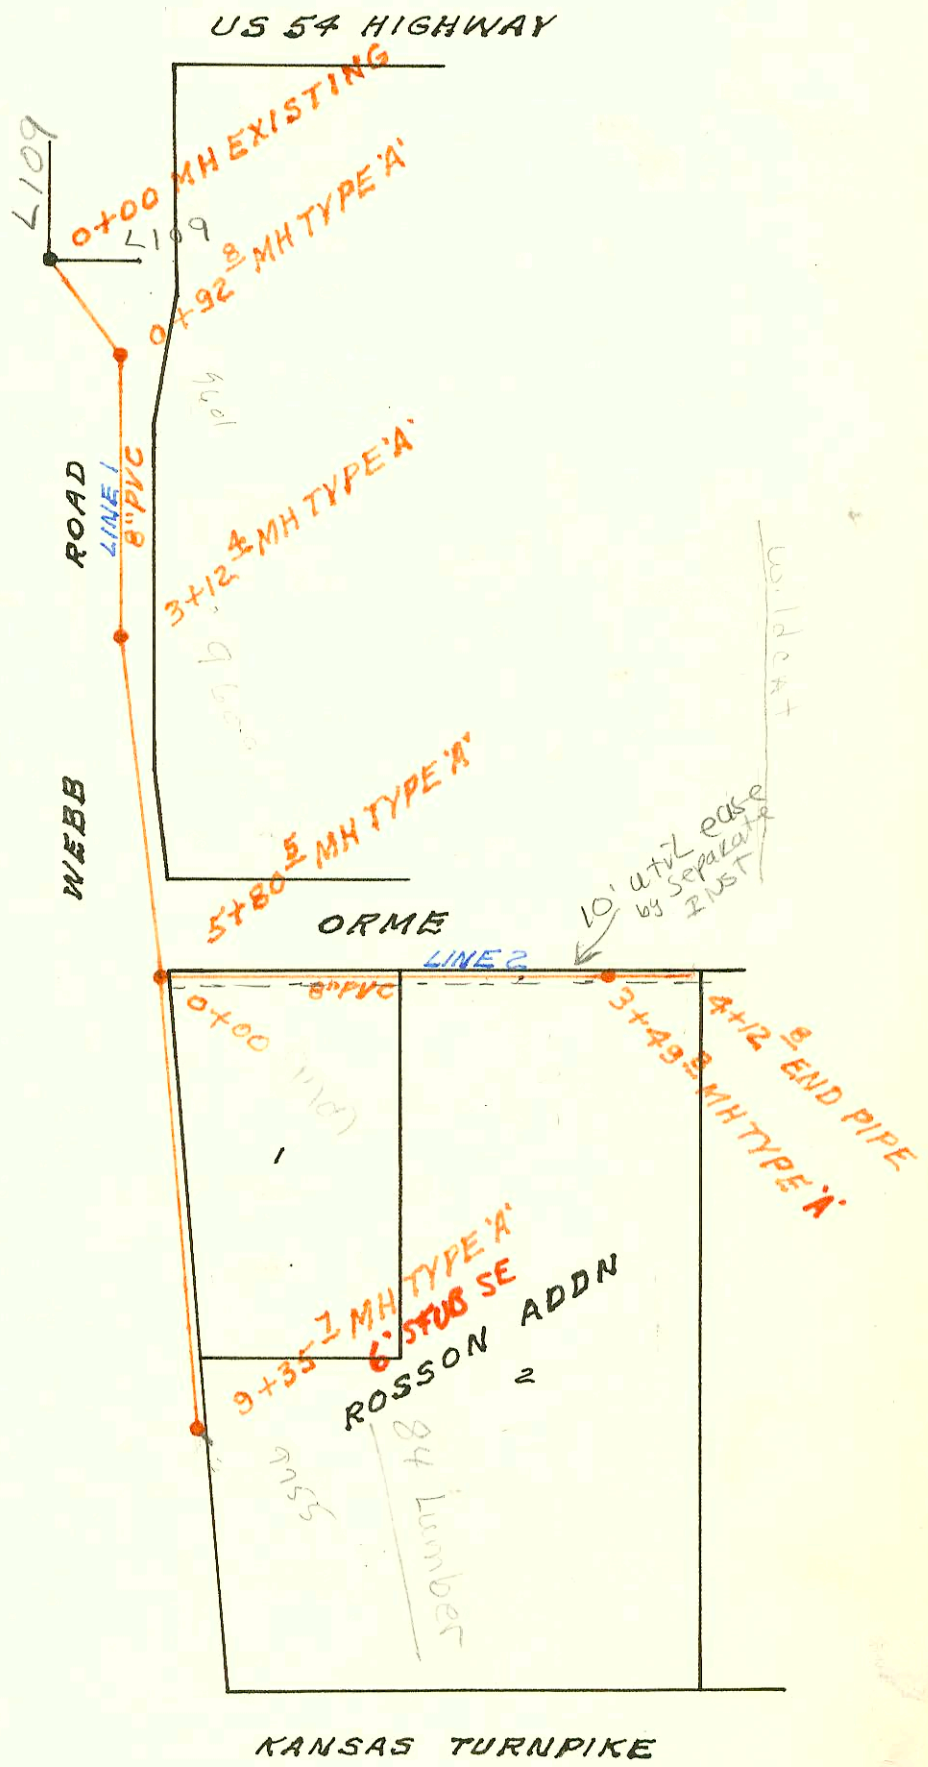


21 ST ST

SCALE 1" = 150'

LATERAL 15 MAIN 20 WAR INDUSTRIES SEWER  
BUILT BY: COLEMAN EXCAVATING CO.  
PROJ. NO 468-76-245-81046-000-000-001  
BOOKED 9-26 -81 FROM CG 16A

ON MAP

12-38

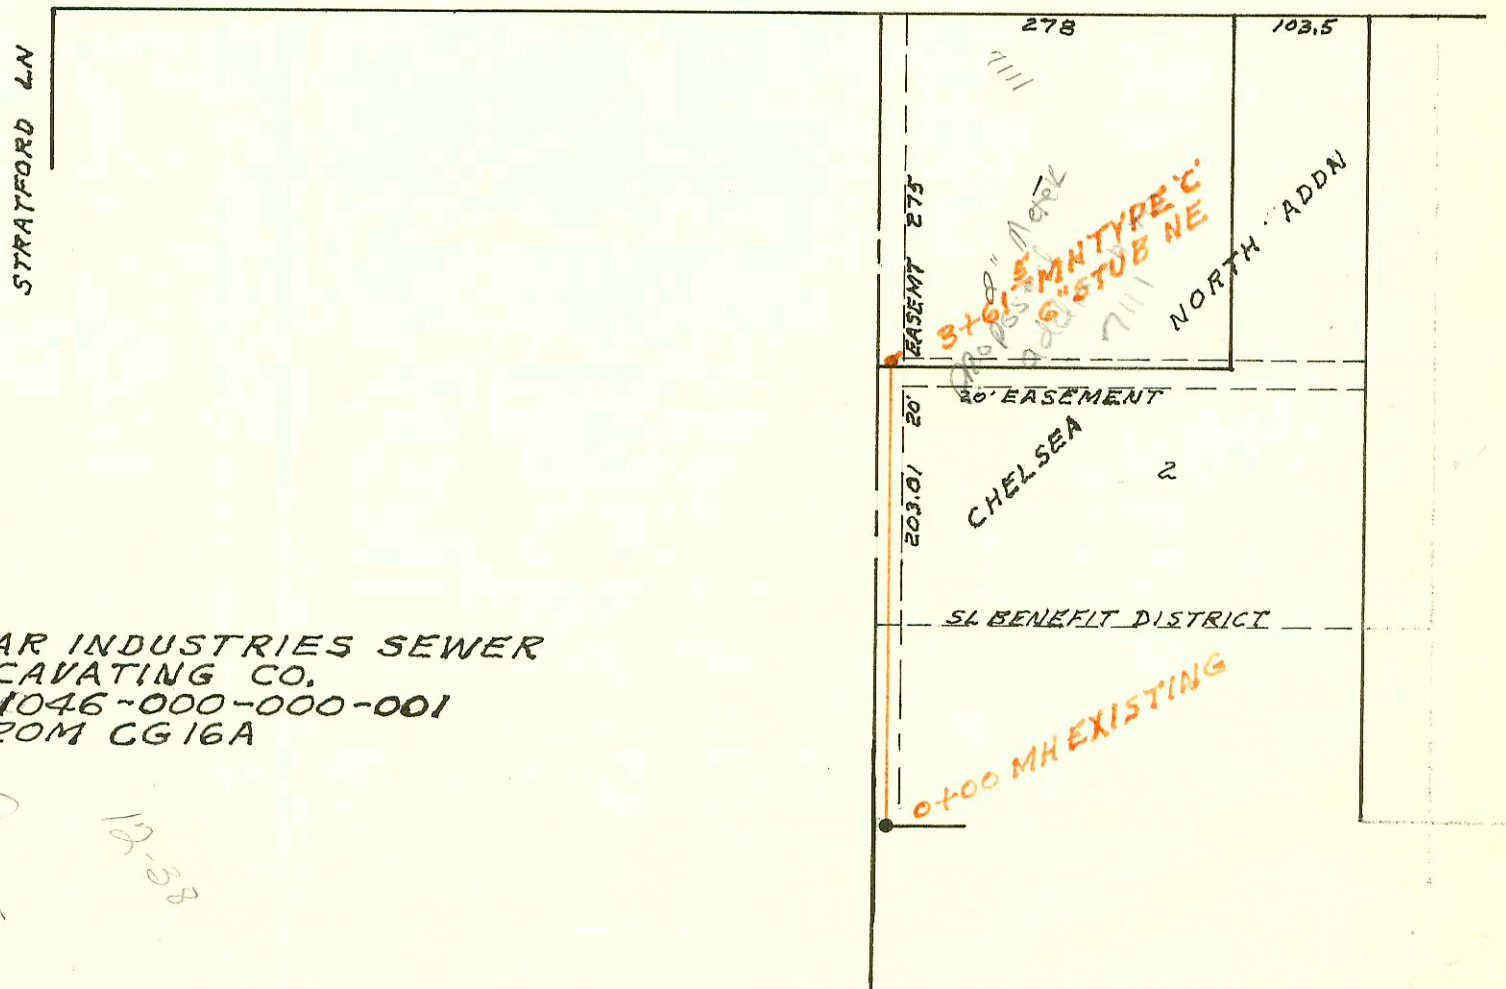

CONSTRUCTION RECORD							SERVICE RECORD					
STATION	ELEVATION		Depth	MANHOLE	4-INCH "Y" BRANCHES		No. of Permit		House Number		DATE OF PERMITS	
	Ground	Grade			North West	South East	North West	South East	North West	South East	North West	South East
LAT 3 MAIN 2 SWI (CONT'D)												
24+00	86.7	81.53	5.2									
25+00	86.4	81.68	4.7		24+53.34 25+29.25		6458 6459		4234 6 Grand Ave 4234 7 Grand Ave		9-1-82 9-1-82	
26+00	86.5	81.83	4.7		26+46.3		6460		4234 8 Grand Ave		9-1-82	
	86.5	81.92	4.6	26+58.2	8" STUB N 8" STUB E							
LATERAL 61 WAR INDUSTRIES SEWER												
LINE 1 0+00	179.8	169.45	10.4	0+00 EXISTING								
	179.9	169.54	10.4	0+92.8								
1+00	179.9	169.55	10.4									
2+00	180.2	169.65	10.6									
3+00	179.6	169.75	9.9									
	179.4	169.76	9.6	3+12.4								
4+00	178.9	169.85	9.1									
5+00	178.5	169.95	8.6									
	178.3	170.93	8.3	5+80.5								
6+00	178.0	170.05	8.0									
7+00	177.4	170.15	7.3									
8+00	175.8	170.25	5.6									
9+00	173.8	170.35	3.5									
	173.8	170.39	3.4	9+35.7	6" STUB SE		20295 2305		4755 E Quincy		3-15-81 1-7-81	
LINE 2 0+00	178.3	170.14	8.2	0+00 = 5+80.5 LINE 1								
1+00	178.7	170.44	8.3									
2+00	179.0	170.74	8.3									
3+00	179.5	171.04	8.5									
	179.9	171.19	8.7	3+49.8			2+77.5	13045	9707 E Quincy		2-13-85	
4+12.8	180.1	171.38	8.7	END PIPE (PLUG)								
LATERAL 15 MAIN 20 WAR INDUSTRIES SEWER												
0+00	207.2	197.00	10.2	0+00 EXISTING								
1+00	206.4	197.50	8.9									
2+00	206.2	198.00	8.2									
3+00	206.8	198.50	8.3									
	207.3	198.81	8.5	3+61.5			6" S.O.R. 35 3+23.5 N/C	953967	7111 E 21st (addition)		3-24-95	
								2120	7111 E 21st		12-15-80	
SAN SEWER LOT 2 BLOCK 1 NORTH BOROUGH ADDN												
LINE 1 0+00	199.0	193.00	6.0	0+00 EXISTING								
1+00		193.39					1+30.6	3808	8143 Woodland		7-30-81	
2+00		193.79										
	202.3	193.96	8.3	2+42.6								
LINE 2 0+00	197.9	191.30	6.6	0+00 EXISTING								
1+00		191.70										
	202.1	192.03	10.1	1+83.4								
2+00		192.10										