


**SANITARY SEWER FOR WICHITA MID-CONTINENT AIRPORT**  
BUILT BY: MID STATES CONST. CO.  
PROJ. NO 468-76-245-80804-000-000-008  
BOOKED 10-3-81 FROM BR55


**SANITARY SEWER FOR AIRPORT HILTON**  
BUILT BY: BELLES & ASSOCIATES INC.  
PROJ. NO 468-76-245-80000-000-000-008  
BOOKED 10-16-81 FROM BR17  
(SEE H249)

on map

Monroe Bank  
Airport Authority  
for cutting truck

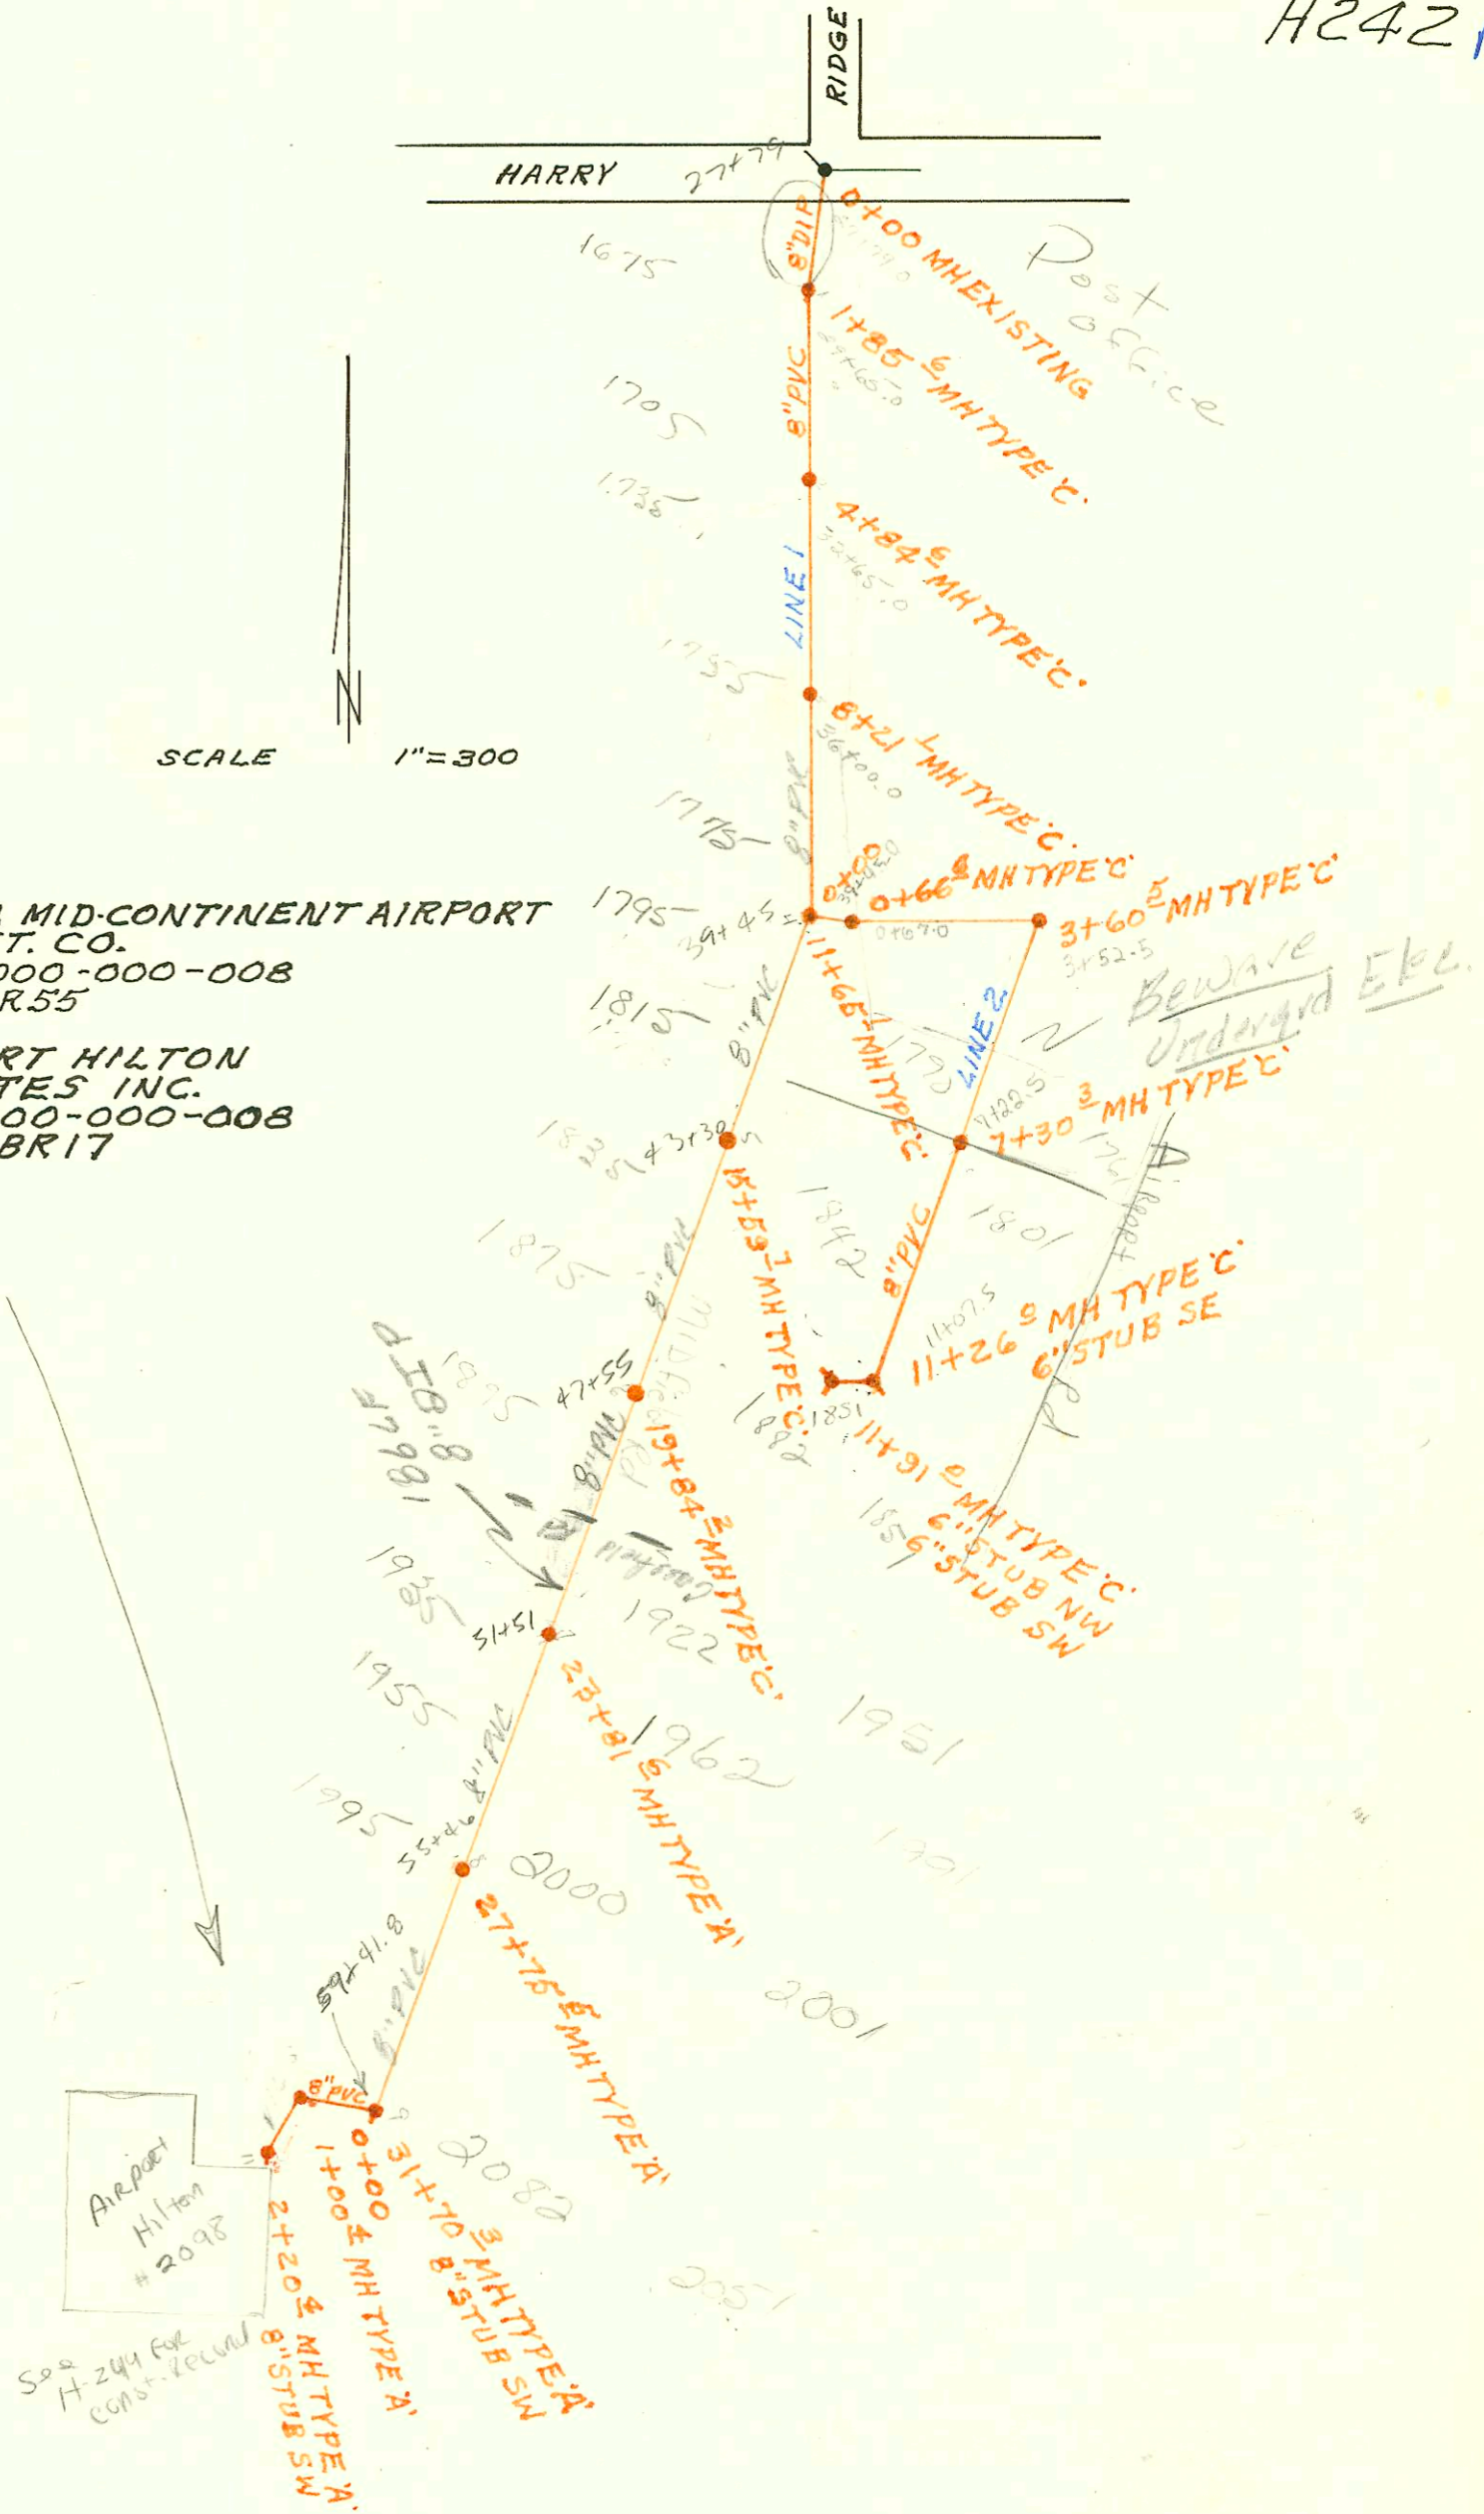

Per Jerry Blain  
City Maintains  
these lines. Permission  
for any MH TAPS must  
come from Sewer Maint.  
BL

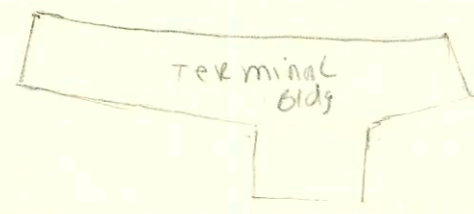

H242

CONSTRUCTION RECORD						SERVICE RECORD						
STATION	ELEVATION		Depth	MANHOLE	4-INCH "Y" BRANCHES		No. of Permit		House Number		DATE OF PERMITS	
	Ground	Grade			North West	South East	North West	South East	North West	South East	North West	South East
SEWER FOR MID-CONTINENT AIRPORT (CONT'D)												
14+00		123.50	8.3									
15+00		123.70	8.3									
	133.8	123.82	10.0	15+59.7								
16+00		123.90	8.0									
17+00		124.10	7.7									
18+00		124.30	7.4									
19+00		124.50	7.2									
	133.1	124.66	8.4	19+84.2								
20+00		124.70	6.7									
21+00		124.90	6.4									
22+00		125.10	6.3									
23+00		125.30	6.1			23+10.16		53520		1601 1702 Reported		12-12-80
	131.6	125.46	6.1	23+81.6	Sec. Permit		4118			1601 1702 Reported		9-14-81
						4" ABS 40 23+01.0 top		22520		#1962 M.I.P. 11/11/81		11-22-86
24+00		125.50	5.5									
25+00		125.70	5.5									
26+00		125.90	5.4									
27+00		126.10	5.3									
	131.8	126.25	5.6	27+75.5	27+71.5					1601 1702 Reported		10-8-81
28+00		126.30	5.3									
29+00		126.50	5.2									
30+00		126.70	5.2									
31+00		126.90	5.2									
	132.9	127.04	5.9	31+70.3								
												8" STUB SW
LINE 2 0+00	132.4	123.13	9.3	0+00=11+65.1 LINE 1								
	132.9	123.26	9.6	0+66.6								
1+00		123.33	8.6									
2+00		123.53	9.0									
3+00		123.73	9.3									
	133.7	123.85	9.9	3+60.5								
		123.95	9.8									
4+00		124.03	9.5									
5+00		124.23	9.3									
6+00		124.43	9.3									
7+00		124.63	9.2									
	134.2	124.69	9.5	7+30.3								
8+00		124.83	8.9									
9+00		125.03	8.7									
10+00		125.23	8.8									
11+00	134.3	125.43	8.8									
	134.5	125.48	9.0	11+26.0								
		125.58	8.9									
	134.5	125.71	8.8	11+91.0								

SAN  
LINE 1  
CONT'D

LINE 2

Form #192-020 (July, 1981)

# 07338 - 1-11-83 - 1835 Midfield - Brake Pkgs - 55' S. of MH  
 # 08216 - 5-23-83 - 1895 Midfield - Brake Pkgs - 98.6' N. of MH  
 # 09233 - 9-16-83 - 1955 Midfield - Brake Pkgs - 200' N. of MH

1601 S. Airport Rd, Suite 1701 (#92-36457-7) Serves new north addition - Neoprene Saddle - 4" hub and spigot east iron - 4" drain layer tap - 28.5' south from same manhole - 14" pf shallow  
 99-89207 6-3-97 1601 S AIRPORT RD (205) MS L-