



SANITARY SEWER FOR PLAZA WEST APARTMENTS
BUILT BY: CEC DITCHING
PROJ. NO 468-76-245-80911-000-000-008
BOOKED 10-3-81 FROM BR55

on map

SCALE 1" = 200'

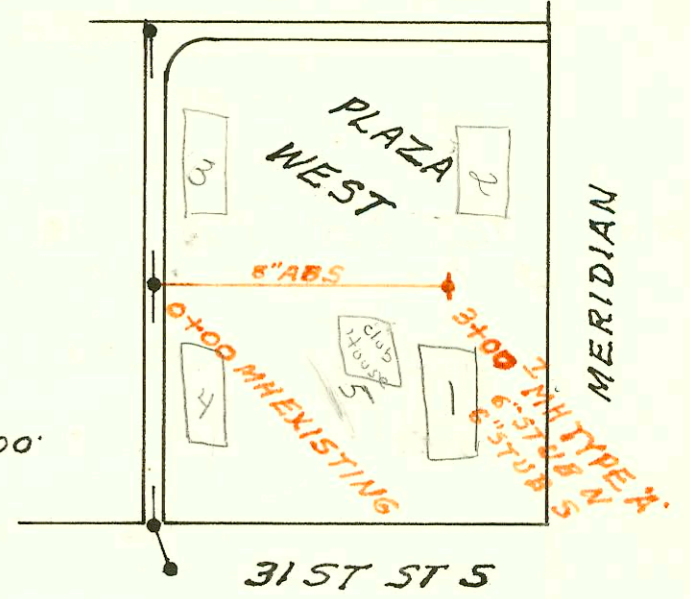

SCALE 1" = 300'

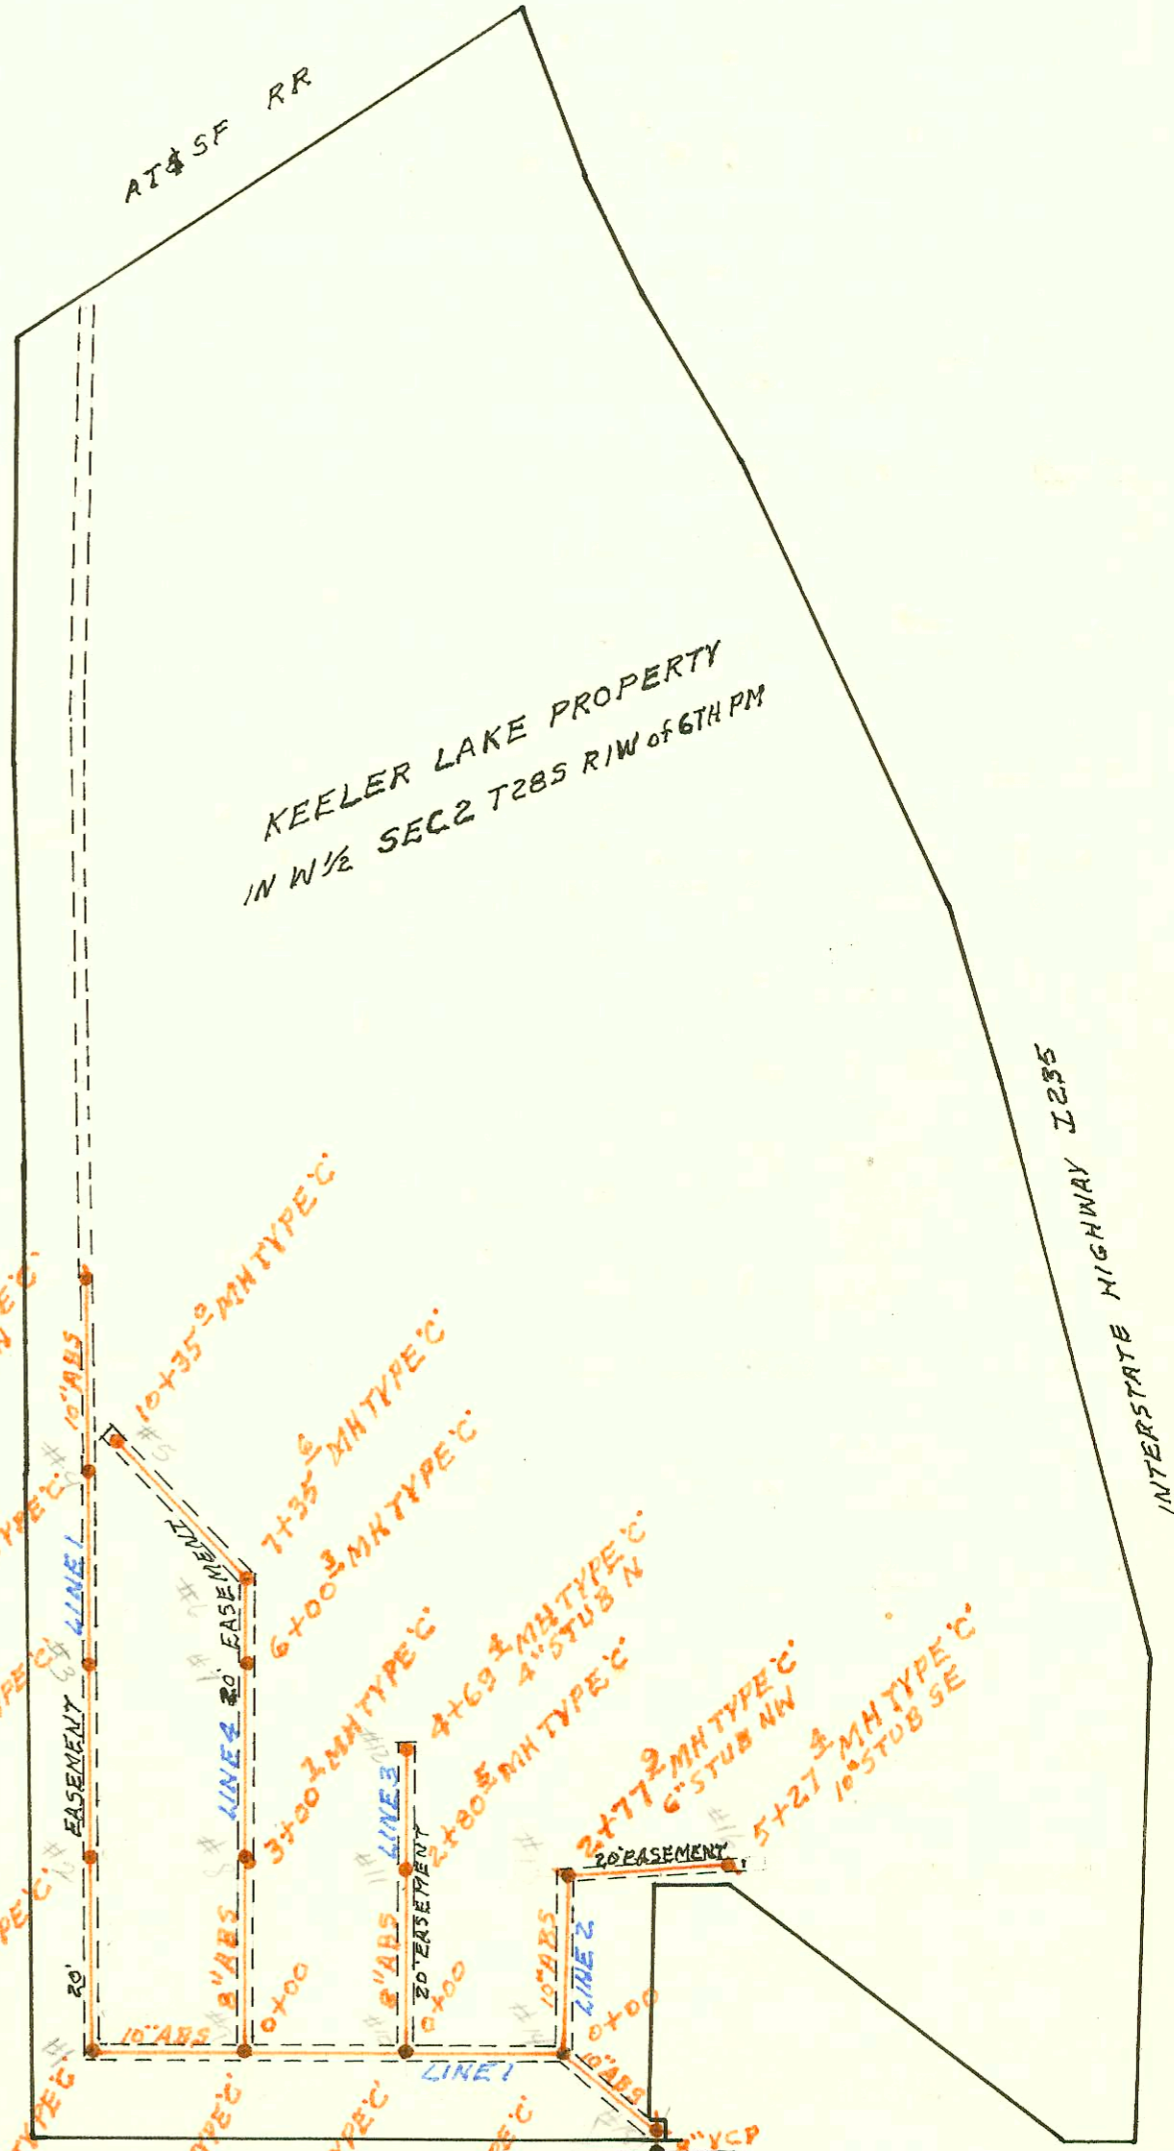

KEELER LAKE PROPERTY
IN W 1/2 SEC 2 T28S R1W of 6TH PM

SANITARY SEWER FOR KEELER LAKE PROPERTY
BUILT BY: UTILITY CONTR, INC.
PROJ. NO 468-76-245-80525-000-000-008
BOOKED 10-5-81 FROM BR55

on map

31ST ST S
6\"/>

CONSTRUCTION RECORD							SERVICE RECORD					
STATION	ELEVATION		Depth	MANHOLE	4-INCH "Y" BRANCHES		No. of Permit		House Number		DATE OF PERMITS	
	Ground	Grade			North West	South East	North West	South East	North West	South East	North West	South East
SANITARY SEWER FOR PLAZA WEST APTS												
0+00	97.6	91.69	5.9	EXISTING								
1+00		92.09			1+19.0	1+15.0	87	88	2526 W 312 53	2526 W 313 53	4-15-80	4-15-80
2+00		92.49			1+22 N	1+22 S		317		2526 W 314 53		5-14-80
	98.5	92.89	5.6	3+00.7	2+90.7	2+88.9	86	85	2526 W 315 52	2526 W 315 51	4-15-80	4-15-80
					6" STUB N	6" STUB S						
SANITARY SEWER FOR KEELER LAKE PROPERTY												
0+00	101.4	90.30	11.1	EXISTING								
	101.6	91.42	10.2	0+34.0	4" STUB N	4" STUB E						
1+00	102.2	91.62	10.6									
2+00	102.8	91.92	10.9									
	103.2	91.98	11.2	2+21.5								
3+00	102.9	92.22	10.7									
								4547		4840 W 315 52		10-29-81
4+00	103.5	92.52	11.0									
	103.7	92.71	11.0	4+65.2	connected to MH	connected to MH	4541	4556	4840 W 315 41	4840 W 315 45	10-29-81	10-29-81
5+00	104.1	93.82	10.3									
6+00	104.1	94.12	10.0									
7+00	104.3	94.42	9.9									
	104.4	94.45	10.0	7+10.3						4840 W 315 26		10-29-81
8+00	104.6	94.72	9.9									
9+00	104.9	95.02	9.9									
	105.0	95.14	9.9	9+40.9	connected to MH	connected to MH	4532	4528	4840 W 315 24	4840 W 315 12	10-9-81	10-9-81
10+00	105.3	95.32	10.0									
11+00	105.9	95.62	10.3									
										4840 W 315 24		10-9-81
12+00	105.8	95.92	9.9									
	105.7	96.04	9.7	12+41.0						4840 W 315 26		10-9-81
13+00	105.4	96.22	9.2									
14+00	105.6	96.52	9.1									
										4840 W 315 28		10-9-81
15+00	106.4	96.82	9.6									
	106.7	96.94	9.8	15+40.1						4840 W 315 20		10-9-81
16+00	106.6	97.12	9.5									
17+00	106.1	97.42	8.7									
18+00	106.2	97.72	8.5									
	106.4	97.84	8.6	18+40.4	connected to MH					4840 W 315 112		10-9-81
19+00	106.7	98.02	8.7									
20+00	107.0	98.32	8.7									
21+00	107.6	98.62	9.0									
	107.9	98.74	9.2	21+40.0	10" STUB N							
LINE 2												
0+00	103.2	92.50	10.7	0+00=2+21.5	connected to MH	connected to manhole	4548	4550	4840 W 315 49-50	4840 W 315 52-51	10-29-81	10-29-81
1+00	103.0	92.80	10.2									
2+00	103.0	93.10	9.9									
	102.5	93.33	9.2	2+77.9	connected to MH	connected to MH	4549	4551	4840 W 315 48	4840 W 315 52-51	10-29-81	10-29-81