




SANITARY SEWER FOR CUSTOMER SERVICE FACILITY
 LEARJET CORPN.
 BUILT BY:
 PROJ. N^o 468-76-245-80000-000-000-008
 BOOKED 10-5-81 FROM BR55 (SEE L126)

on map

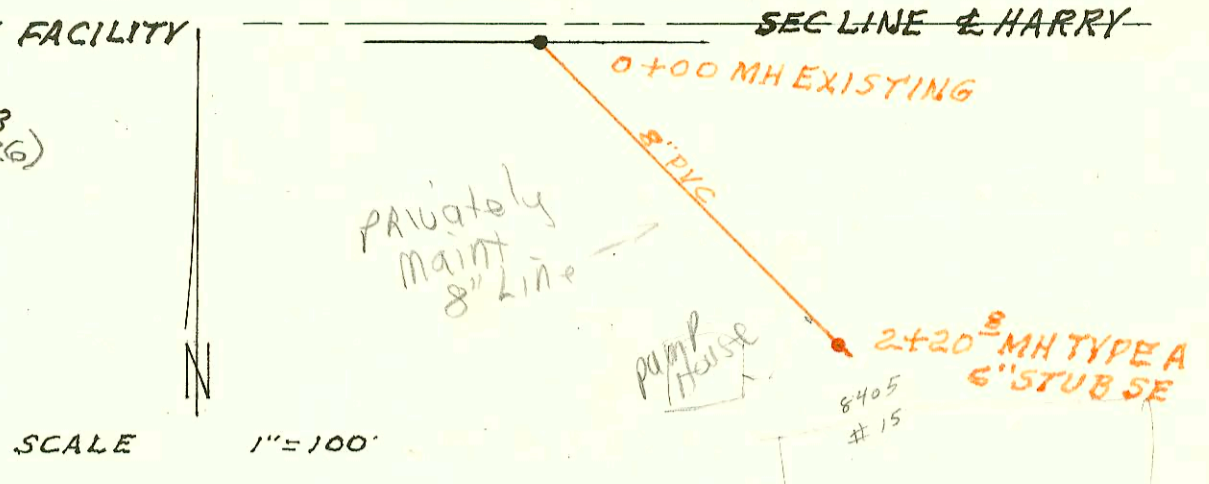

SANITARY SEWER FOR STONEY BROOK
 BUILT BY: UTILITY CONTR. INC.
 PROJ. N^o 468-76-245-80751-000-000-008
 BOOKED 10-6-81 FROM BR31

on map
 P. 12-34-35

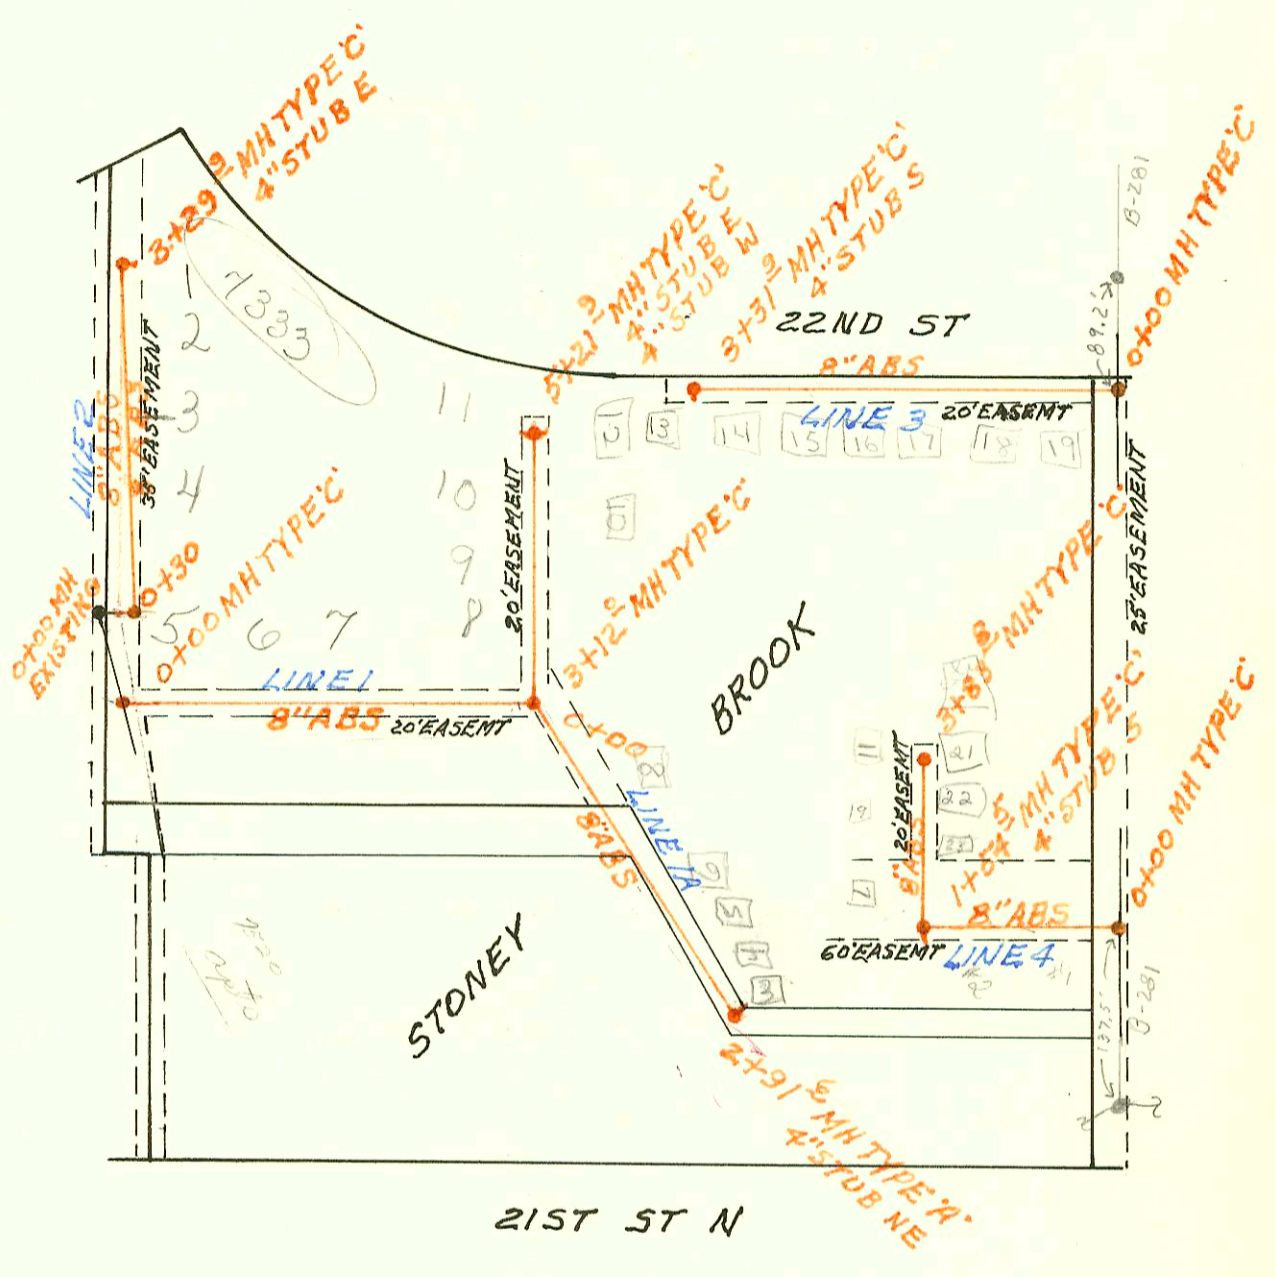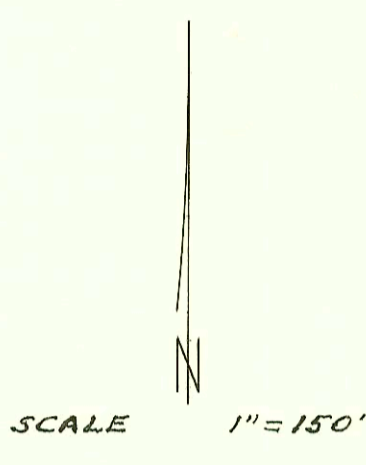

7530 E 21st N #22 (96.8.8.8.11.11.11)
 (MH) (15.7.8.8.11.11)
 #20 (Station) (MH)

H244

CONSTRUCTION RECORD						SERVICE RECORD							
STATION	ELEVATION		Depth	MANHOLE	4-INCH "Y" BRANCHES		No. of Permit		House Number		DATE OF PERMITS		
	Ground	Grade			North West	South East	North West	South East	North West	South East	North West	South East	
SAN SEWER FOR KEELER LAKE PROP (CONT'D)													
LIN 2 CONT'D	3+00	102.5	93.40	9.1									
	4+00	102.5	93.70	8.8									
	5+00	102.5	94.00	8.5									
		102.5	94.08	8.4	5+27.4	10" STUB SE							
LIN 3	0+00	103.7	92.88	10.8	0+00=4+65.2 LINE 1	Connected to mH	Connected to mH	4542	4546	4840 W 31st 39-40	4840 W 31st 44-45	10-29-81	10-29-81
	1+00	104.2	93.28	10.9									
	2+00	103.8	93.68	10.1									
		104.2	94.00	10.2	2+80.5	Connected to mH	Connected to mH	4543	4545	4840 W 31st 37-38	4840 W 31st 46-47	10-29-81	10-29-81
	3+00	104.4	94.08	10.3									
	4+00	104.0	94.48	9.5									
		103.4	94.76	8.6	4+69.4	4" STUB N	Connected to mH		4544	4840 W 31st 35-36		10-29-81	
LIN 4	0+00	104.4	94.60	9.8	0+00=7+10.3 LINE 1	Connected to mH	Connected to mH	4526	4537	4840 W 31st 21-22	4840 W 31st 27-28	10-29-81	10-29-81
	1+00	104.6	95.00	9.6									
	2+00	104.5	95.40	9.1									
		105.0	95.80	9.2	3+00.7	Connected to mH	Connected to mH	4535	4538	4840 W 31st 17-18	4840 W 31st 23-24	10-29-81	10-29-81
	4+00	105.3	96.20	8.9		Connected to mH	Connected to mH	4554	4555	4840 W 31st 19-20	4840 W 31st 31-32	10-29-81	10-29-81
	5+00	105.5	96.60	8.9									
		105.3	97.00	8.3	6+00.3	Connected to mH	Connected to mH	4524	4539	4840 W 31st 12-16	4840 W 31st 23-24	10-29-81	10-29-81
	7+00	105.8	97.40	8.4									
		105.5	97.54	8.0	7+35.6	Connected to mH		4533		4840 W 31st 12-14		10-29-81	
	8+00	106.0	97.80	8.2									
	9+00	106.7	98.20	8.5									
	10+00	107.0	98.60	8.4									
		106.7	98.74	8.0	10+35.0								
SAN SEWER FOR GATES LEAR JET CUSTOMER SERVICE FACILITY													
	0+00	143.6	134.80	8.8	0+00 EXISTING								
	1+00	140.6	135.20	5.4									
										45-1932-7	#1 Leaker Widely	11-17-75	
	2+00	142.1	135.60	6.5									
		143.4	135.68	7.7	2+20.8	6" STUB SE		495		805 W HARRY #15		6-9-80	
SANITARY SEWER FOR STONEY BROOK LINE 1													
	0+00	224.3	207.71	16.6	0+00								
	1+00		208.11			1+10.0 to 1+51.0 to		476519		4335 #10		11-29-79	
								476520		7335 #1		11-29-79	
	2+00		208.51										
	3+00		208.91										
		216.8	208.96 209.16	7.8 7.6	3+12.0	3+46.7 to		476521		4335 #8		11-29-79	
						3+74.9 to		4993		7520 E 31st 10		12-31-81	
	4+00		209.51			4+22.9 to 4+35.5 to		476499	4994	4335 #9	7520 17	2-20-80	12-31-81
								476500		#10		2-20-80	
	5+00		209.91										
		219.4	210.00	9.4	5+21.9	4" STUB W 4" STUB E		887		7325 #11		7-25-80	