


CENTRAL

SCALE 1" = 100'

SANITARY SEWER FOR LOTS 2,3,4  
BLOCK B & LOT 4 BLOCK C  
TY-CEN ADDN  
BUILT BY: THE HARDESTY CO.  
PROJ. NO 468-76-245-80889-000-000-008  
BOOKED 10-16 -81 FROM BR 17

5-9-81

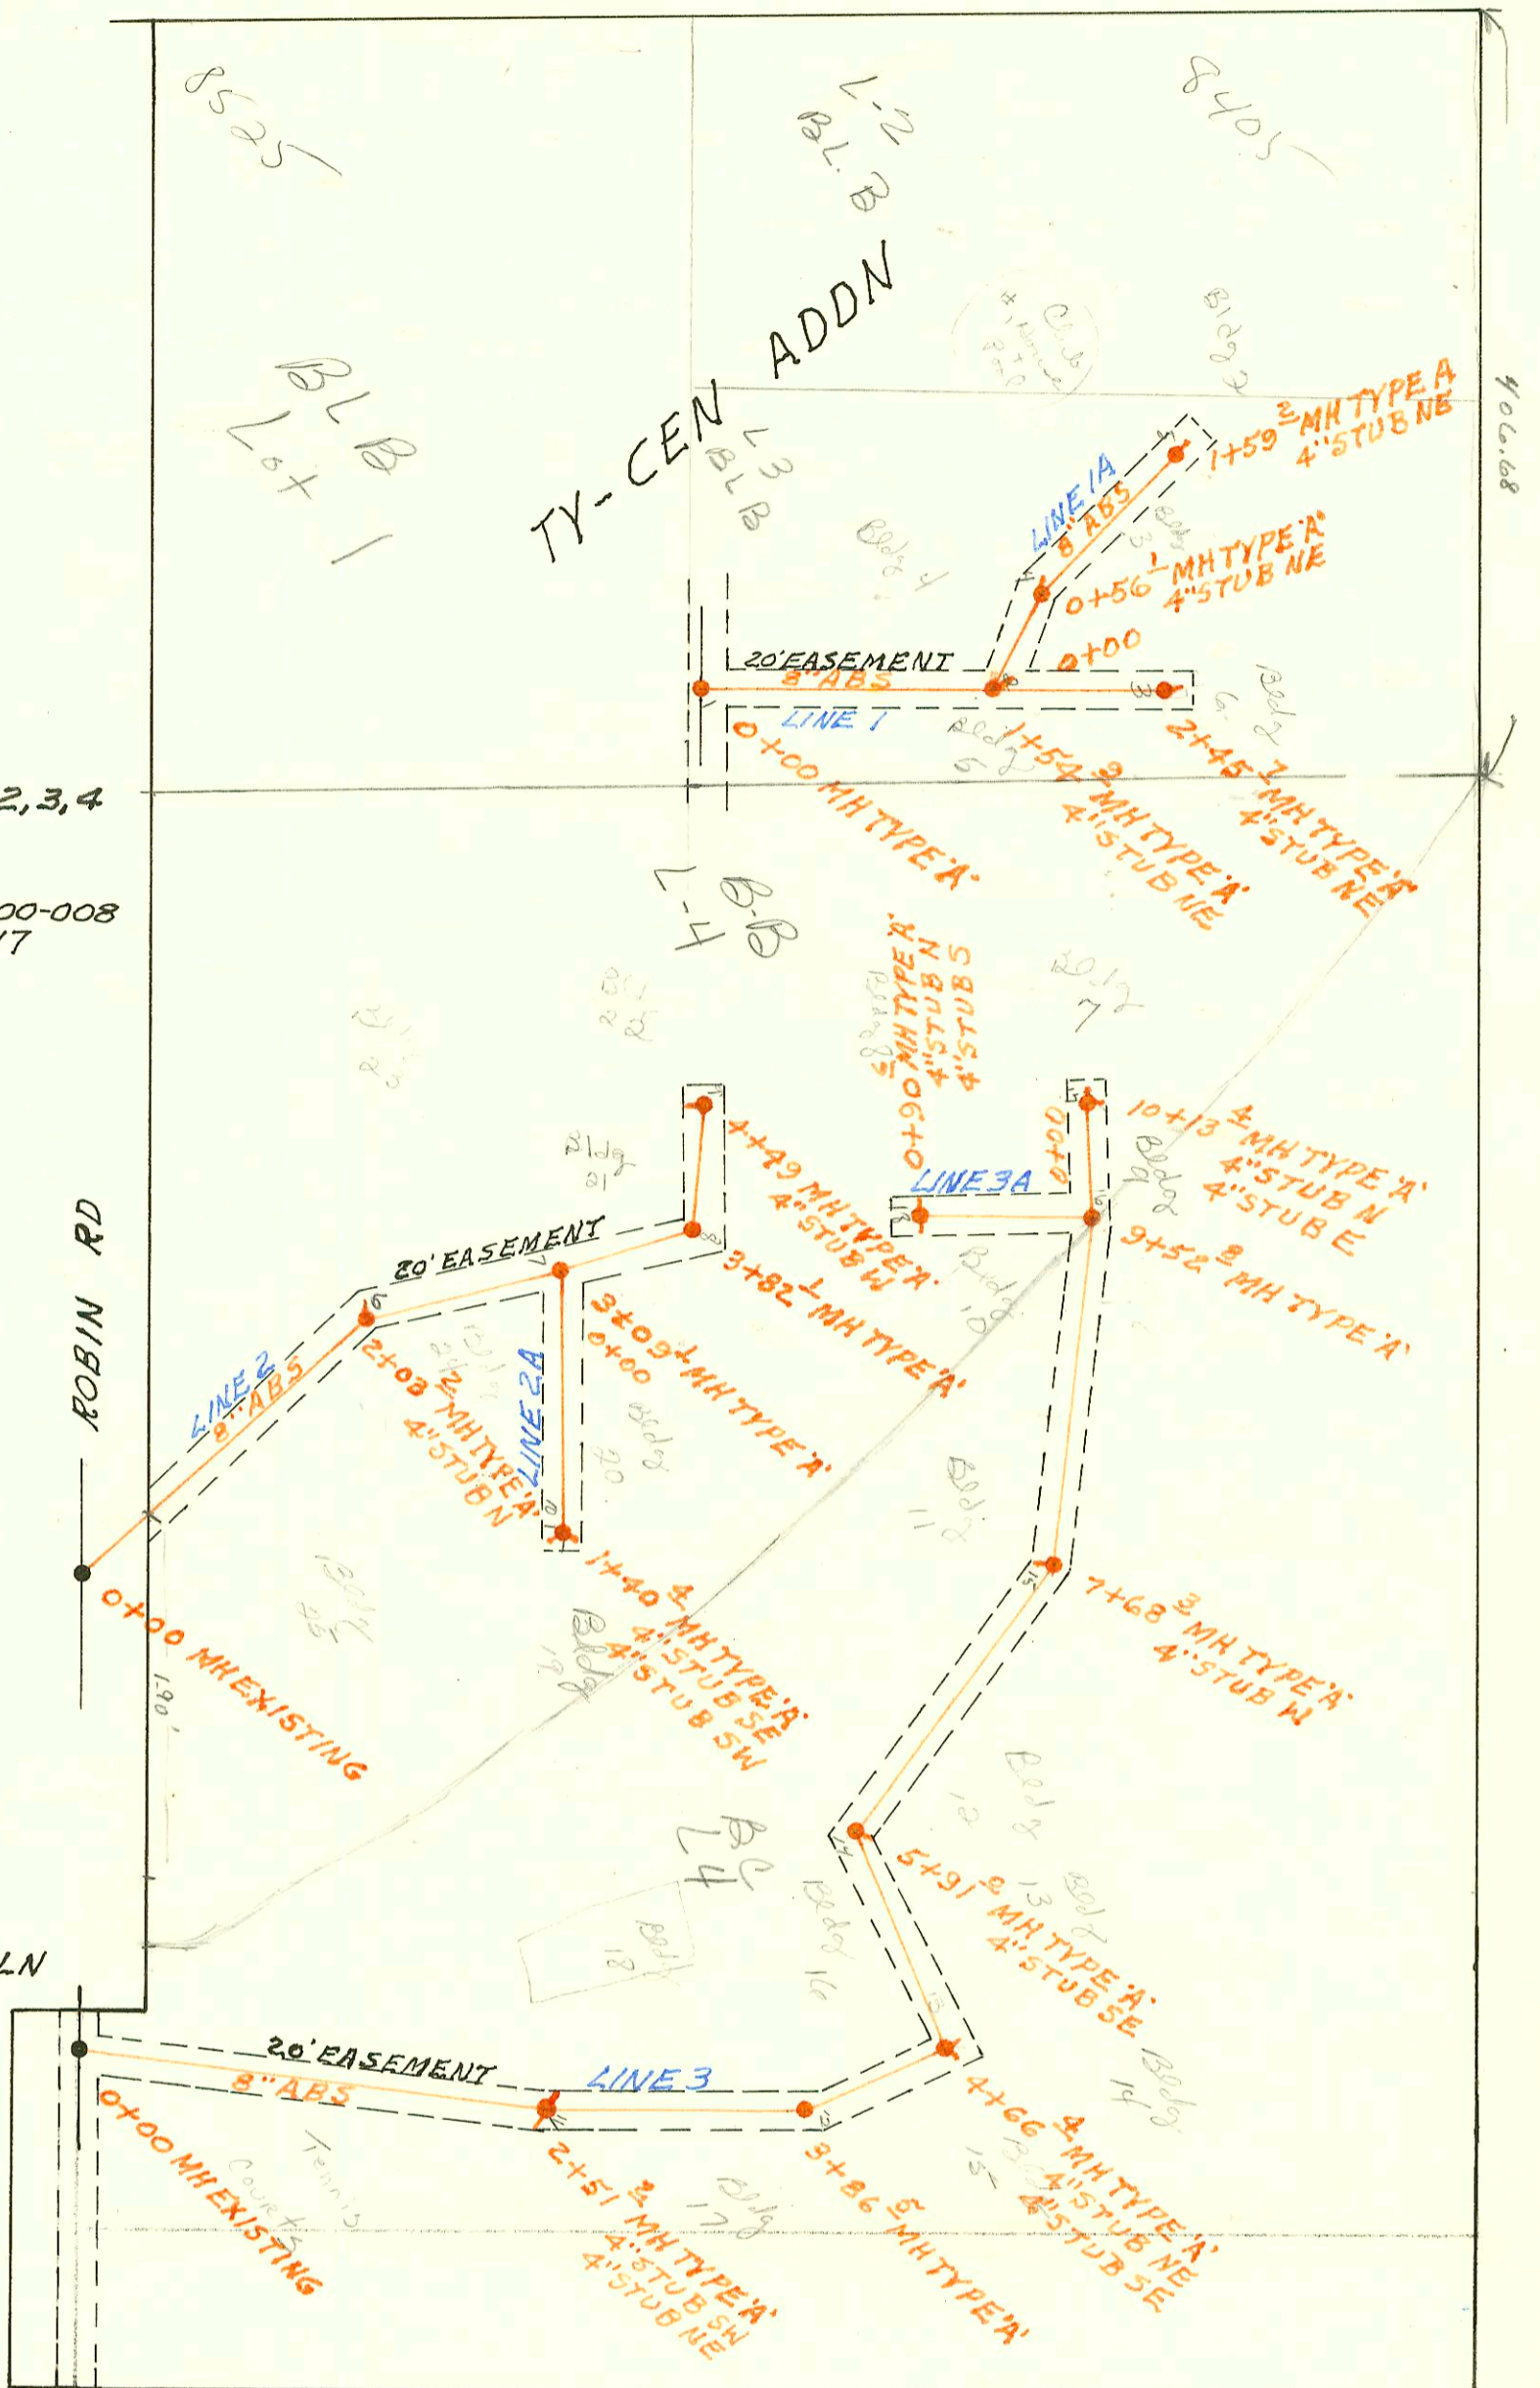

These Backings are as per the inspectors mens.

CONSTRUCTION RECORD

SERVICE RECORD

STATION	ELEVATION		Depth	MANHOLE	4-INCH "Y" BRANCHES		No. of Permit		House Number		DATE OF PERMITS	
	Ground	Grade			North West	South East	North West	South East	North West	South East	North West	South East
SAN SEWER FOR LOTS 2,3,4 BLK B & LOT 4 BLK C TYCEN ADDN												
LINE 1 0+00	144.5	140.47	4.0	0+00								
1+00		140.77			1+28.8		249		8405 W Central		5-6-80	
	145.4	141.04	4.4	1+54.9		4" STUB NE		248	8405 W Central		5-6-80	
2+00		141.17				2+14.3		250	8405 S Central		5-6-80	
	145.3	141.31	4.0	2+45.7		4" STUB NE		251	8405 W Central		5-6-80	
LINE 1A 0+00	145.4	141.04	4.4	0+00 = 1+54.9 LINE 1					8405 W Central		5-6-80	
	146.1	141.31	4.8	0+56.1		4" STUB NE		246	8405 W Central		5-6-80	
1+00		141.44										
	146.0	141.62	4.4	1+59.2		4" STUB NE		247	8405 W Central		5-6-80	
LINE 2 0+00	143.2	138.30	4.9	0+00 EXISTING								
1+00		138.60										
2+00		138.90										
	144.9	138.91	6.0	2+03.2		4" STUB N		411	8405 W Central		5-29-80	
		139.01	5.9									
3+00		139.30										
	144.5	139.33	5.2	3+09.1								
		139.43	5.1									
	143.9	139.65	4.3	3+82.1								
		139.75	4.2									
4+00		139.80										
	144.4	139.95	4.5	4+49		4" STUB W		409	8405 W Central		5-29-80	
								410	8405 W Central		5-29-80	
LINE 2A 0+00	144.5	139.43	5.1	0+00 = 3+09.1 LINE 2								
1+00		139.73										
	145.2	139.85	5.4	1+40.4		4" STUB SW 4" STUB SE		413	8405 W Central	8405 W Central	5-29-80	5-29-80
								407	8405 W Central	8405 W Central	5-29-80	5-29-80
LINE 3 0+00	141.8	137.59	4.2	0+00 EXISTING								
1+00		137.84										
2+00		138.09										
	144.4	138.22	6.2	2+51.2		4" STUB NE 4" STUB SE		498	8405 W Central	8405 W Central	6-9-80	6-9-80
								497	8405 W Central	8405 W Central	6-9-80	6-9-80
3+00		138.36										
	145.2	138.62	6.6	3+86.5								
		138.72	6.5									
4+00		138.76										
	145.4	138.96	6.4	4+66.4		4" STUB NE 4" STUB SE		496	8405 W Central	8405 W Central	6-9-80	6-9-80
		139.06	6.3					494	8405 W Central	8405 W Central	6-9-80	6-9-80
5+00		139.16										
	144.7	139.44	5.3	5+91.0		4" STUB SE		493	8405 W Central	8405 W Central	6-9-80	6-9-80
		139.54	5.2					492	8405 W Central	8405 W Central	6-9-80	6-9-80
6+00		139.56										
7+00		139.86										
	144.6	140.07	4.5	7+68.3		4" STUB W		301	8405 W Central		5-14-80	
		140.17	4.4									
8+00		140.26										
9+00		140.56										
	145.4	140.72	4.7	9+52.8								
		140.82	4.6									
10+00		140.96										
	145.2	141.00	4.2	10+13.4		4" STUB N 4" STUB E		299	8405 W Central		5-14-80	
LINE 3A 0+00	145.4	140.82	4.6	0+00 = 9+52.8 LINE 3								
	145.0	141.09	3.9	0+90.6		4" STUB N 4" STUB S		297	8405 W Central	8405 W Central	5-14-80	5-14-80
								298	8405 W Central	8405 W Central	5-14-80	5-14-80