


LATERAL 20 MAIN 1 WESTLINK SEWER  
 BUILT BY: ARKANSAS CONST. CO.  
 PROJ. N<sup>o</sup> 468-76-245-80761-000-000-001  
 BOOKED 10-17-81 FROM DCD 162


*on map*

555

SCALE 1" = 200'

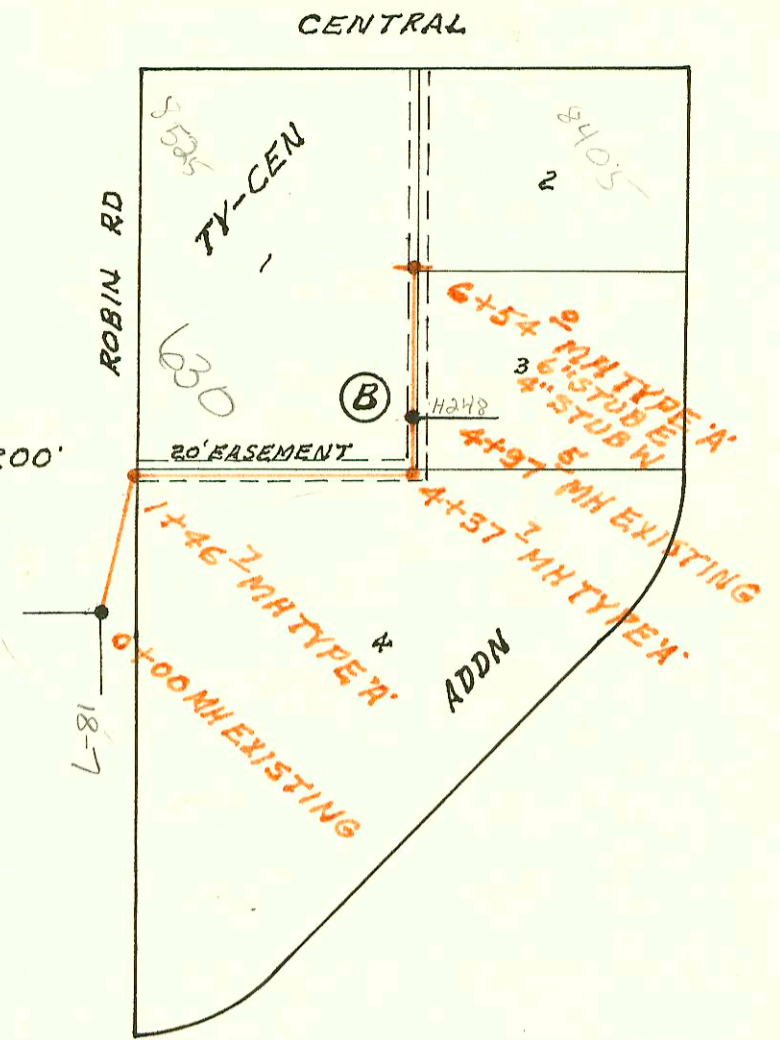

SCALE 1" = 300'

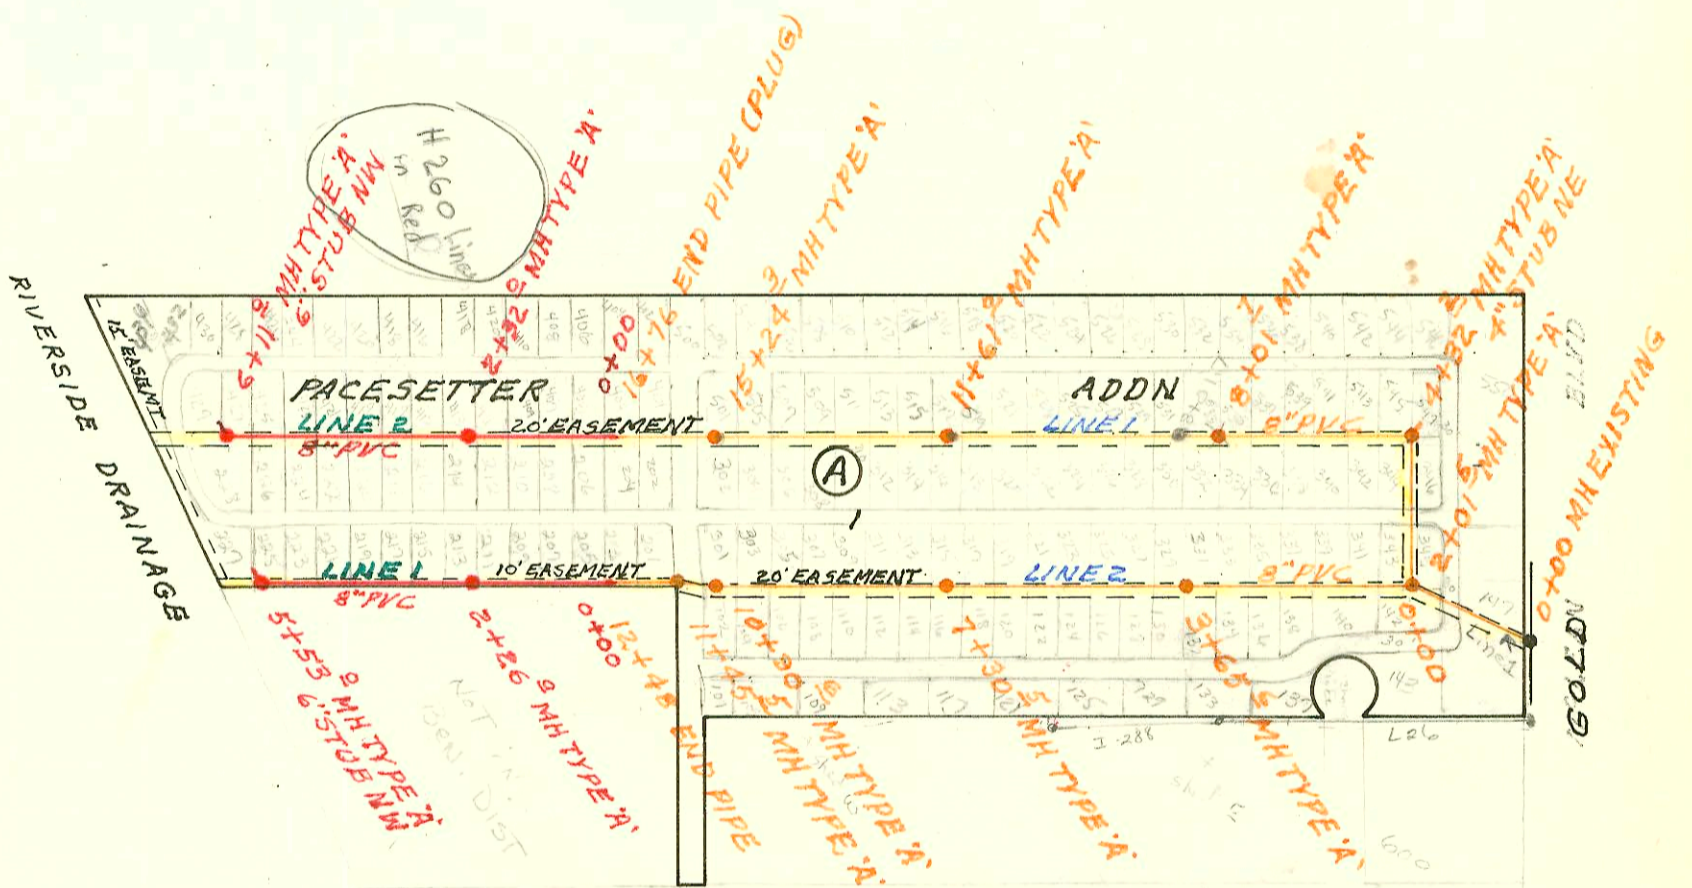

LATERAL 160 SOUTHWEST INTERCEPTOR SEWER  
 BUILT BY: ARKANSAS CONST. CO.  
 PROJ. N<sup>o</sup> 468-76-245-81041-000-000-001  
 BOOKED 10-19-81 FROM CG 18

MACARTHUR RD  
 PACESETTER  
 MOBILE HOME  
 PARK 1983

- LATERAL 163 SOUTHWEST INTERCEPTOR SEWER  
 BUILT BY: MID STATES CONST. CO.  
 PROJ. N<sup>o</sup> 468-76-245-81053-000-000-001  
 BOOKED 12-17-81 FROM DCD 99  
**SEE PAGE H260 FOR DATA**

*on map*  
 (770w Mac Art)

7228-222-  
 7229-224-  
 7230-226-  
 7231-228-

6110 E  
 " " "  
 " " "  
 " " "

