


LATERAL 7 MAIN 22 WAR INDUSTRIES SEWER
 BUILT BY: UTILITY CONTR. INC.
 PROJ. N^o 468-76-245-80799-000-000-001
 BOOKED 10-24-81 FROM CG23

127 map

3/24/03
 IN process to
 plat and change
 to individual ownership
 of lots. Drain layer
 would want owner to
 set with other neighbor
 Assoc + other neighbor
 if repair of sewer
 line would cross
 another lot
 lawyer's agreement
 part of platting
 BK

SCALE 1" = 150'

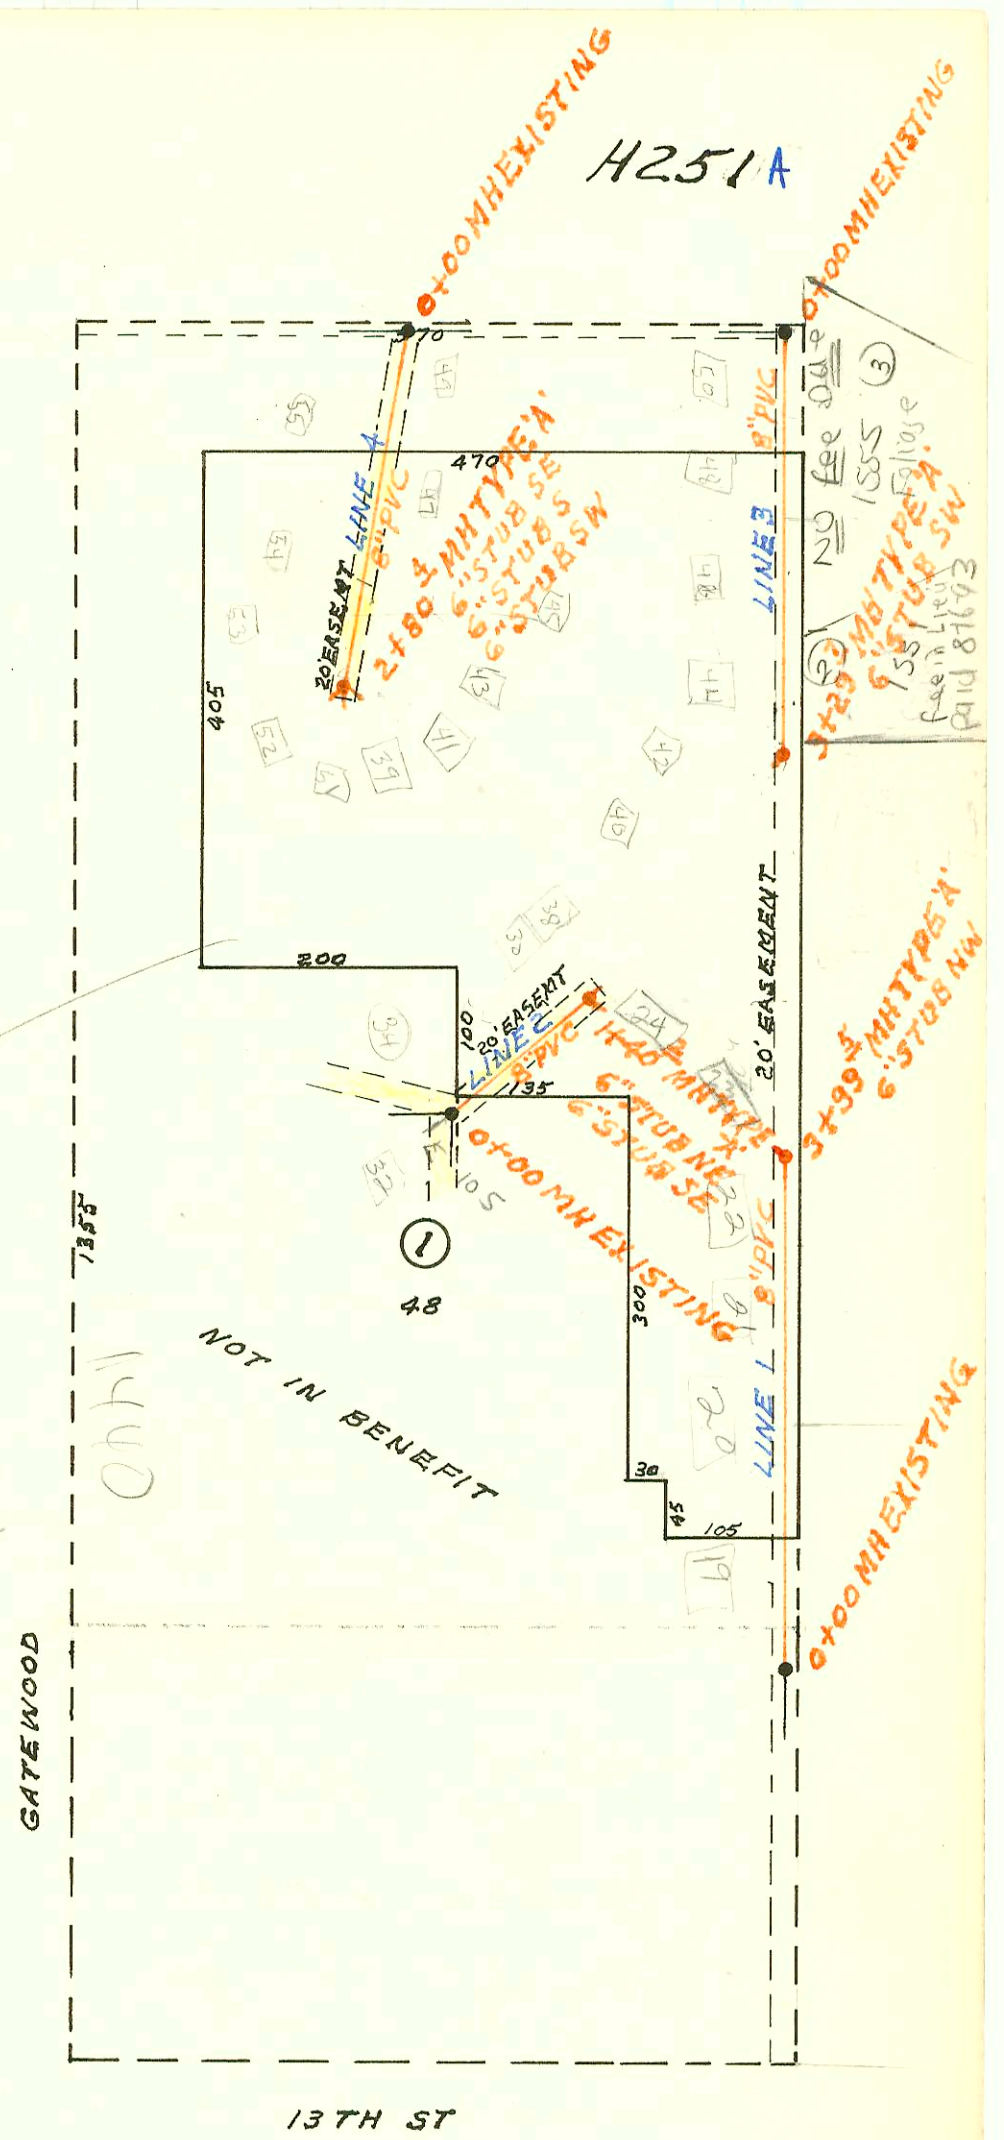

(1551 N foliage case)
 BK 1 Lot 2 foliage Add
 fee of 1,925⁰⁰ in kind of Lat. Asses paid
 8116143 per Greg Johnson (G.D. Properties)

Dewey Prop

473 - 1440 Lot 23 - 11-17-81 Jack Brannan 3+33.9 (6" stub)
 491 - 1440 Lot 21 - 12-14-81 " " 3 (2+99.9) (99.6 3 3+113)
 495 - 1440 Lot 22 - " " " (3+21.9) (17.65 3 3+113)

H251

CONSTRUCTION RECORD						SERVICE RECORD							
STATION	ELEVATION		Depth	MANHOLE	4-INCH "Y" BRANCHES		No. of Permit		House Number		DATE OF PERMITS		
	Ground	Grade			North West	South East	North West	South East	North West	South East	North West	South East	
33 MAIN 17 WIS (CONT'D)													
LAT LINE 1 CONT'D	15+00	178.2	168.75	9.5									
	16+00	178.7	169.35	9.4									
		181.5	169.76	11.7	16+69.1								
			169.86	11.6									
	17+00	179.6	169.98	9.6									
					17+37.1			8233		1814-16		5-24-83	
	18+00	179.9	170.38	9.5									
		182.5	170.67	11.9	18+64.6					1820-00		5-25-83	
	19+00	180.0	170.78	9.2									
					19+40.1					1826-8		5-25-83	
	20+00	180.2	171.18	9.0									
		183.5	171.42	12.1	20+60.0					1830-32		5-25-83	
					4" stub SW	4" stub SW		8238		1836-88		5-25-83	
LINE 2	0+00	174.3	163.36	10.9									
					0+00 = 2+56.8								
	1+00	174.6	163.78	10.8									
					1+37.0	1+28.8		11736	8239	1844-16	1815-17	4-18-84	5-25-83
	2+00	174.2	164.18	10.0									
		174.5	164.41	10.1	2+56.8					1824-26	1824-5	4-18-84	11-15-84
								10787	9660	1824-26	1824-5	4-18-84	11-15-84
	3+00	174.4	164.58	9.8									
		174.5	164.81	9.7	3+33.4					1820-37	1831-33	4-18-84	11-15-83
								10738	9661	1820-37	1831-33	4-18-84	11-15-83
	4+00	174.5	165.05	9.5									
	5+00	174.4	165.41	9.0									
		175.4	165.69	9.7	5+78.9								
			165.80	9.6									
	6+00	174.3	165.89	8.4									
		176.0	166.22	9.8	6+64.7								
	7+00	175.2	166.48	8.7									
	8+00	176.7	167.23	9.5									
		177.8	167.98	9.8	8+84.7								
	9+00	178.0	168.09	9.9									
	10+00	179.1	168.84	10.3									
	11+00	180.0	169.59	10.4									
		180.0	169.73	10.3	11+04.6								
	12+00	180.5	170.49	10.0									
	13+00	180.8	171.29	9.5									
		181.2	171.78	9.4	13+60.7								
					4" stub N	4" stub S							
LINE 3	0+00	174.5	164.49	10.0									
					0+00 = 2+56.8								
	2+00	176.2	166.75	9.5									
	3+00	177.5	167.85	9.7									
		177.6	168.24	9.4	3+35.6								
			168.38	9.2									
	4+00	178.2	169.13	9.1									
		178.6	170.27	8.3	4+98.5								
					4" stub NE	4" stub SE							
LINE 4	0+00	175.4	165.78	9.6									
		173.1	166.13	7.0	0+88.3								
LATERAL 7 MAIN 22 WAR INDUSTRIES SEWER	0+00	196.0	183.13	12.9									
LIN 1					0+00 EXISTING								
	1+00	196.5	183.53	13.0									

Form #192-020 (July, 1981)
CONT'D NEXT PAGE

W.C. #16210 9416 E. Skinner McCullough 5-5-86 (62642) (171.0E 64647-7135.7)