


SCALE 1" = 150'

LATERAL 15 MAIN 16 WAR INDUSTRIES SEWER
BUILT BY: UTILITY CONTR. INC.
PROJ. N^o 468-76-245-80743-000-000-001
BOOKED 10-31-81 FROM JLA 24

057 map

12-62

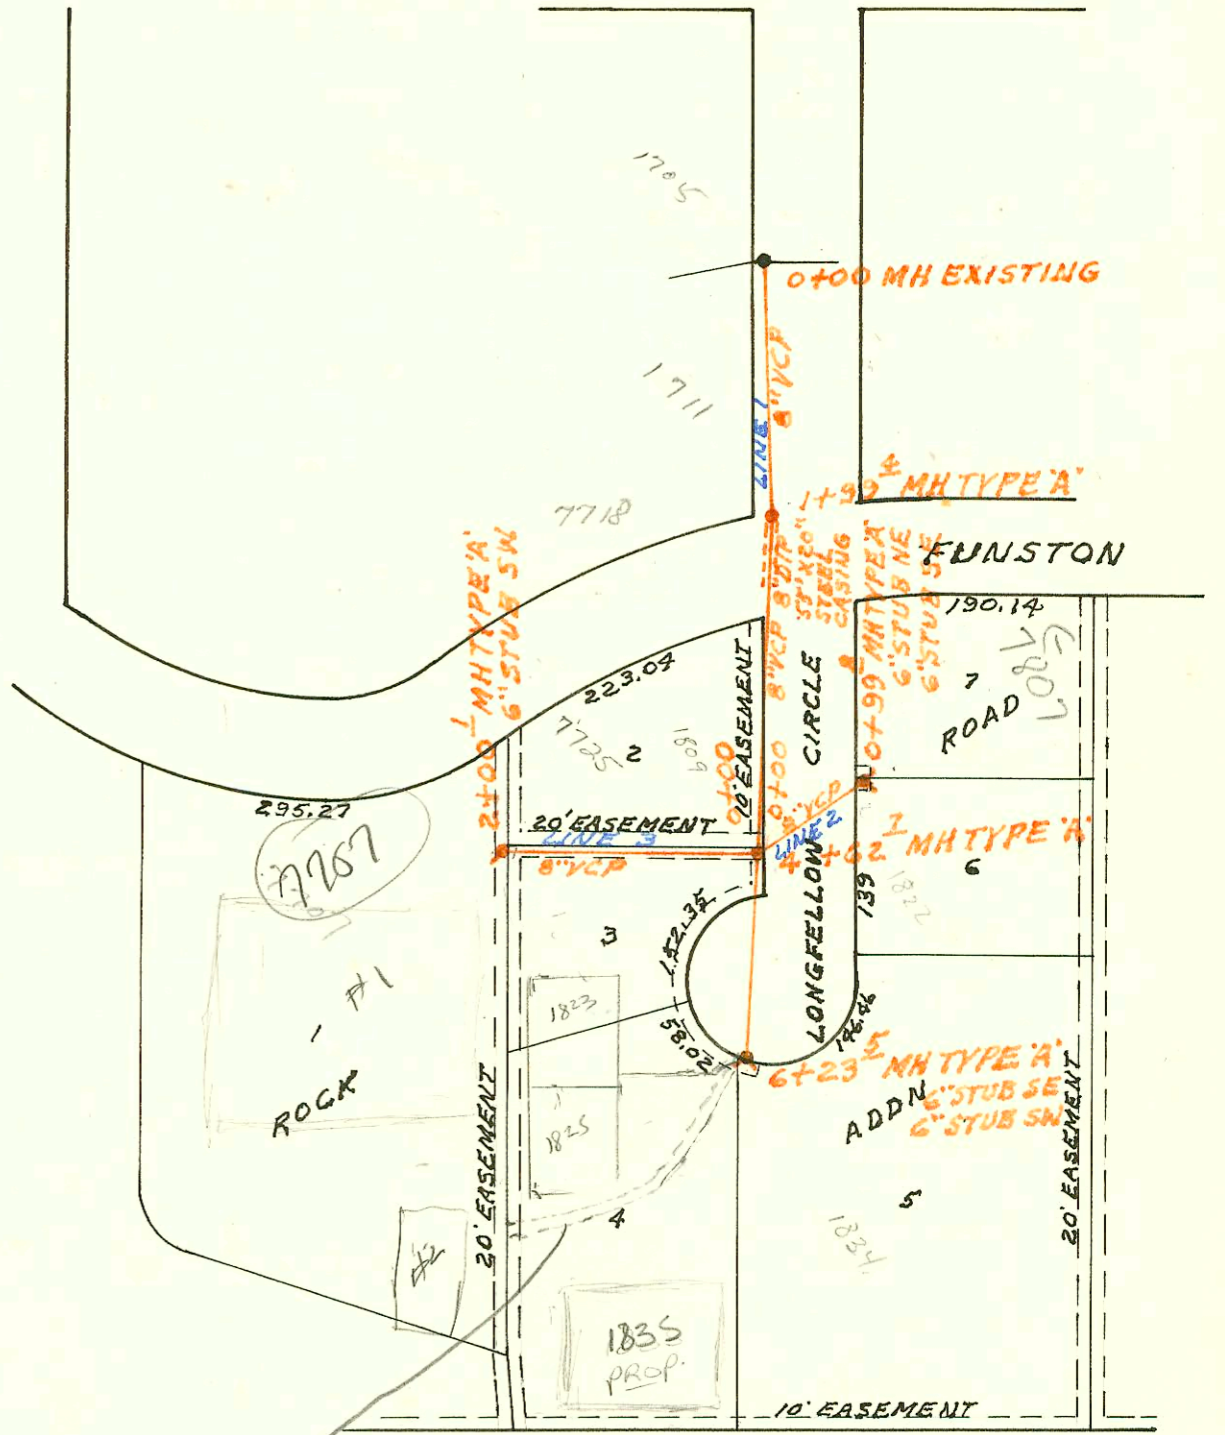


PA/late 10 FT
FSM + granted
for lot 1 Rock Road
for 1707 Funston bldg
Dec/Jan - PG
29077833
BL

SCALE 1" = 150'

LATERAL 44 SANITARY SEWER N^o 20
BUILT BY: UTILITY CONTR. INC.
PROJ. N^o 468-76-245-81072-000-000-001
BOOKED 10-31-81 FROM CLG 14

on map

9-35

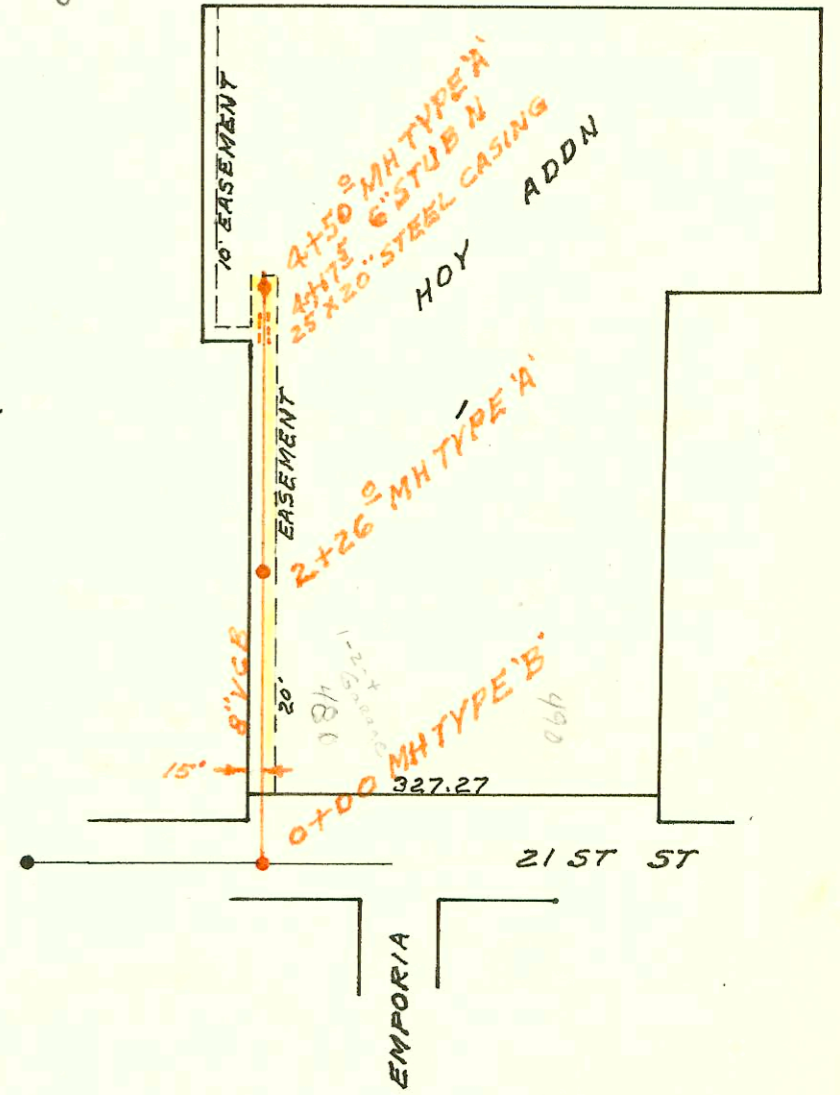

H252

CONSTRUCTION RECORD							SERVICE RECORD					
STATION	ELEVATION		Depth	MANHOLE	4-INCH "Y" BRANCHES		No. of Permit		House Number		DATE OF PERMITS	
	Ground	Grade			North West	South East	North West	South East	North West	South East	North West	South East
LAT LINE 1 CONT'D	7 MAIN 22 W.I.S (CONT'D)											
2+00	197.1	183.93	13.2									
3+00	197.8	184.33	13.5									
	198.7	184.73	14.0	3+99.5	6" STUB NW							
LINE 2	0+00	196.3	183.90	12.4	0+00 EXISTING			21826		1440 #30 Gatewood		11-10-88
1+00	197.6	184.30	13.3									
	197.0	184.46	12.5	1+40.2	6" STUB NE 6" STUB SE			21825	3245	1440 #38 Gatewood 1440 #34 Gatewood		11-10-88 5-10-81
LINE 3	0+00	197.7	186.42	11.3	0+00 EXISTING	4" SDR 35 0+34.0 tap		92-1628-7		1440 N. #50 Gatewood		1-17-92
1+00	198.1	186.82	11.3									
						4" PUC 40 1+60.0 tap		92-22975-7		1440 Gatewood #46		5-24-91
2+00	198.5	187.22	11.3			4" SDR 35 2+58.6 tap		92-37210-7		1440 #44 Gatewood		
						2+94.7 tap	4" SDR 35 2+49	22331	94-2113-7	1440 #42 Gatewood	1555 Foliage Cove	1-3-89 2-14-94
3+00	199.0	187.62	11.4									
	198.0	187.74	10.3	3+29.7	6" STUB SW 6" STUB SW			16781		1440 Gatewood #8		9-18-86
LINE 4	0+00	195.4	182.50	12.9	0+00 EXISTING							2-10-86 3-10-86
						0+54.0 tap 0+51.0 tap		15770	15760	1440 #55 Gatewood	49	3-10-86 3-10-86
1+00	194.0	182.90	11.1			1+30.0 tap 1+27.0 tap		15767	15761	54	47	3-10-86 3-10-86
						1+78.4 tap 1+79.9 tap		15768	15762	53	45	3-10-86 3-10-86
2+00	194.1	183.30	10.8			2+64.9 tap 2+61.4 tap		15767	15763	52	43	3-10-86 3-10-86
	194.2	183.62	10.6	2+80.4	6" STUB SW 6" STUB SW			15766	15764	1440 #51 Gatewood	1440 #41 Gatewood	3-10-86 3-10-86
						6" stub S		15765		1440 #59 Gatewood		3-10-86
LATERAL LINE 1	15 MAIN 16 WAR INDUSTRIES SEWER											
0+00	162.6	152.20	10.4	0+00 EXISTING								
1+00	162.6	152.60	10.0									
	162.6	153.00	9.6	1+99.4								
2+00	162.6	153.00	9.6									
3+00	163.8	153.40	10.4									
4+00	164.3	153.80	10.5									
	164.7	154.05	10.7	4+62.7								
5+00	163.1	154.20	8.9									
6+00	162.5	154.60	7.9									
	165.6	154.69	10.9	6+23.5	6" STUB SW 6" STUB SE	11" sch 40		2004 05798	3610	1823 Gatewood	18345 Langhorne	4-2-84 7-1-81
LINE 2	0+00	164.7	155.05	9.7	0+00 = 4+62.7 LINE 1							
	164.9	155.45	9.5	0+99.8	6" STUB NE 6" STUB SE			5327	2805-00112	7807 Fumator	1822 s.komfal	3-10-82 11-4-80
LINE 3	0+00	164.7	154.15	10.6	0+00 = 4+62.7 LINE 1							
1+00	161.8	154.55	7.3									
2+00	158.8	154.95	3.9	2+00.1	6" STUB SW			3883		77712 Gatewood		8-14-81
LATERAL LINE 1	44 SANITARY SEWER #20											
0+00	123.0	112.62		0+00								
1+00	124.2	113.02										
						1+68.9 tap		3654		480 E #1		7-10-81
2+00	124.2	113.42										
	124.5	113.52		2+26.0								
3+00	124.6	113.82										
						3+70.0 tap		3655		480 E #2		7-10-81
4+00	125.0	114.22										
	125.6	114.42		4+50.0	6" STUB N			3480		480 E #2		6-12-81

Form #192-020 (July, 1981)

* #20780 - 1440 N Gatewood #51 - New Conn to Bldg 6/2/88 -
 #20928 - 1440 N Gatewood #39 - Conn to Bldg - 6-23-88 -