



SCALE 1" = 150'

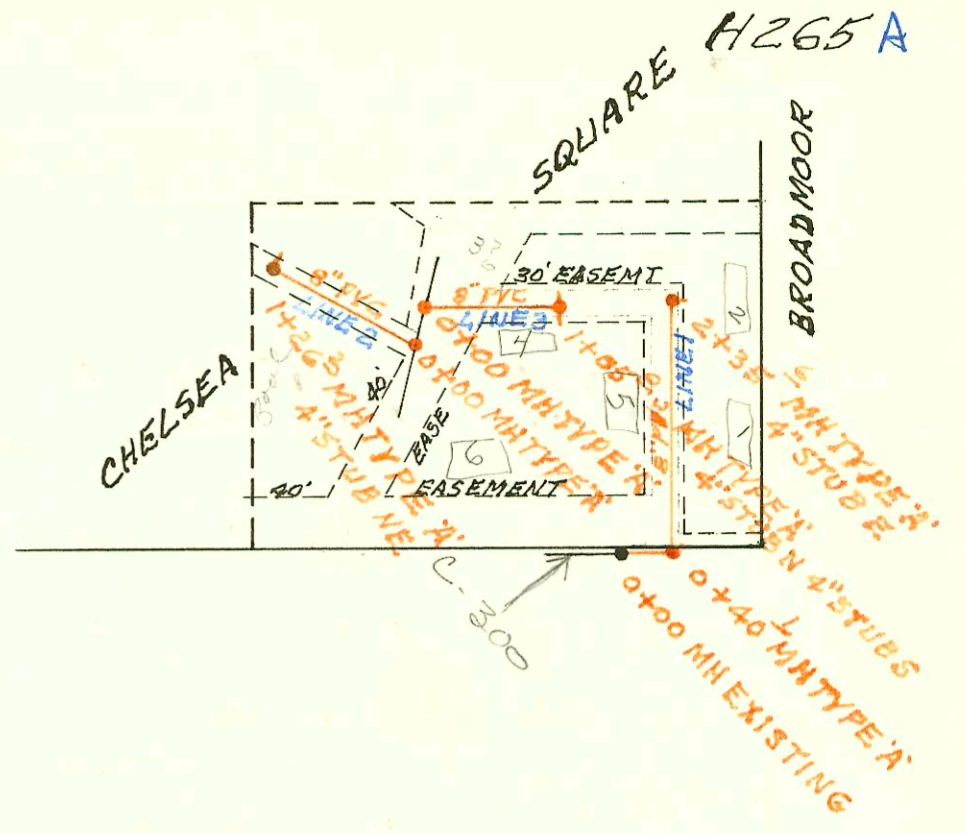

LATERAL 17 MAIN 20 WAR INDUSTRIES SEWER
 BUILT BY: UTILITY CONTR. INC.
 PROJ. NO 468-76-245-81147-000-000-001
 BOOKED 1-9-82 FROM AG 15

DN map
 17-008

SCALE 1" = 200'

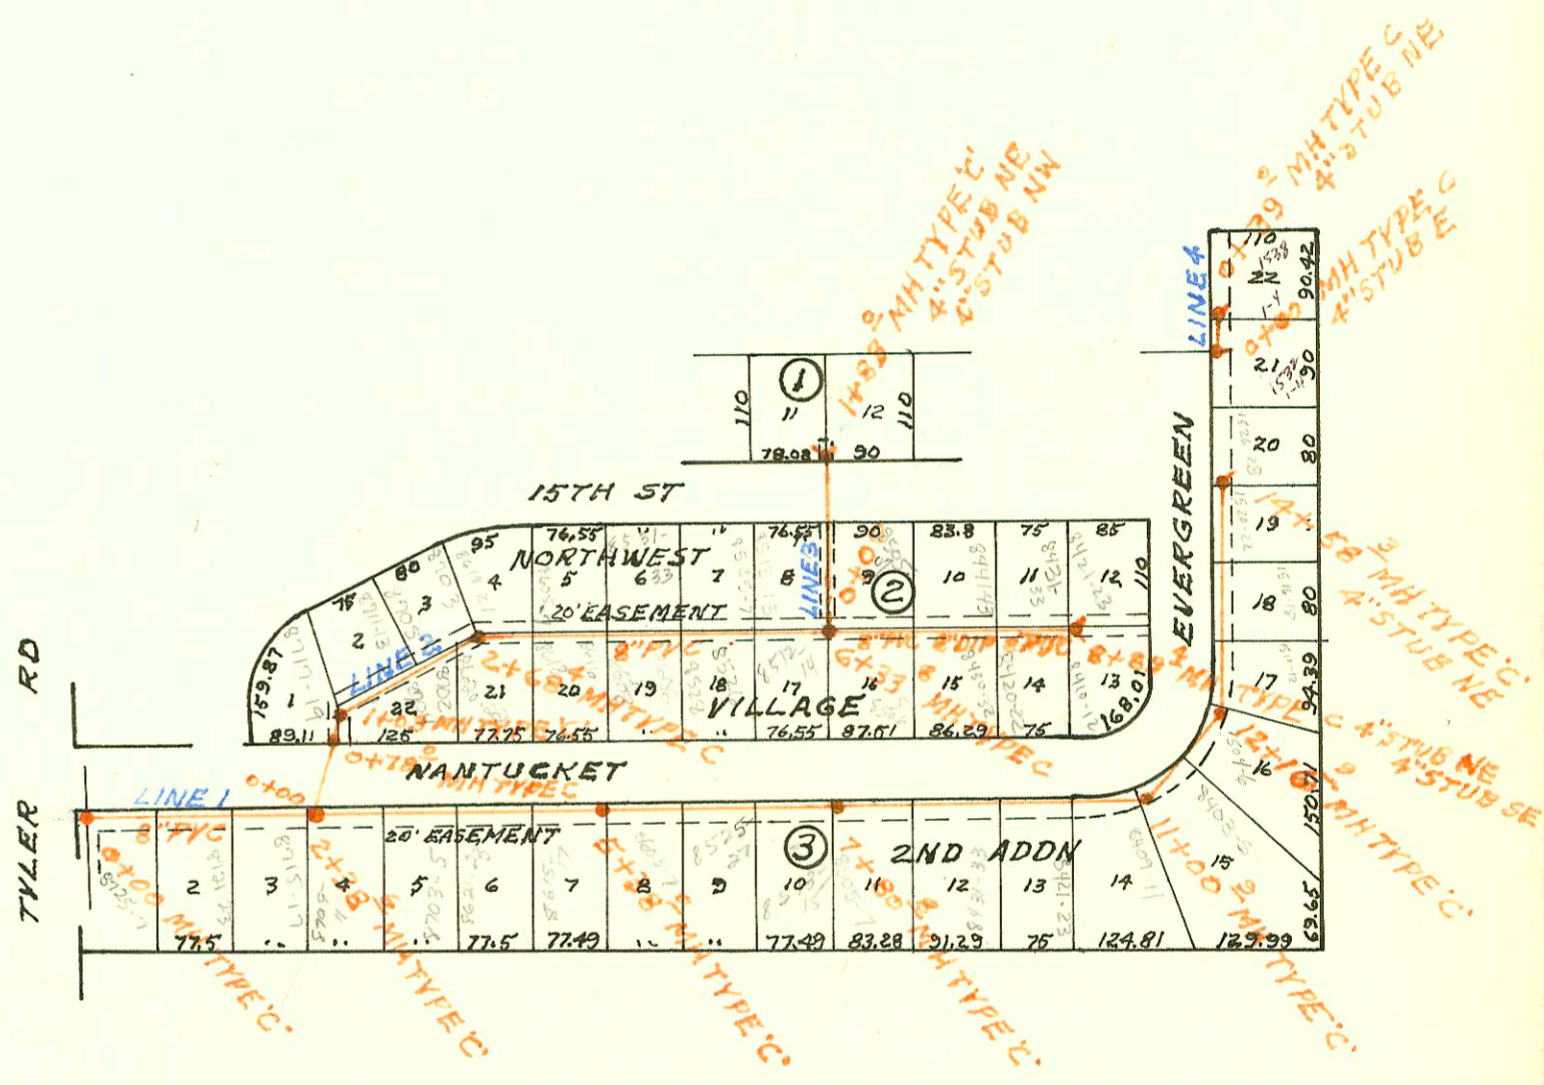

LATERAL 69 WESTLINK SEWER
 BUILT BY: CLEARWATER EXCAVATING CO.
 PROJ. NO 468-76-245-81119-000-000-001
 BOOKED 1-11-82 FROM DLK 449

DN map
 17-011

CONSTRUCTION RECORD

SERVICE RECORD

LAT
LINE 2
CONT'D

STATION	ELEVATION		Depth	MANHOLE	4-INCH "Y" BRANCHES		No. of Permit		House Number		DATE OF PERMITS	
	Ground	Grade			North West	South East	North West	South East	North West	South East	North West	South East
LAT 8 MAIN 9 SWI CONT'D												
6+00	141.1	129.71	11.4		351 W 4" F. PL 6+99.8		13574		10713-5 Leak 10723-2 Leak		4-25-85	
7+00	141.3	130.11	11.2				13577				4-26-85	
	141.6	130.36 130.46	11.2 11.1	7+63.3								
8+00	141.5	130.61	10.9									
9+00	142.5	131.01	11.5		8+50.3 8+58.3		8815		174-6 S Leak 166-8 Leak		7-25-83	
10+00	142.2	131.41	10.8									
	142.4	131.72 131.82	10.7 10.6	10+78.1	10+69.7	11+15.2	10930	11184	10736-8 Leak 10720-22 Leak	10720-22 Leak	5-15-84	6-13-84
11+00	142.5	131.91	10.6									
	142.6	132.14	10.5	11+57.2			95-48667		130-132 Leak		3-30-95	
	142.3	132.27	10.0	11+90.7	4" STUB N		11575	11188	122-24 Leak	10708-10 Leak	7-26-84	6-13-84
LATERAL 17 MAIN 20 WAR INDUSTRIES SEWER												
0+00	214.2	207.05	7.2	EXISTING				4681		2041 N Branch		11-16-81
	214.5	207.21 207.31	7.3 7.2	0+40.1	1+32.7	1+02.6	4689	4680	2021 N Branch	2021 N Branch	11-16-81	11-16-81
1+00	212.4	207.55	4.9		1+57.1	1+19.9	4688	4679	2021 N Branch	2021 N Branch	11-16-81	11-16-81
					1+72.9	1+35.6	4687	4678	2021 N Branch	2021 N Branch	11-16-81	11-16-81
					1+99.6	2+10.0	4686	4684	2021 N Branch	2021 N Branch	11-16-81	11-16-81
2+00	212.6	207.95	4.7			2+27.7		4683	2021 N Branch	2021 N Branch	11-16-81	11-16-81
	212.4	208.09	4.3	2+35.6		4" STUB E		4682	2021 N Branch	2021 N Branch	11-16-81	11-16-81
LINE 2	0+00	211.3	205.99	5.3	0+00	0+16.3		11488		2021 N Branch		7-17-84
	1+00	212.7	206.39	6.3								
		212.6	206.49	6.1	1+26.2	4" STUB NE						
LINE 3	0+00	212.0	204.59	7.4	0+00	0+45.5		4725		2021 N Branch		11-19-81
						0+70.0		4736		2021 N Branch		11-19-81
	1+00	214.8	207.32	7.5		0+88.0		4737		2021 N Branch		11-19-81
		212.0	207.46	4.5	1+05.0	4" STUB N	4" STUB S	4738		2021 N Branch		11-19-81
LATERAL 69 WESTLINK SEWER												
LINE 1	0+00	166.7	153.50	13.2	0+00							
						0+54.5		7810		8725-7 Nantucket		4-12-83
	1+00	165.2	153.80	11.4		1+23.0		7809		8721-23 Nantucket		4-12-83
						1+92.0		8171		8715-17 Nantucket		5-17-83
	2+00	165.6	154.10	11.5								
		165.9	154.22	11.7	2+38.6		2+67.5	5568		8709-11 Nantucket		4-8-82
	3+00	166.3	154.40	11.9			3+56.6	5567		8703-5 Nantucket		4-8-82
	4+00	166.7	154.70	12.0			4+31.2	5566		8625-23 Nantucket		4-8-82
	5+00	165.5	155.00	10.5			5+12.0	5565		8615-17 Nantucket		4-8-82
		164.9	155.11	9.8	5+38.0							
							5+90.2	7845		8605-7 Nantucket		4-14-83
	6+00	164.0	155.30	8.7			6+38.8	8631		8525-27 Nantucket		4-6-83
	7+00	162.7	155.60	7.1			7+42.0	8855		8513-15 Nantucket		7-29-83
		164.0	155.84	8.2	7+80.8							
	8+00	162.0	155.90	6.1			8+11.2	8180		8505-7 Nantucket		5-17-83
	9+00	162.2	156.20	6.0			9+15.3	5564		8421-32 Nantucket		4-9-82
							9+22.9	5068		8421-3 Nantucket		1-15-82
	10+00	162.2	156.50	5.7			10+67.9	4106		8401-11 Nantucket		9-10-81
	11+00	164.5	156.80 156.82	7.7 7.7	11+00.9		11+28.9	4107		8403-5 Nantucket		9-10-81
	12+00	163.3	157.12	6.3			12+11.9	4106		1501-15 Nantucket		9-16-81
		164.7	157.17 157.23	7.3 7.5	12+16.9		12+28.9	4109		1501-12 Nantucket		11-30-81
	13+00	163.2	157.48	5.7			13+71.3	4500		1516-18 Nantucket		11-30-81

4685-2021 N. Broadmoor (204) - 11-16-81 Dean & Jeffrey (42.8' Sgmt 1490.8)