



LATERAL 17 MAIN 2 SOUTHWEST INTERCEPTOR SEWER  
BUILT BY: W.B. CARTER CONST. CO.  
PROJ. NO 468-76-245-80619-000-000-001  
BOOKED 1-26-82 FROM DRH 16

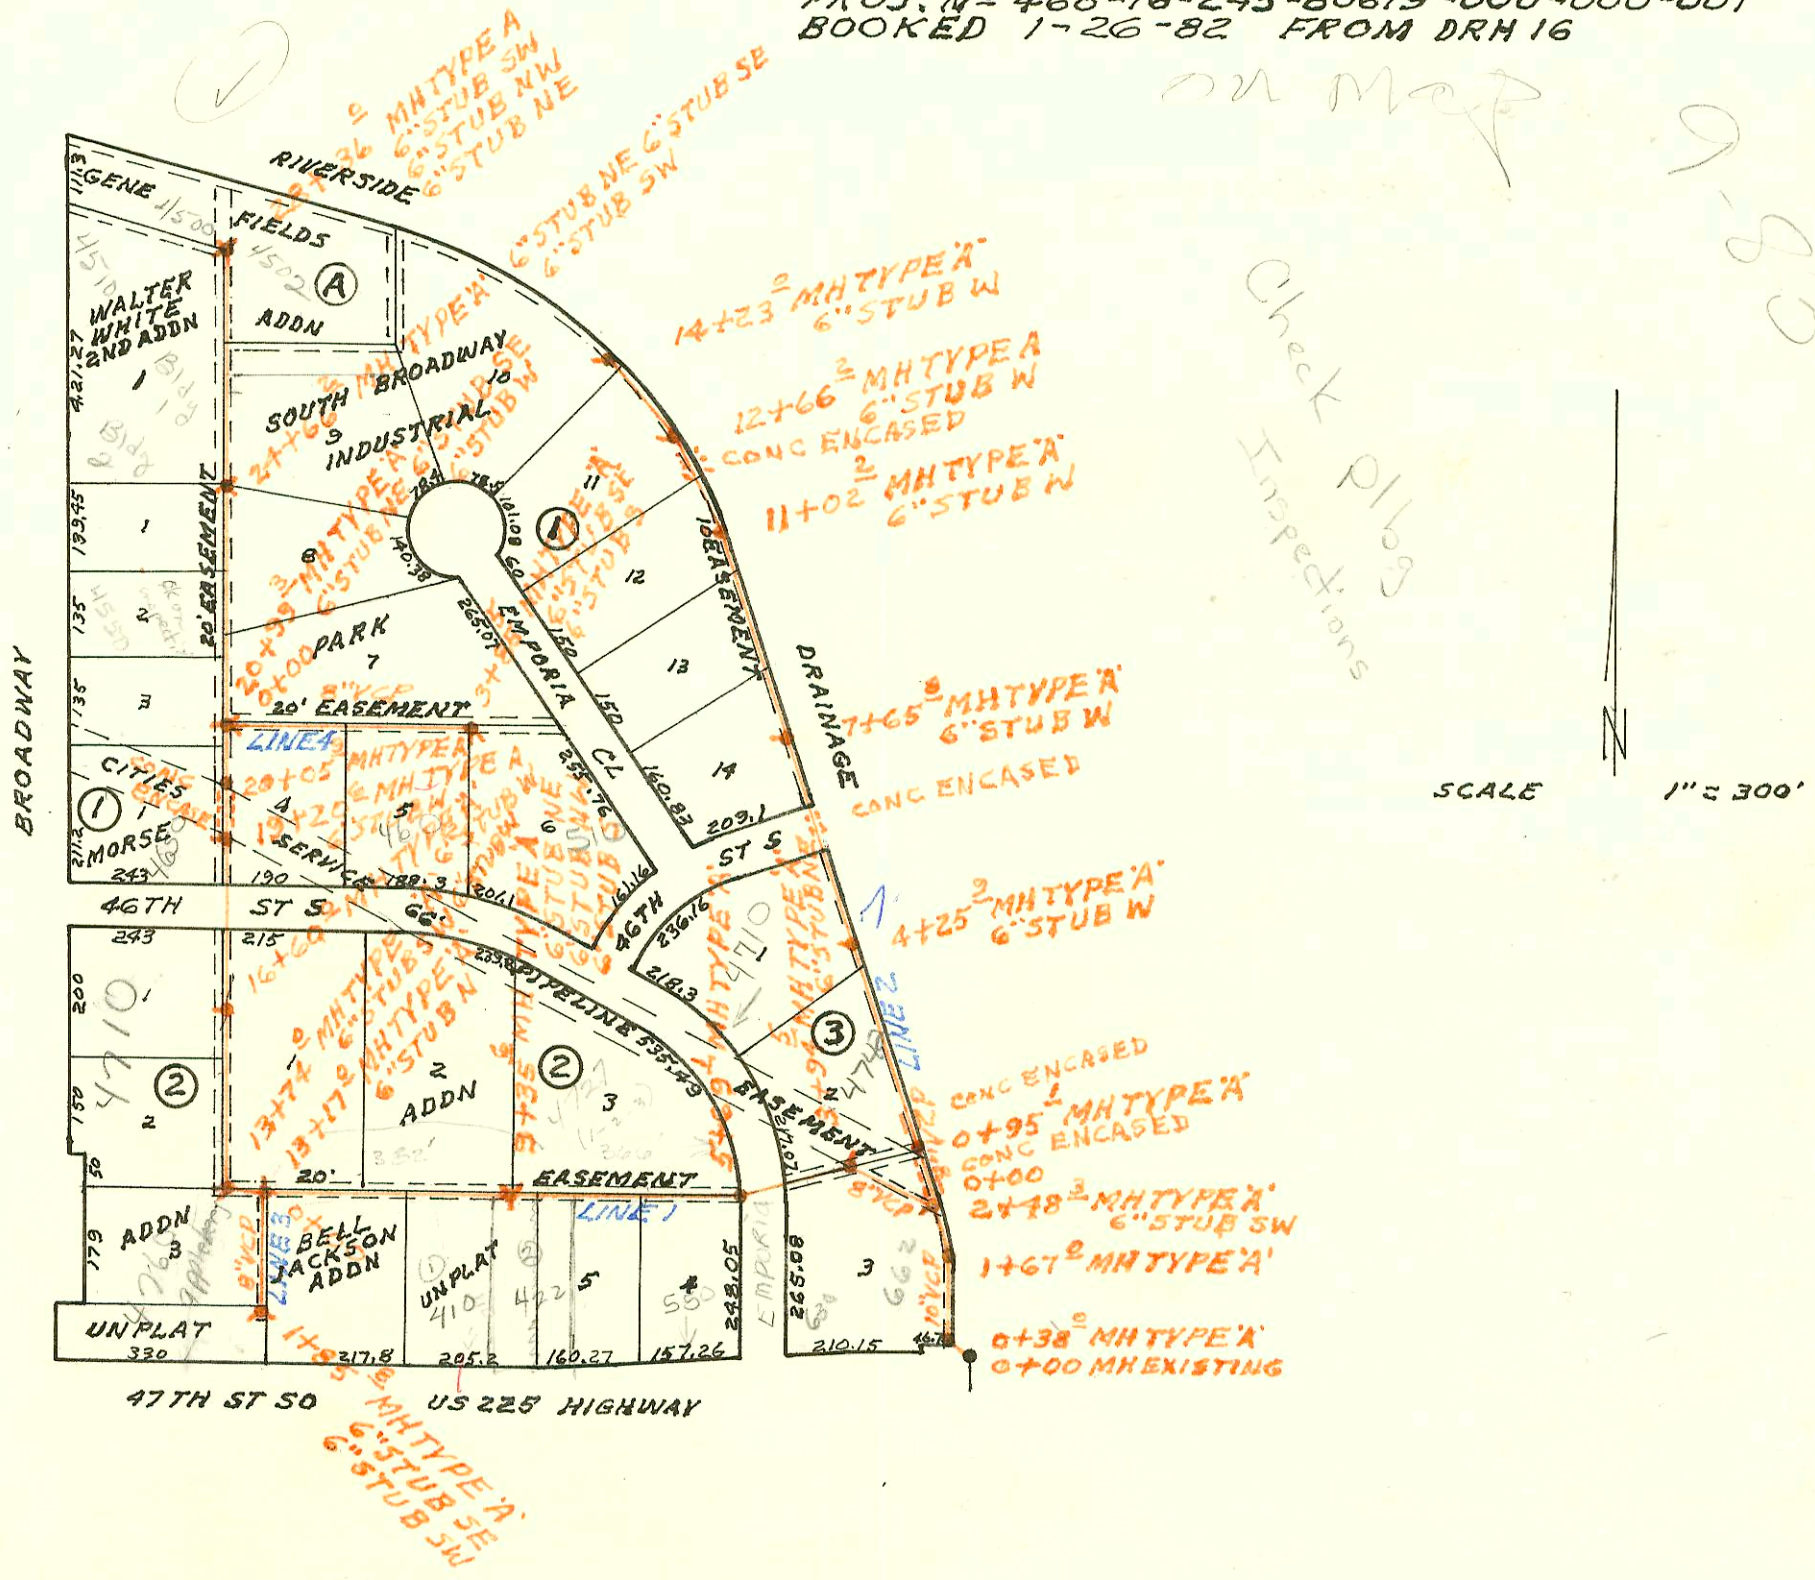

Check p16g  
Inspections

SCALE 1" = 300'

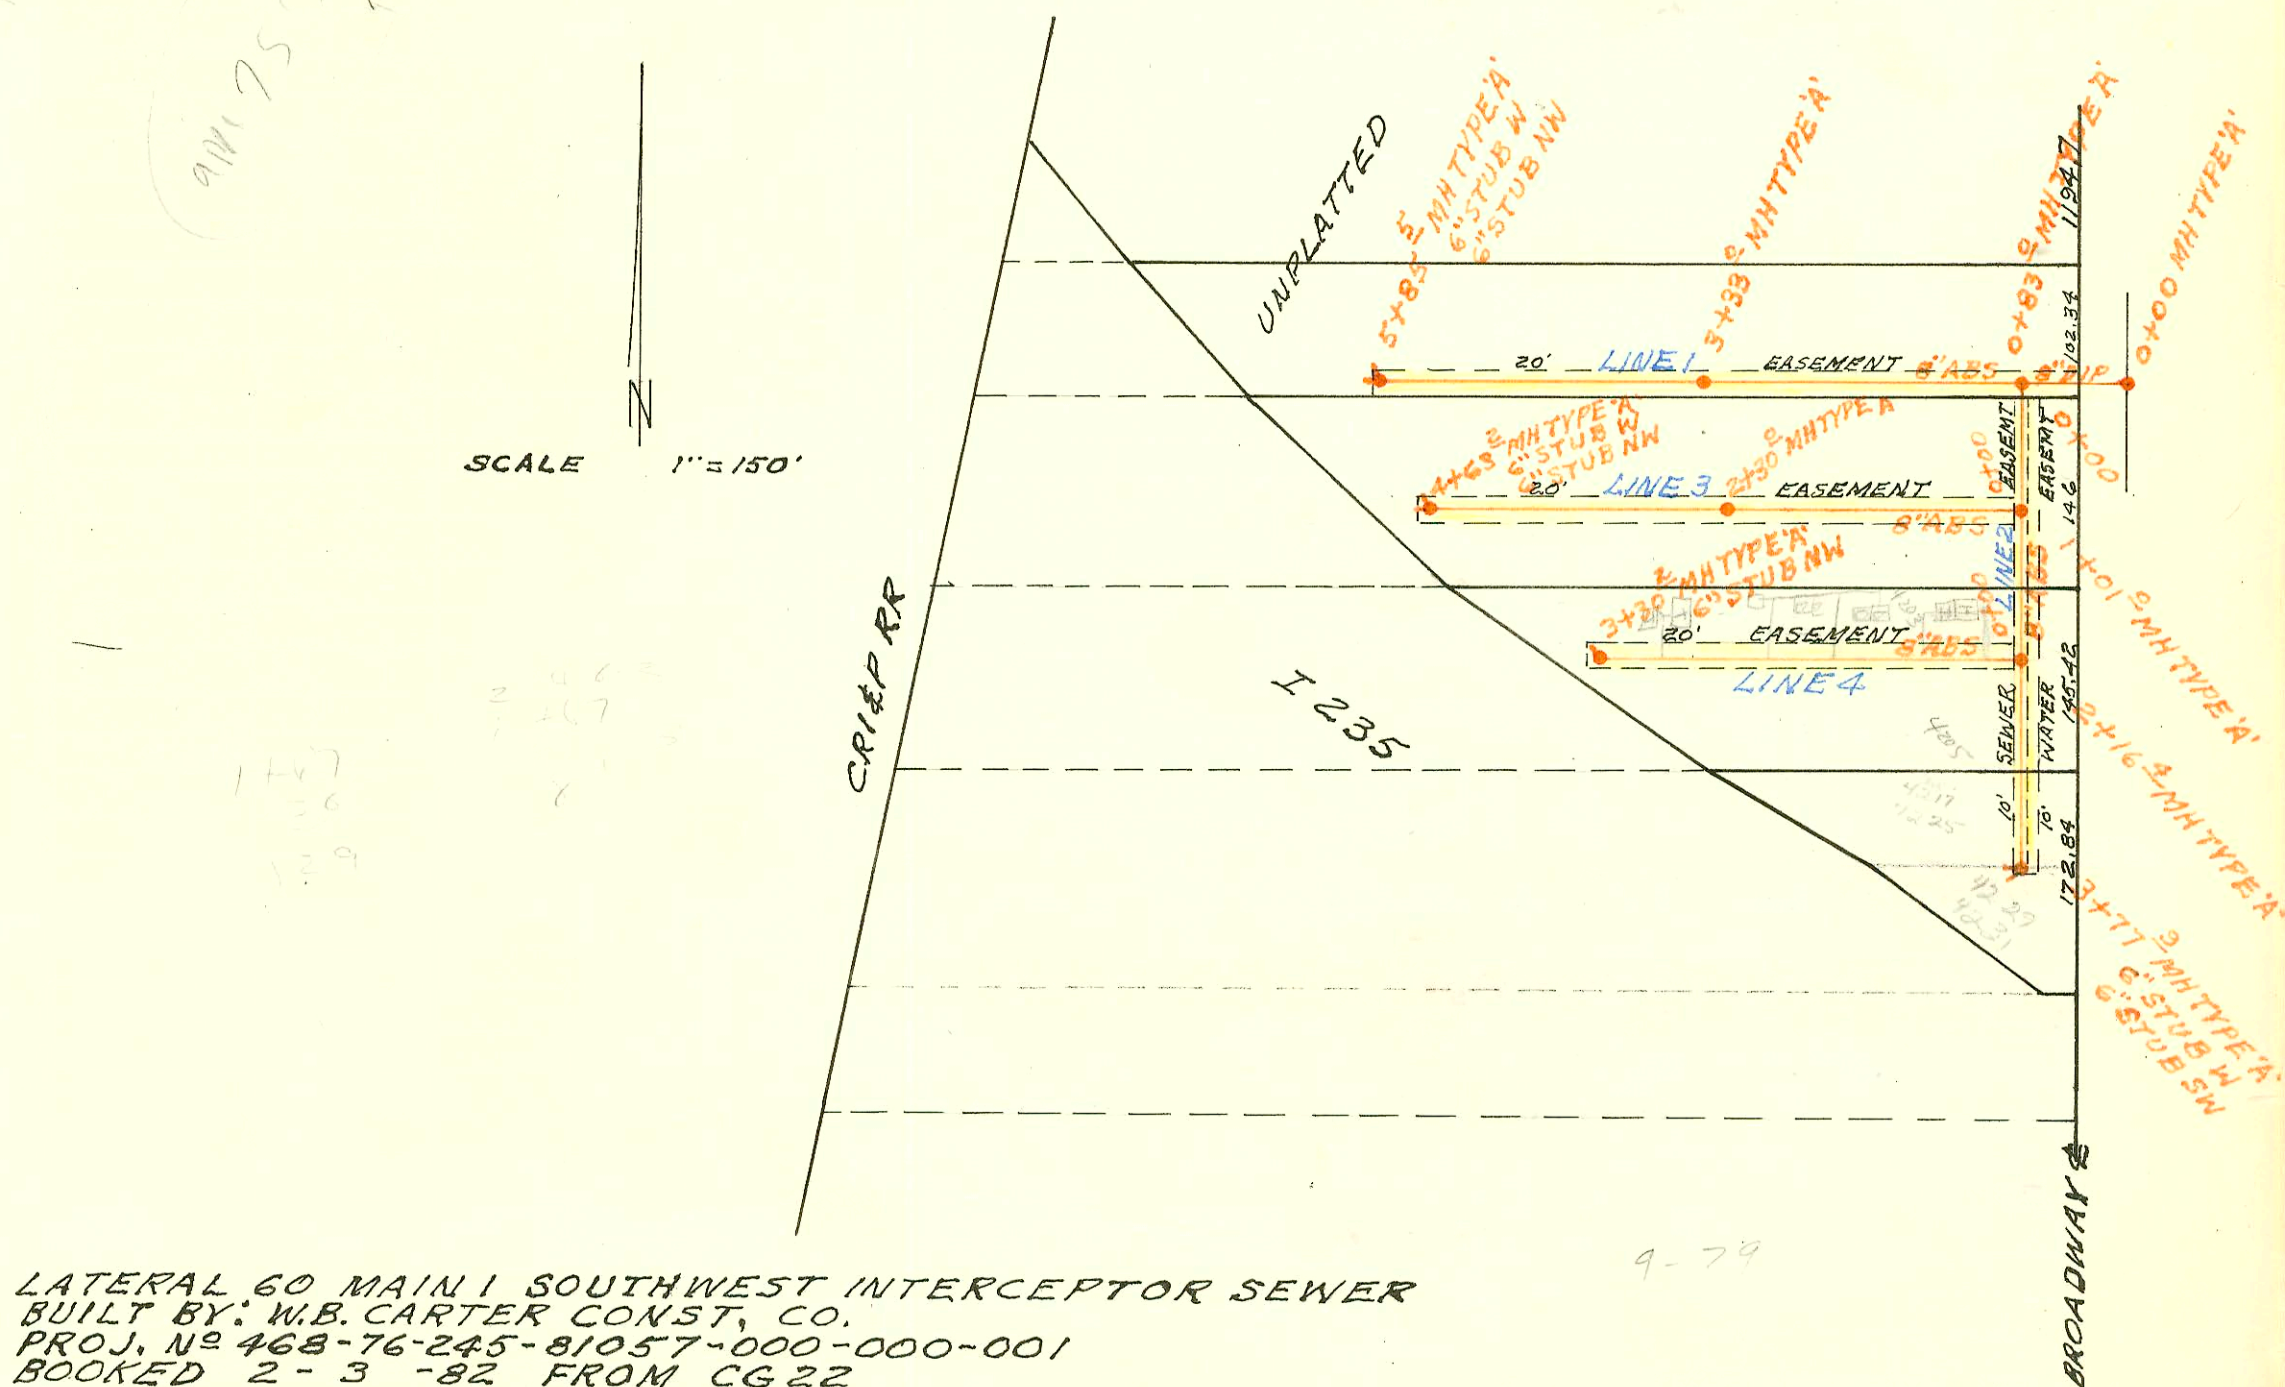

LATERAL 60 MAIN 1 SOUTHWEST INTERCEPTOR SEWER  
BUILT BY: W.B. CARTER CONST. CO.  
PROJ. NO 468-76-245-81057-000-000-001  
BOOKED 2-3-82 FROM CG 22

SCALE 1" = 150'

9-79

H272

CONSTRUCTION RECORD						SERVICE RECORD						
STATION	ELEVATION		Depth	MANHOLE	4-INCH "Y" BRANCHES		No. of Permit		House Number		DATE OF PERMITS	
	Ground	Grade			North West	South East	North West	South East	North West	South East	North West	South East
LAT LINE 2 CONT'D												
17 MAIN 2 SWI (CONT'D)												
7+00	82.2	74.48	7.7									
	82.3	74.61	7.7	7+65.8	6" STUB W							
8+00	82.3	74.68	7.6									
9+00	82.6	74.88	7.7									
10+00	82.3	75.08	7.2									
11+00	82.1	75.28	6.8									
	82.3	75.33	7.0	11+02.2	6" STUB W							
12+00	82.0	75.63	6.4	12+05	20' REINFC CONC ENCASED							
	81.5	75.82	5.7	12+66.2	6" STUB W							
13+00	81.6	75.98	5.6									
14+00	82.9	76.28	6.6									
	83.1	76.34	6.8	14+23.0	6" STUB W							
LINE 3												
0+00	85.0	74.86	10.1	0+00 = 13+17 LINE 1								
					6" SCH 40 S 20' BELOW 0+91 TAP		74-58457		4760 S Broadway		4-25-94	
1+00	84.3	75.26	9.0									
	84.3	75.60	8.7	1+85.8	6" STUB SW 6" STUB SE		174-77		4756 Broadway		12-10-86	
LINE 4												
0+00	84.0	76.10	7.9	0+00 = 20+29.3 LINE 1								
1+00	83.4	76.40	7.0									
2+00	82.7	76.70	6.0									
3+00	82.7	77.00	5.7									
	82.5	77.26	5.2	3+85.5	6" STUB SE 6" STUB S		9821407 2003-00368 1999-0289		460 = 46th 510 = 46th		11-9-98 2-11-02 8-6-77	
LATERAL 60 MAIN 1 SOUTHWEST INTERCEPTOR SEWER												
LINE 1												
0+00	87.7	82.65	5.1	0+00								
	86.8	82.73	4.1	0+83								
1+00	87.1	82.76	4.4									
2+00	87.3	82.91	4.4									
3+00	86.7	83.06	3.6									
	86.3	83.11	3.2	3+73.0								
4+00	86.4	83.21	3.2									
5+00	86.4	83.36	3.0									
	87.0	83.48	3.5	5+85.5	6" STUB NW 6" STUB W							
LINE 2												
0+00	86.8	82.83	4.0	0+00 = 0+83 LINE 1								
1+00	87.3	82.98	4.3	1+01.0								
2+00	87.6	83.13	4.5									
	87.1	83.15	4.0	2+16.4								
3+00	87.2	83.28	3.9									
	87.3	83.40	3.9	3+77.9	6" STUB SW 6" STUB W		5072		4231 S Broadway		1-15-82	
LINE 3												
0+00	87.3	83.08	4.2	0+00 = 1+01 LINE 2								
1+00	86.7	83.23	3.5									
2+00	86.2	83.38	2.8									
	85.7	83.43	2.3	2+30.0								
3+00	85.8	83.53	2.3									

Form #192-020 (July, 1981)

CONT'D NEXT PAGE

#94-58457-4-25-94-4760 S. Broadway = 4" PVC 40 AT STUB OUTS - 6" PVC 40 Lower 20', 6" City Tap - 9' South.