



HARRY

SCALE 1" = 150'

LATERAL 11 MAIN 19 WAR INDUSTRIES SEWER
BUILT BY: W.B. CARTER CONST. CO.
PROJ. N^o 468-76-245-80964-000-000-001
BOOKED 2-25-82 FROM LES 23

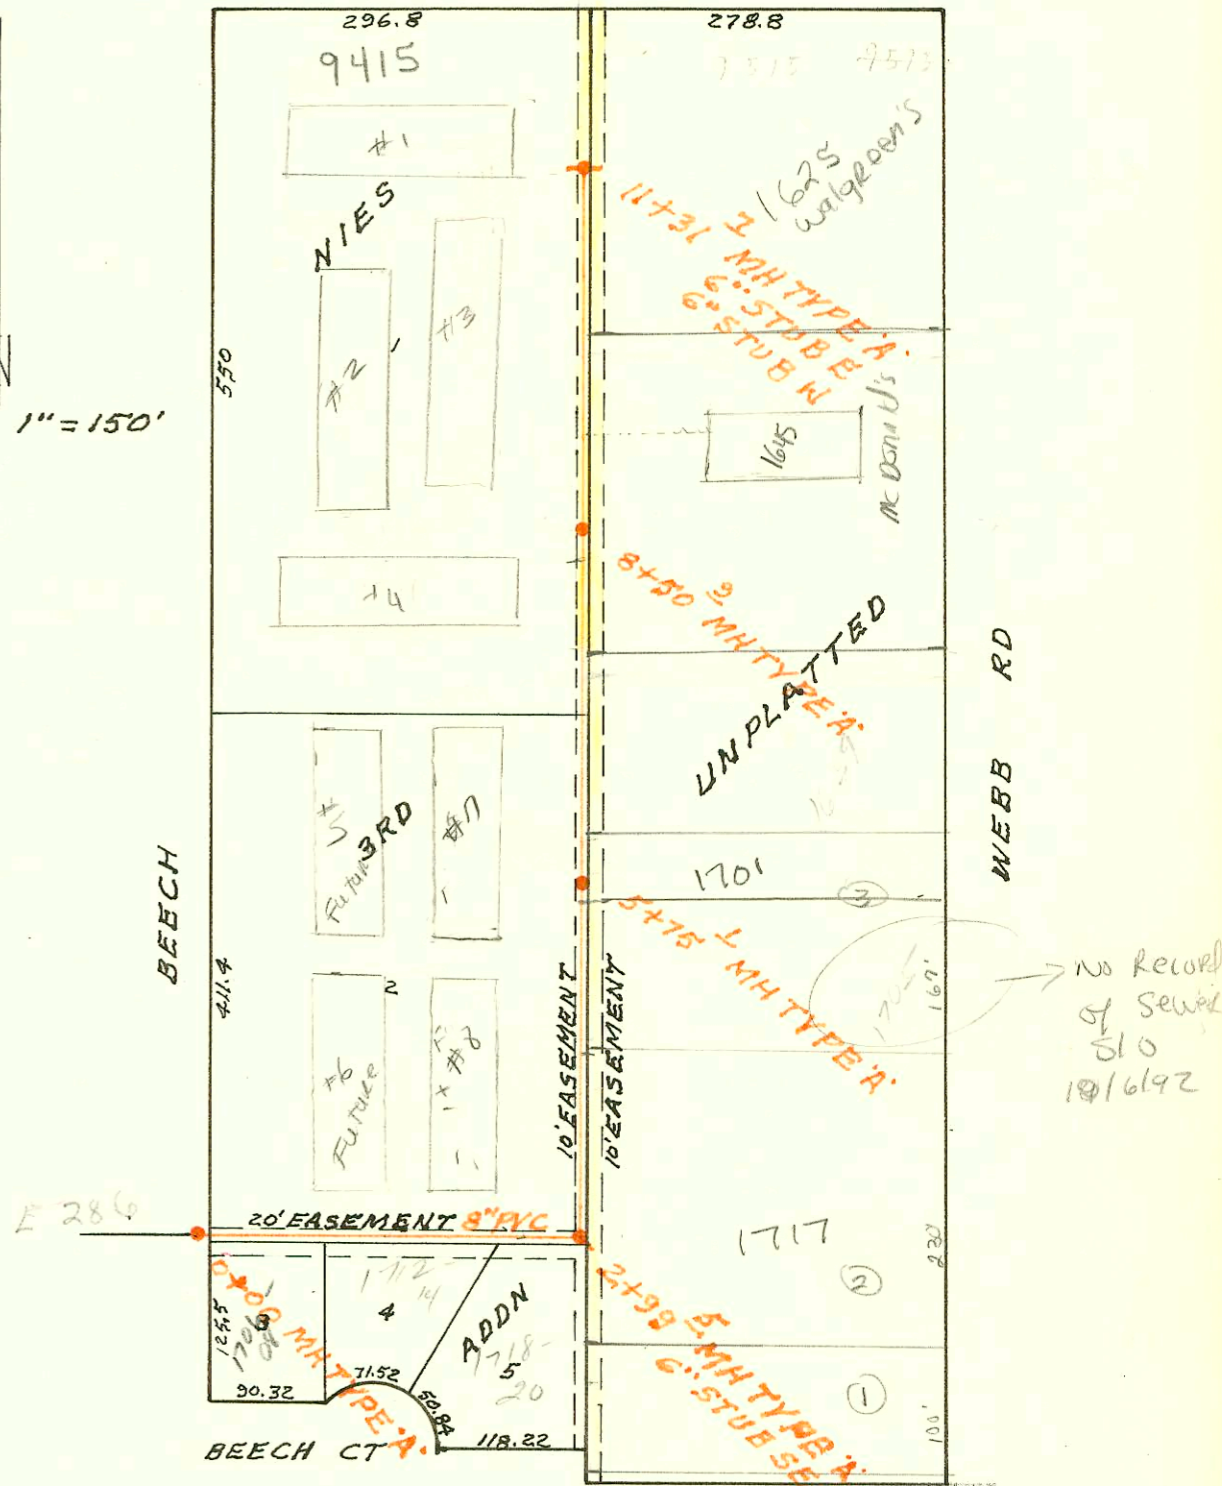

18-10/1

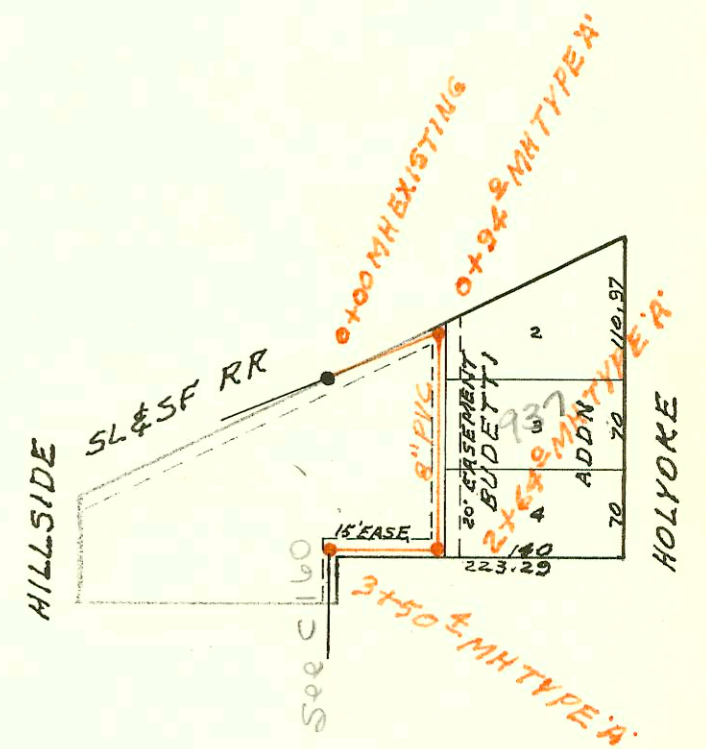

SCALE 1" = 150'

LATERAL 17 DIST. D SAN SEWER N^o 12
BUILT BY: W.B. CARTER CONST. CO.
PROJ. N^o 468-76-245-80994-000-000-001
BOOKED 2-26-82 FROM AG 13A

001 11/22/82

2-84-01

