



LATERAL 2 MAIN 9 SAN SEWER N^o 23
BUILT BY: W.B. CARTER CONST. CO.
PROJ. N^o 468-76-245-81125-000-000-001
BOOKED 3-3-82 FROM AG22

ON MAP

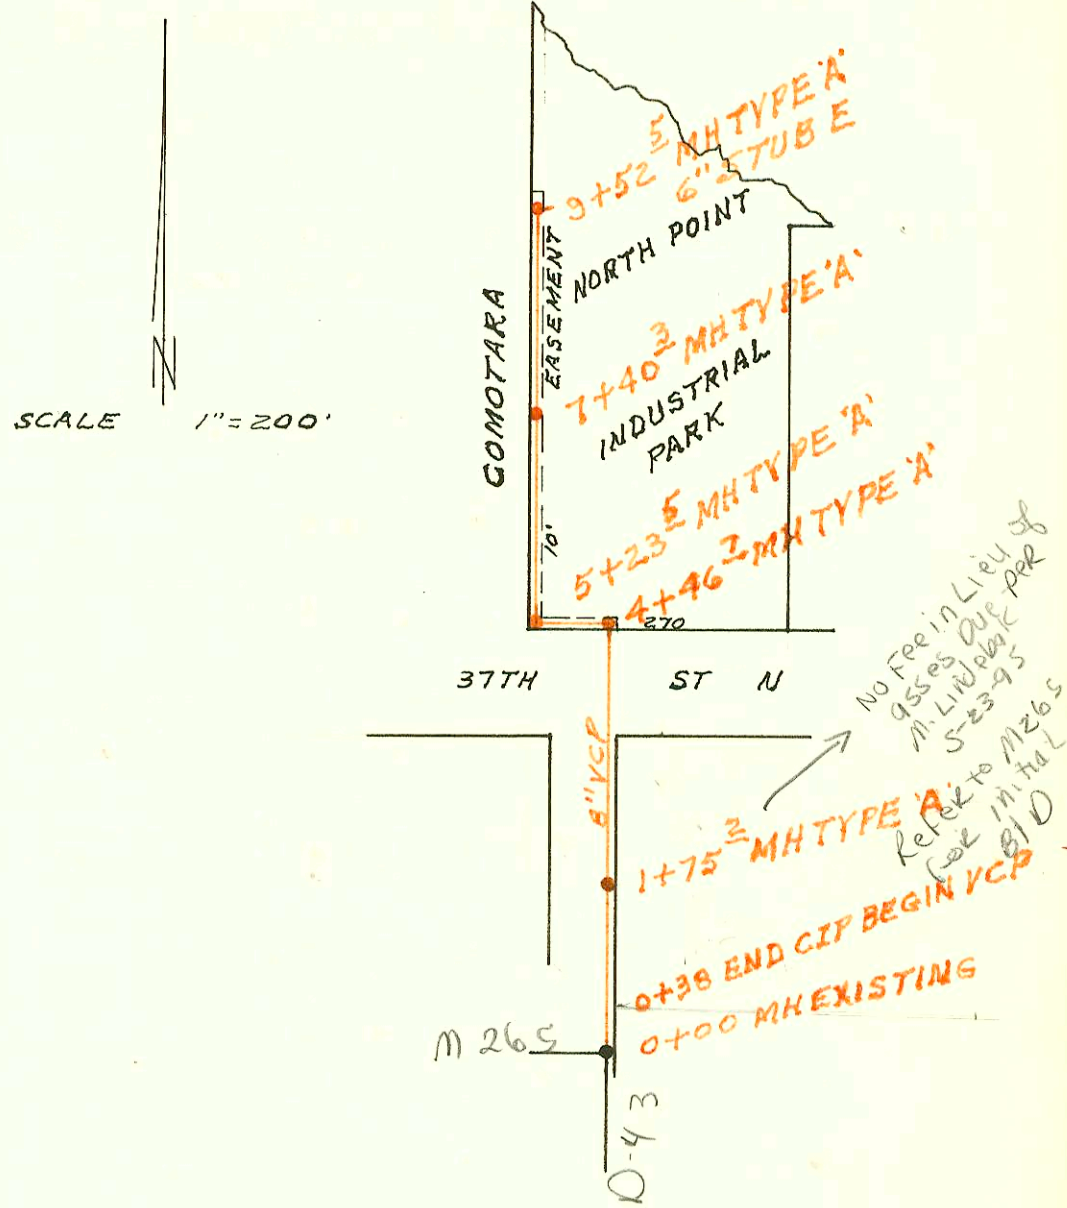


RECON PORTION SAN SEWER N^o 17
N OF THIRD BTW RIVERVIEW & WACO
PROJ. N^o 468-76-245-81151-000-000-001
BOOKED 3-4-82 FROM TCD 36

ON MAP 9-49

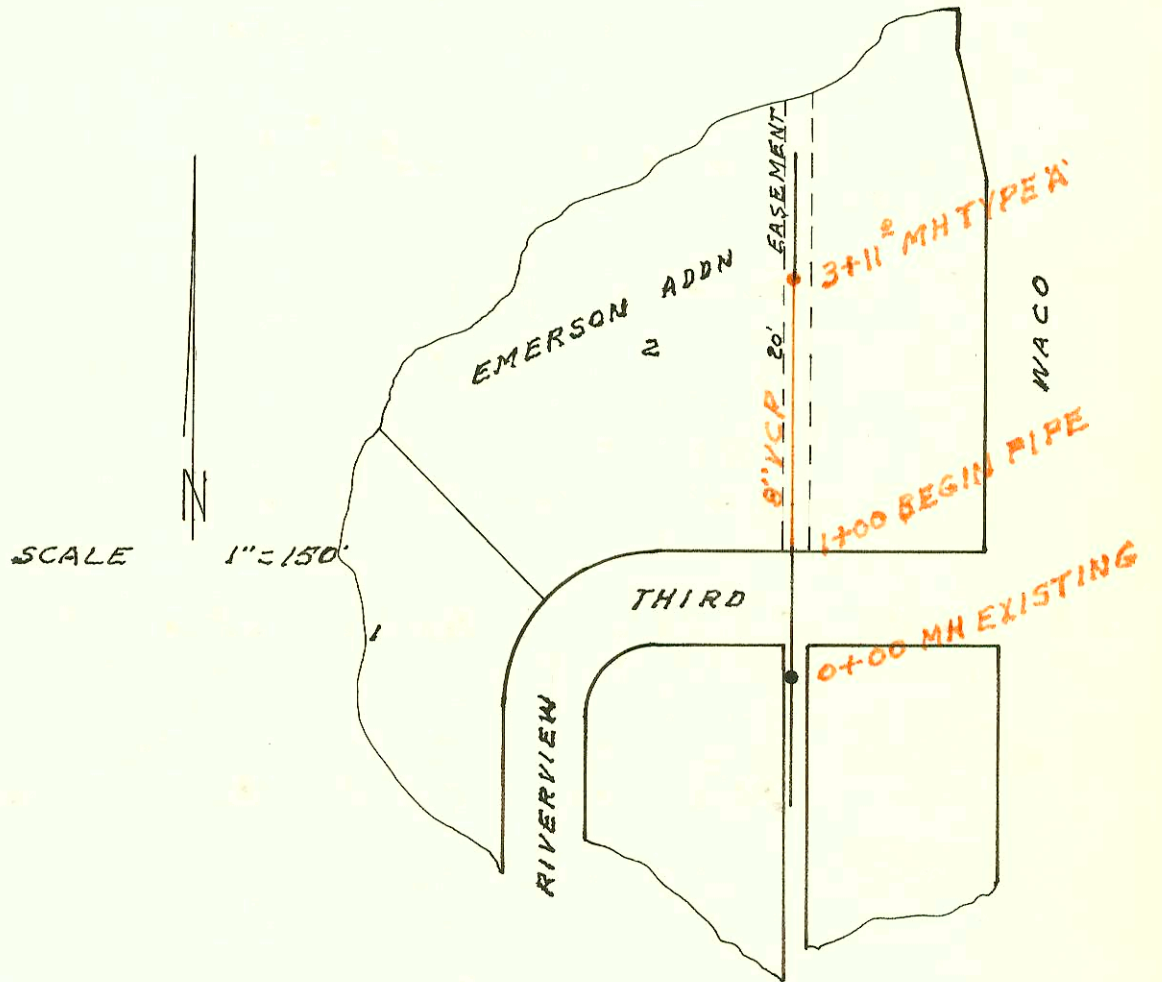

LATERAL 4 MAIN 6 SOUTHWEST INTERCEPTOR SEWER
BUILT BY: UTILITY CONTR. INC.
PROJ. N^o 468-76-245-80776-000-000-001
BOOKED 3-5-82 FROM 12D

ON MAP

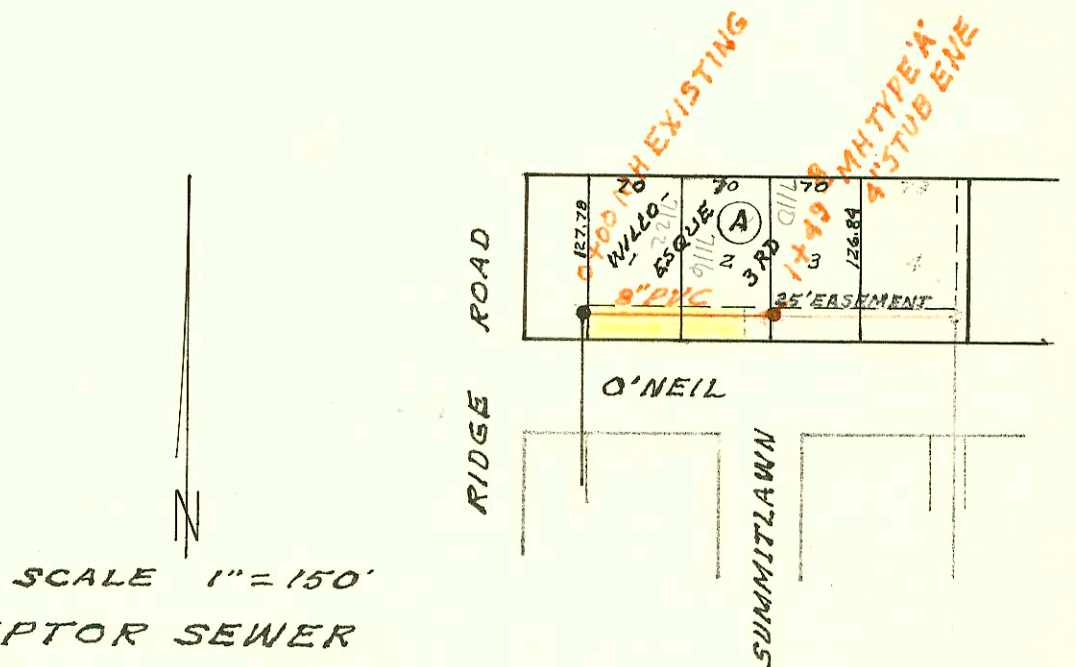

H278

CONSTRUCTION RECORD						SERVICE RECORD						
STATION	ELEVATION		Depth	MANHOLE	4-INCH "Y" BRANCHES		No. of Permit		House Number		DATE OF PERMITS	
	Ground	Grade			North West	South East	North West	South East	North West	South East	North West	South East
LATERAL 2 MAIN 9 SAN SEWER N ^o 23												
0+00	216.7	207.59	9.1	EXISTING								
0+38												
1+00	216.6	207.84	8.8									
	218.0	208.03	10.0	1+75.2								
2+00	217.9	208.09	9.8									
3+00	219.3	208.34	11.0									
4+00	221.0	208.59	12.4									
	221.0	208.71	12.3	4+46.7								
		208.81	12.2									
5+00	220.3	208.94	11.4									
	220.5	209.00	11.5	5+23.5								
		209.10	11.4									
6+00	218.7	209.29	9.4									
7+00	218.0	209.54	8.5									
	218.1	209.64	8.5	7+40.3								
8+00	216.8	209.79	7.0									
9+00	216.0	210.04	6.0									
	215.7	210.17	5.5	9+52.5	6" STUB E		4919		3900 Canata, Pa.		12-15-81	
RECON PORTION SAN SEWER N ^o 17 RIVERVIEW - WAGON OF THIRD												
0+00		107.80		EXISTING								
1+00	111.4	107.90	3.5									
2+00	112.0	108.00	4.0		2+04 W							
3+00	112.0	108.10	3.9									
	112.4	108.11	4.3	3+11.0								
LATERAL 4 MAIN 6 SOUTHWEST INTERCEPTOR SEWER												
0+00	144.5	139.13	5.4	EXISTING	0+23.0		2944		7182		3-26-81	
1+00	144.6	139.45	5.2		1+06.8		2943		7116		3-26-81	
	146.5	139.61	6.9	1+49.8	4" STUB E		2942		7110 O'Neil		3-26-81	
11592 See Bill Jan 1982 137 n. Wagon 8-27-85 - At Harding - 3+11.0 N												