



SANITARY SEWER FOR CESSNA - WALLACE
BUILT BY: (PVT)
PROJ. N^o 468-76-245-80000-000-000-008
BOOKED 3-15-82 FROM

on map

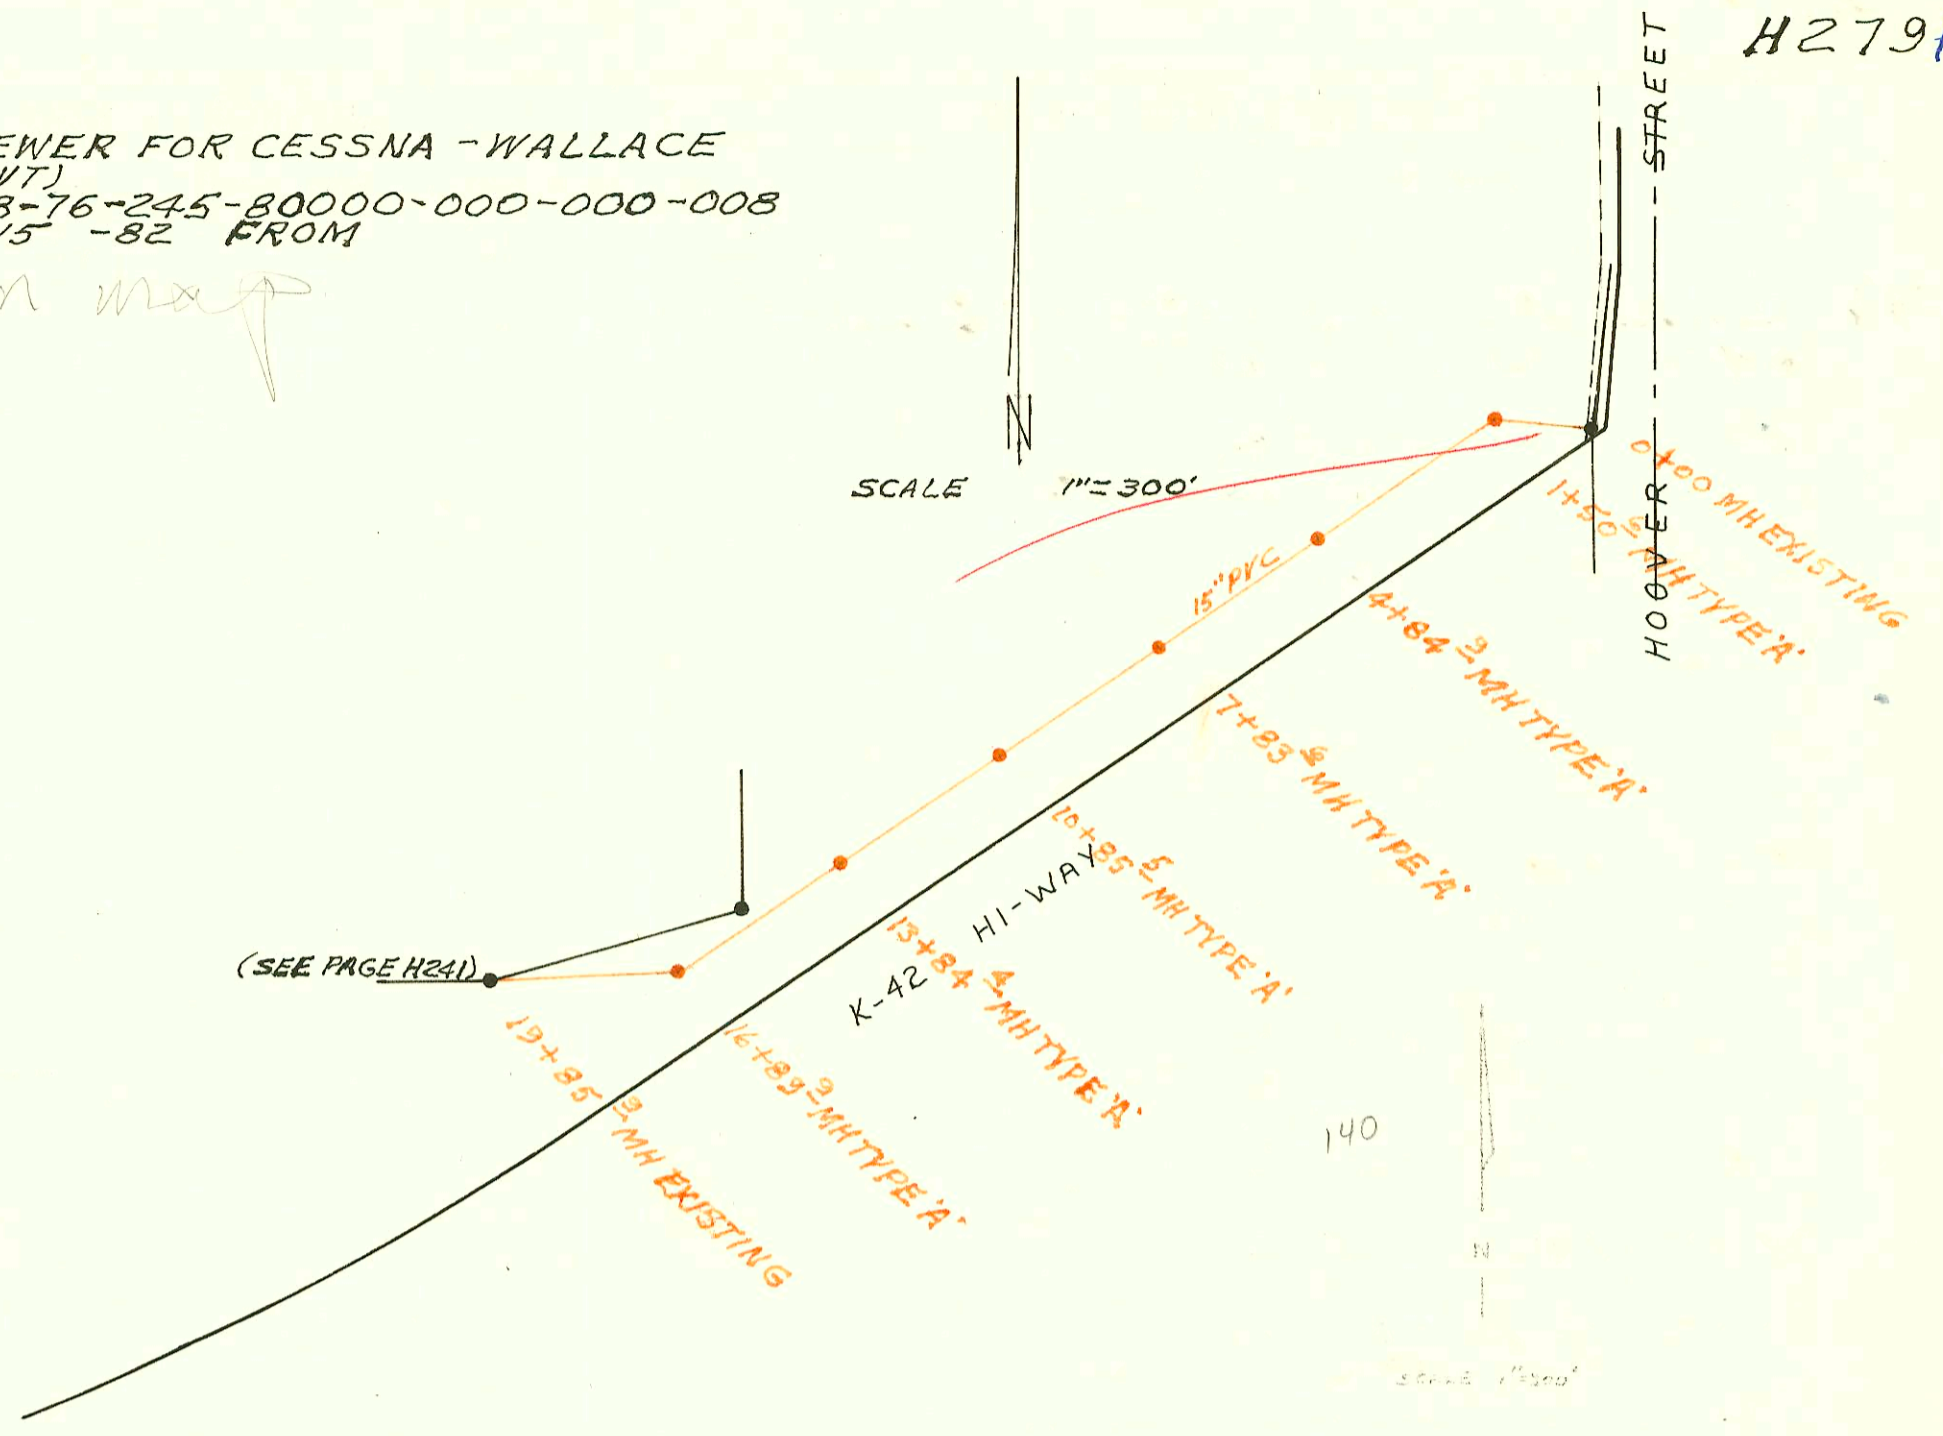


SANITARY SEWER FOR PRECISION PATTERN
BUILT BY: (PVT) W.B. CARTER CONST. CO.
PROJ. N^o 468-76-245-80000-000-000-008
BOOKED 3-15-82 FROM BR 42

on map

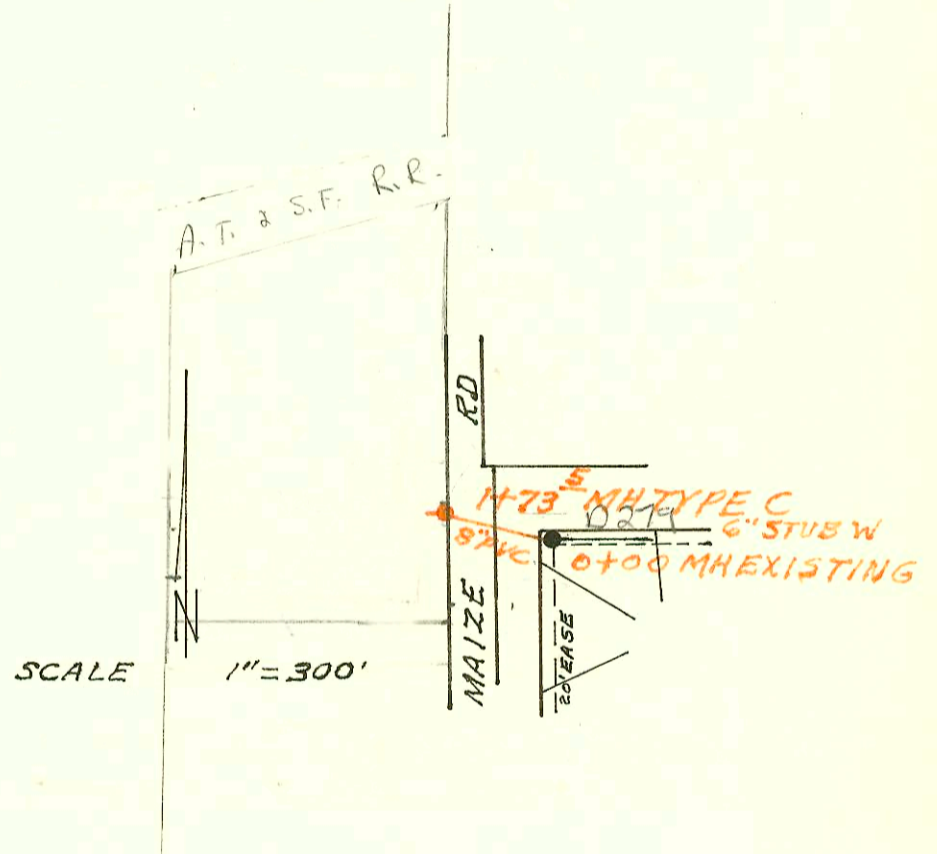

SANITARY SEWER FOR ROANN ADDN
BUILT BY: (PVT) MID STATES CONST. CO.
PROJ. N^o 468-76-245-80000-000-000-008
BOOKED 3-16-82 FROM DCD 161

on map

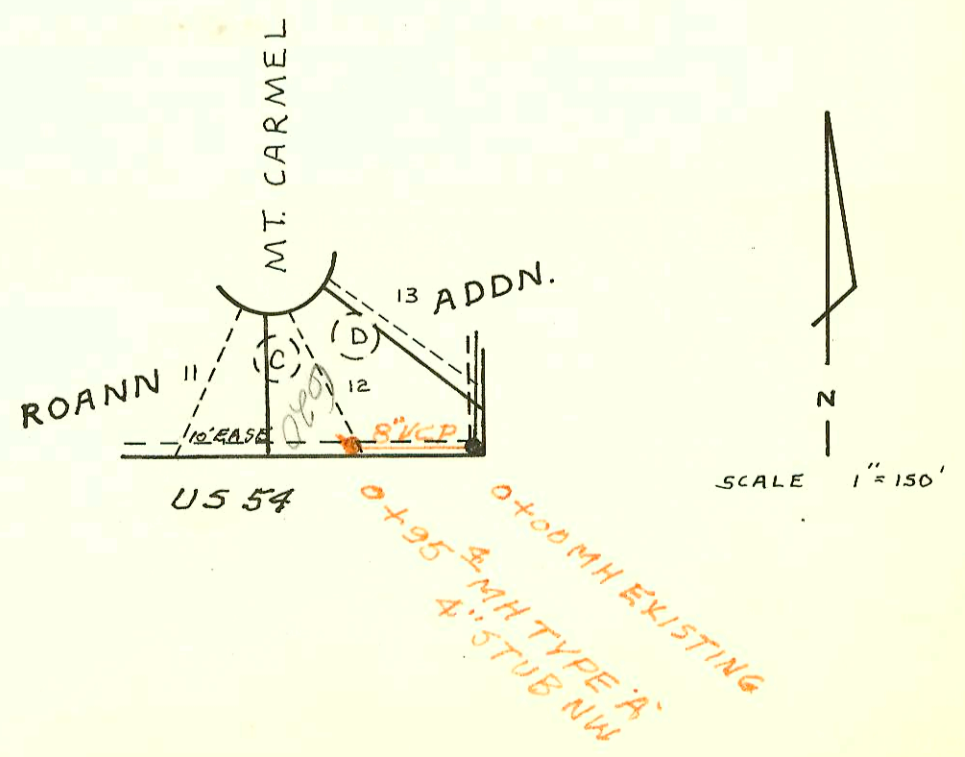

CONSTRUCTION RECORD						SERVICE RECORD						
STATION	ELEVATION		Depth	MANHOLE	4-INCH "Y" BRANCHES		No. of Permit		House Number		DATE OF PERMITS	
	Ground	Grade			North West	South East	North West	South East	North West	South East	North West	South East
SAN SEWER FOR CESSNA - WALLACE												
0+00	108.8	94.94 104.74	13.9 4.1	0+00 EXISTING								
1+00	109.6	104.92	4.7									
	109.2	105.00 105.10	4.2 4.1	1+50.6								
2+00	108.8	105.17	3.6									
3+00	108.9	105.32	3.6									
4+00	109.0	105.47	3.5									
	109.3	105.60 105.70	3.7 3.6	4+84.9								
5+00	109.3	105.72	3.6									
6+00	109.3	105.87	3.4									
7+00	109.5	106.02	3.5									
	109.4	106.15 106.25	3.3 3.2	7+83.6								
8+00	109.5	106.27	3.2									
9+00	109.5	106.42	3.1									
10+00	109.4	106.57	2.8									
	109.7	106.70 106.80	3.0 2.9	10+85.5								
11+00	109.7	106.82	2.9									
12+00	110.0	106.97	3.0									
13+00	110.2	107.12	3.1									
	109.7	107.25 107.35	2.5 2.4	13+84.4								
14+00	109.7	107.37	2.3									
15+00	110.0	107.52	2.5									
16+00	110.7	107.67	3.0									
	110.8	107.81 107.91	3.0 2.9	16+89.9								
17+00	110.0	107.92	2.1									
18+00	111.3	108.07	3.2									
19+00	111.8	108.22	3.6									
	113.0	108.35	4.7	19+85.9								
SAN SEWER FOR PRECISION PATTERN												
0+00	136.2	125.00	11.2	0+00 EXISTING								
1+00	136.5	126.20	10.3									
	137.0	127.08	9.9	1+73.5	6" STUB W		2948		1043 8" 1042		3-26-81	
SAN SEWER FOR ROANN ADDN												
0+00	111.7	104.60	7.1	0+00 EXISTING	0+33.76		1284		620 5" m/camp		9-17-80	
	111.9	107.00	4.9	0+95.4	4" STUB NW							

Special
req'd.